

39° 20' 00"

Latitude ✓

80° 37' 30"

Longitude

was: 70029

Topo Location

7.5' Loc. 1.805 15' Loc. 1.805  
2.12W (calc.) 4.35W

Company Quaker State Corp.  
Farm H. L. Chelton #1  
15' Quad Center Point (sc)  
(sec.)  
7.5' Quad Smithburg  
District Grant

WELL LOCATION PLAT

County 017 Permit 4109N

H. L. CHADISTER NO. 1 WELL.

70029 → 4109

Grant District, Doddridge County, W. Va.

By .....

J. C. Treiner, Contractor.

Location .....

Drilling commenced March 1907; completed April 27, 1908.

10" casing, 195' 6" (171' 8" pulled); 8", 1082' (499' 3" pulled);

6", 1917'; 3" tubing, 1900'.

Bottom hole packer on 6" casing.


Record in Western Petroleum Co. Well Record book of Clifton Oil & Gas Co.

	Top.	Bottom.
Native coal	80	..
Pittsburgh Coal	538	..
Gas Sand	1184	1234
First Salt Sand	1314	1339
Second Salt Sand (10 boilers of water per hour)	1393	1462
Third Salt Sand (gas, 1600')	1467	1640
Maxton Sand (gas, 1710')	1710	..
Little Lane	1785	1800
Fennell Cove	1800	1818
Big Lane	1818	1888
Big Injun Sand (shall) (gas, 1990-1900')	.....	.....
Total depth	.....	1926



INSTRUCTIONS

- 1) Attach a photo copy of the location of the well on a 7.5 minute Quadrangle with the corresponding Longitude and Latitude.
- 2) Designate the location of the well with the symbol(+).

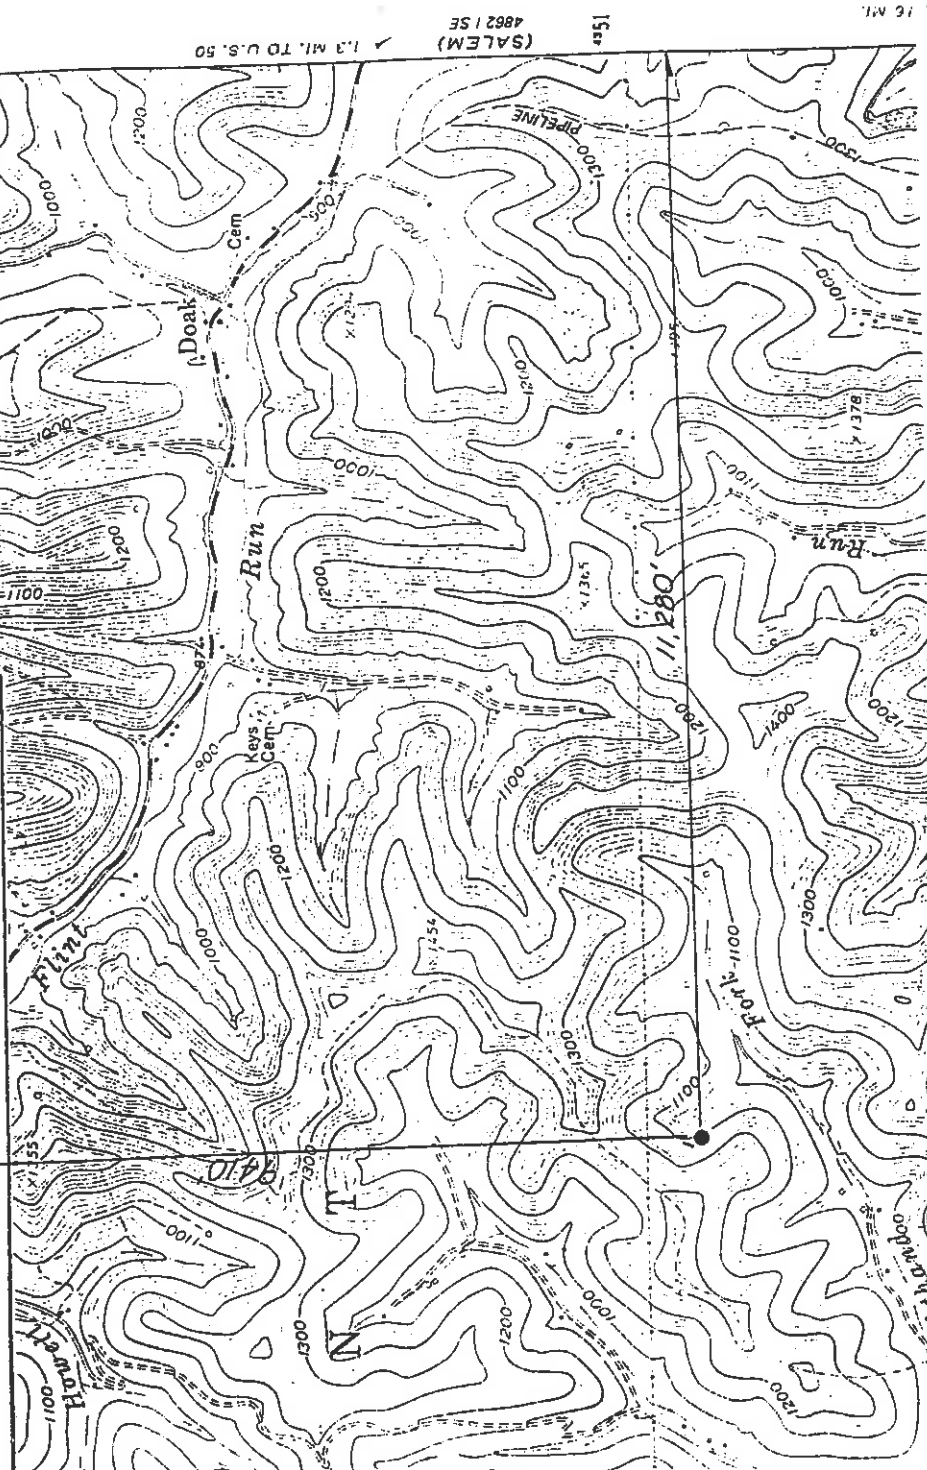

I, the undersigned, Hereby certify that this plat is correct to the best of my knowledge and belief.

SIGNED Quaker State


TITLE District Manager

18490

DATE December 1, 1993

OPERATORS WELL NO. Chedister #1

API WELL NO. 017-1109-N

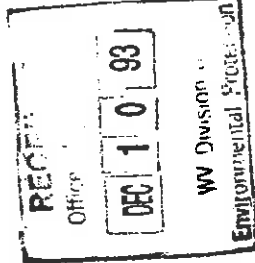

STATE OF WEST VIRGINIA  
DEPARTMENT OF ENERGY  
OIL AND GAS DIVISION

WELL TYPE: OIL  GAS  LIQUID INJECTION  WASTE DISPOSAL   
(I.E. "GAS" PRODUCTION STORAGE  DEEP  SHALLOW

LOCATION: ELEVATION 1120' WATER SHED Righthand Fork of Morgans Run  
DISTRICT Grant COUNTY Doddridge  
QUADRANGLE Smithburg

SURFACE OWNER H. L. Chedister ACREAGE 64

OIL & GAS ROYALTY OWNER N/A LEASE ACREAGE           
LEASE NO.         

PRODUCING FORMATION Big Injun Sand TOTAL DEPTH 1926'

WELL OPERATOR Quaker State Corporation DESIGNATED AGENT Frank Rotunda

ADDRESS 1226 Putnam Howe Drive ADDRESS P.O. Box 823  
Belpre, OH 45714 Parkersburg, WV 26102



STATE OF WEST VIRGINIA  
DIVISION OF ENVIRONMENTAL PROTECTION  
SECTION OF OIL AND GAS

WELL REGISTER ASSIGNMENT

This API Number 47- 17-04109, issued to QUAKER STATE CORPORATION is evidence of permission to operate the well that is referenced at the location described on the attached plat, subject to the provisions of Chapters 22 and 22B of the West Virginia Code of 1931, as amended, and all rules and regulations promulgated thereunder. The name and telephone number of the Oil and Gas Inspector for this well is MIKE UNDERWOOD -  
304-782-1043.

Spills or emergency discharges must be reported to 1-800-654-3312.

Failure to abide by all statutory and regulatory provisions governing all duties and operations hereunder may result in suspension or revocation of your permits and in addition may result in civil and/or criminal penalties.

The enclosed WR-35 must be completed by you and returned to this office. In addition annual production reports must be submitted on this well and failure to do so may require you to plug the well.

Theodore M. Streit  
Chief

By: 

Title: \_\_\_\_\_

Operator's Well No: CHEDISTER #1

Farm Name: CHEDISTER, H.L.

API Well Number : 47- 17-04109 N

Date Issued : 03/10/94

