

WW-7
8-30-06



West Virginia Department of Environmental Protection
Office of Oil and Gas
WELL LOCATION FORM: GPS

API: 47-017-04466 WELL NO.: Randolph #1
FARM NAME: Keplinger, Dale & Melissa
RESPONSIBLE PARTY NAME: EXCO Resources (PA), LLC
COUNTY: Doddridge DISTRICT: New Milton
QUADRANGLE: New Milton
SURFACE OWNER: Dale & Melissa Keplinger
ROYALTY OWNER: _____
UTM GPS NORTHING: 4342842.4 m
UTM GPS EASTING: 526737.9 m GPS ELEVATION: 1105 ft

The Responsible Party named above has chosen to submit GPS coordinates in lieu of preparing a new well location plat for a plugging permit or assigned API number on the above well. The Office of Oil and Gas will not accept GPS coordinates that do not meet the following requirements:

1. Datum: NAD 1983, Zone: 17 North, Coordinate Units: meters, Altitude: height above mean sea level (MSL) – meters.
2. Accuracy to Datum – 3.05 meters
3. Data Collection Method:
Survey grade GPS ____: Post Processed Differential ____


Real-Time Differential ____

Mapping Grade GPS X: Post Processed Differential ____

Real-Time Differential X



4. Letter size copy of the topography map showing the well location.

I the undersigned, hereby certify this data is correct to the best of my knowledge and belief and shows all the information required by law and the regulations issued and prescribed by the Office of Oil and Gas.

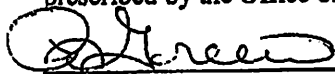
Signature

Construction Specialist I
Title

2-20-13
Date

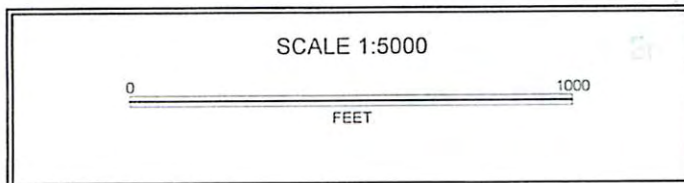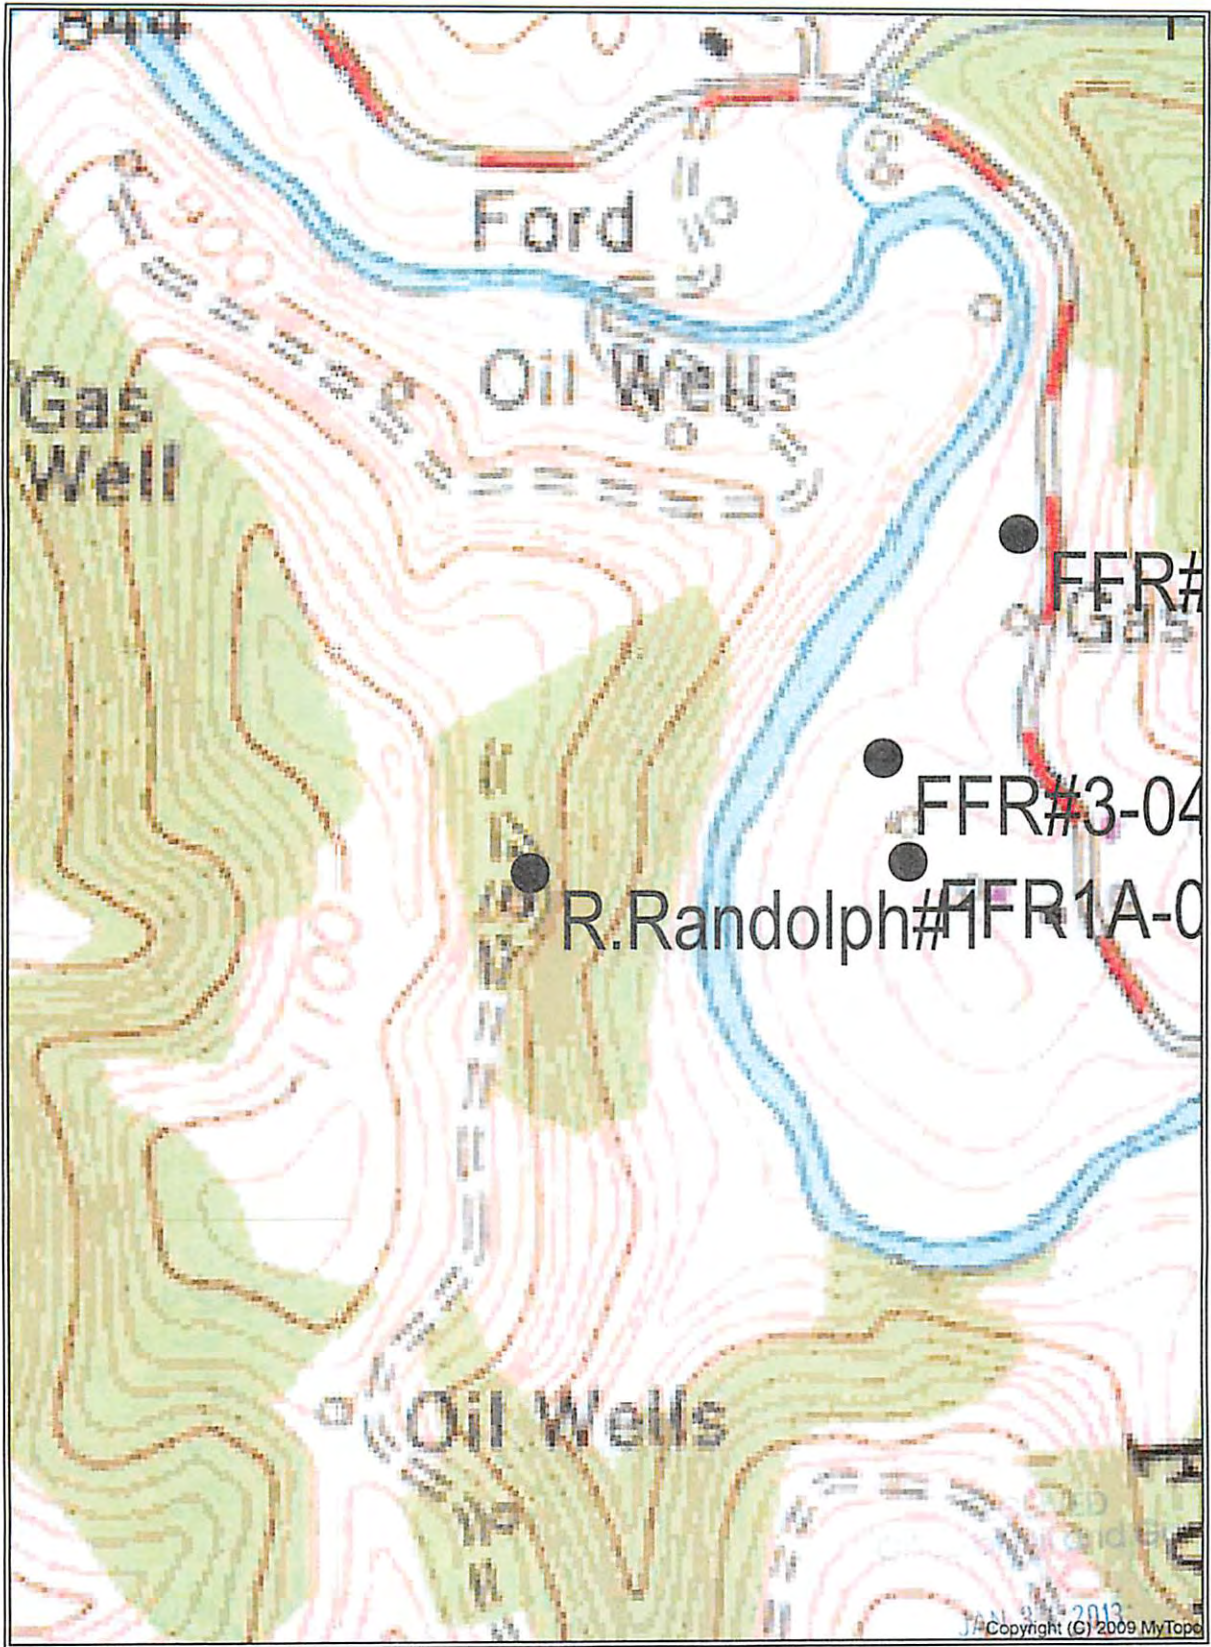

Department of
Environmental Protec