

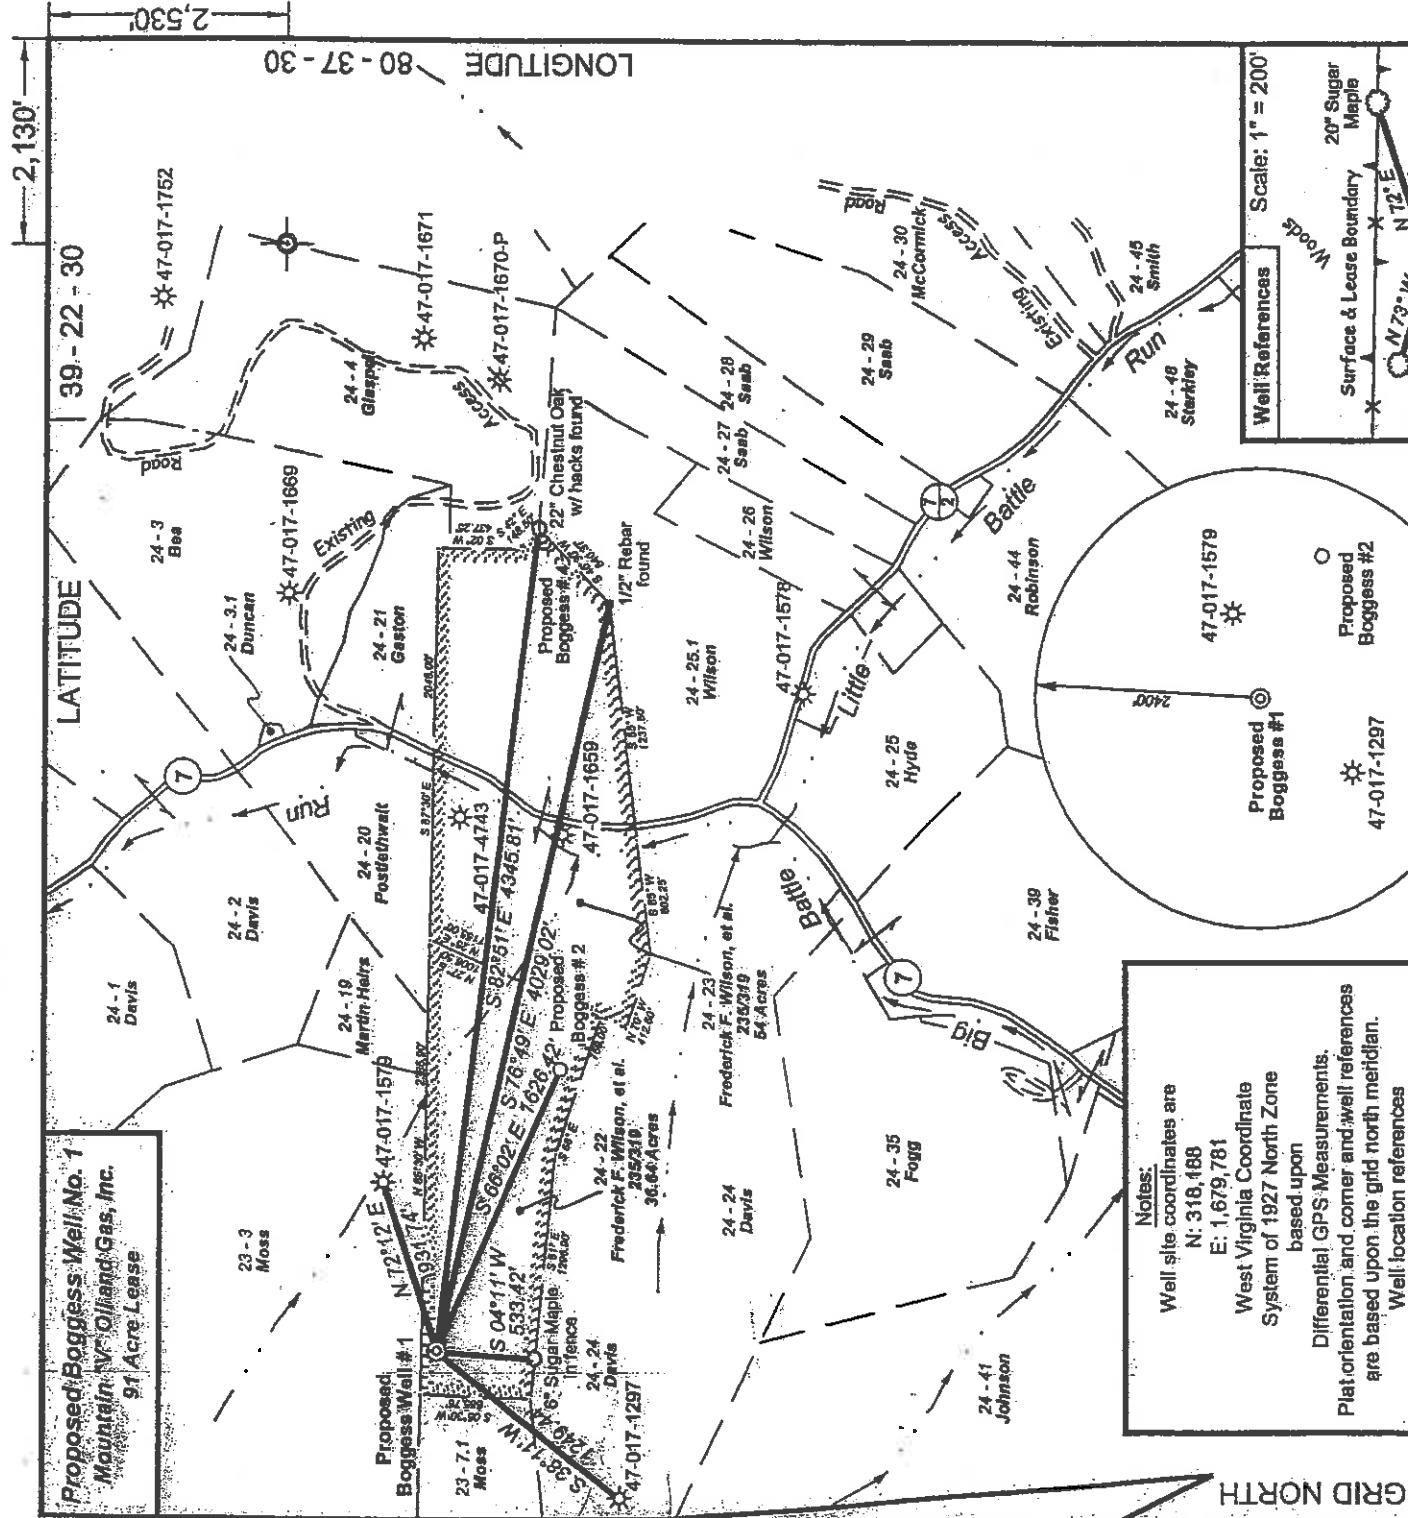


Proposed Boggess Well No. 1
Mountain View Oilfield Gas, Inc.
91 Acre Lease

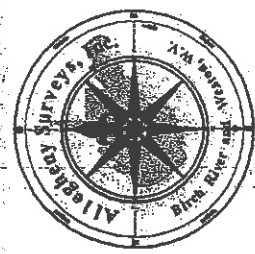

Notes:
 Well site coordinates are
 N: 316,188
 E: 1,679,781
 West Virginia Coordinate
 System of 1927 North Zone
 based upon
 Differential GPS Measurements.
 Plat orientation and corner and well references
 are based upon the grid north meridian.
 Well location references
 are based upon the magnetic meridian.

(*) Denotes Location of well on United States Topographic Maps

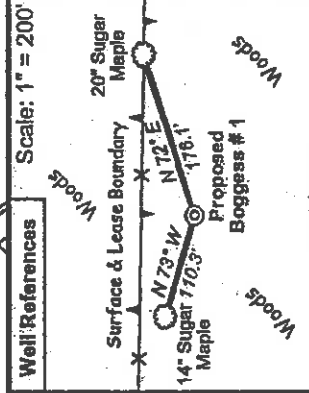

I, the undersigned, hereby certify that this plat is correct to the best of my knowledge and belief and shows all the information required by law and the regulations issued and prescribed by the Department of Mines.

James R. Skinner
 P.S. 1962



FILE NO: W-08-30-M-03
 DRAWING NO: W0830M03-1.dwg
 SCALE: 1" = 1000'
 MINIMUM DEGREE OF ACCURACY: 1:2500
 PROVEN SOURCE OF ELEVATION: Bench Mark Elevation: 830'

STATE OF WEST VIRGINIA
DEPARTMENT OF ENVIRONMENTAL PROTECTION
OIL AND GAS DIVISION

DATE: March 29, 20 01
 OPERATOR'S WELL NO. Boggess #1
 API WELL NO:
 STATE 47 COUNTY 017 PERMIT 04813

WELL TYPE: OIL GAS LIQUID INJECTION WASTE DISPOSAL
 (IF GAS) PRODUCTION: STORAGE DEEP SHALLOW
 LOCATION: ELEVATION: 1074' WATERSHED Tributary to Big Battle Run QUADRANGLE: Smithburg 7.5'
 DISTRICT: McClellan COUNTY: Doddridge
 SURFACE OWNER: Frederick F. Wilson, et al. LEASE NO:
 OIL AND GAS ROYALTY OWNER: Frederick F. Wilson, et al. ACERAGE: 36.64 of 91
 PROPOSED WORK: DRILL CONVERT DRILL DEEPER FRACTURE OR STIMULATE PLUG OFF OLD FORMATION
 PERFORATE NEW FORMATION OTHER PHYSICAL CHANGE IN WELL (SPECIFY)
 PLUG AND ABANDON CLEAN OUT AND REPLUG TARGET FORMATION: Benson ESTIMATED DEPTH: 5995'

WELL OPERATOR: Mountain View Oil & Gas, Inc. DESIGNATED AGENT: S. Michael Shaver
 ADDRESS: P.O. Box 470 ADDRESS: P.O. Box 470
 Bridgeport, WV 26330 Bridgeport, WV 26330

0000 4843

State of West Virginia
Department of Environmental Protection
Office of Oil and Gas

prop

Well Operator's Report of Well Work

Farm name: Fredrick F. Wilson, Etal

Operator Well No.: BOGGESS #1

LOCATION: Elevation: 1074'

Quadrangle: Smithburg 7.5'

District: McClellan

County: Doddridge

2530' Latitude: 39 Feet South of 22 Deg. 30 Min. 00 Sec.
2130' Longitude: 80 Feet West of 37 Deg. 30 Min. 00 Sec.

Company: Mountain V Oil & Gas, Inc.

Address	Casing & Tubing	Used in drilling	Left in well	Cement fill up Cu. Ft.
<u>PO Box 470</u>	<u>13 3/8</u>		<u>32'</u>	<u>Sanded In</u>
<u>Bridgeport, WV 26330</u>	<u>9 5/8</u>		<u>308'</u>	<u>83 sks.</u>
<u>Agent: Mike Shaver</u>	<u>7</u>		<u>1646'</u>	<u>215 sks.</u>
<u>Inspector: Mike Underwood</u>	<u>4 1/2</u>		<u>5187'</u>	<u>375 sks.</u>
<u>Date Permit Issued: 6-17-2004</u>				
<u>Date Well Work Commenced: 9-21-04</u>				
<u>Date Well Work Completed: 9-25-04</u>				
<u>Verbal Plugging:</u>				
<u>Date Permission granted on:</u>				
<u>Rotary X Cable Rig</u>				
<u>Total Depth (feet): 5250'</u>				
<u>Fresh Water Depth (ft.): N/A</u>				
<u>Salt Water Depth (ft.): N/A</u>				
<u>Is coal being mined in area (N/Y)? N</u>				
<u>Coal Depths (ft.):</u>				

OPEN FLOW DATA

Producing formation INJUN, BENSON Pay zone depth (ft) 2104-5095

Gas: Initial open flow N/A MCF/d Oil: Initial open flow N/A Bbl/d

Final open flow 581,000 MCF/d Final open flow N/A Bbl/d

Time of open flow between initial and final tests 72 Hours

Static rock Pressure 520 psig (surface pressure) after 24 Hours

Second producing formation _____ Pay zone depth (ft) _____

Gas: Initial open flow _____ MCF/d Oil: Initial open flow _____ Bbl/d

Final open flow _____ MCF/d Final open flow _____ Bbl/d

Time of open flow between initial and final tests _____ Hours

Static rock Pressure _____ psig (surface pressure) after _____ Hours

NOTE: ON BACK OF THIS FORM PUT THE FOLLOWING: 1). DETAILS OF PERFORATED INTERVALS, FRACTURING OR STIMULATING, PHYSICAL CHANGE, ETC. 2). THE WELL LOG WHICH IS A SYSTEMATIC DETAILED GEOLOGICAL RECORD OF ALL FORMATIONS INCLUDING COAL ENCOUNTERED BY THE WELLBORE.

Signed:

Mike Shaver
By: Mike Shaver, Vice President

Date: October 15, 2004

0000 4843

RECEIVED
Office of Oil & Gas
October 19 2004
WV Department of Environmental Protection

JAN 07 2005

