



LONGITUDE 80-37-30
LAT. 39-27-30

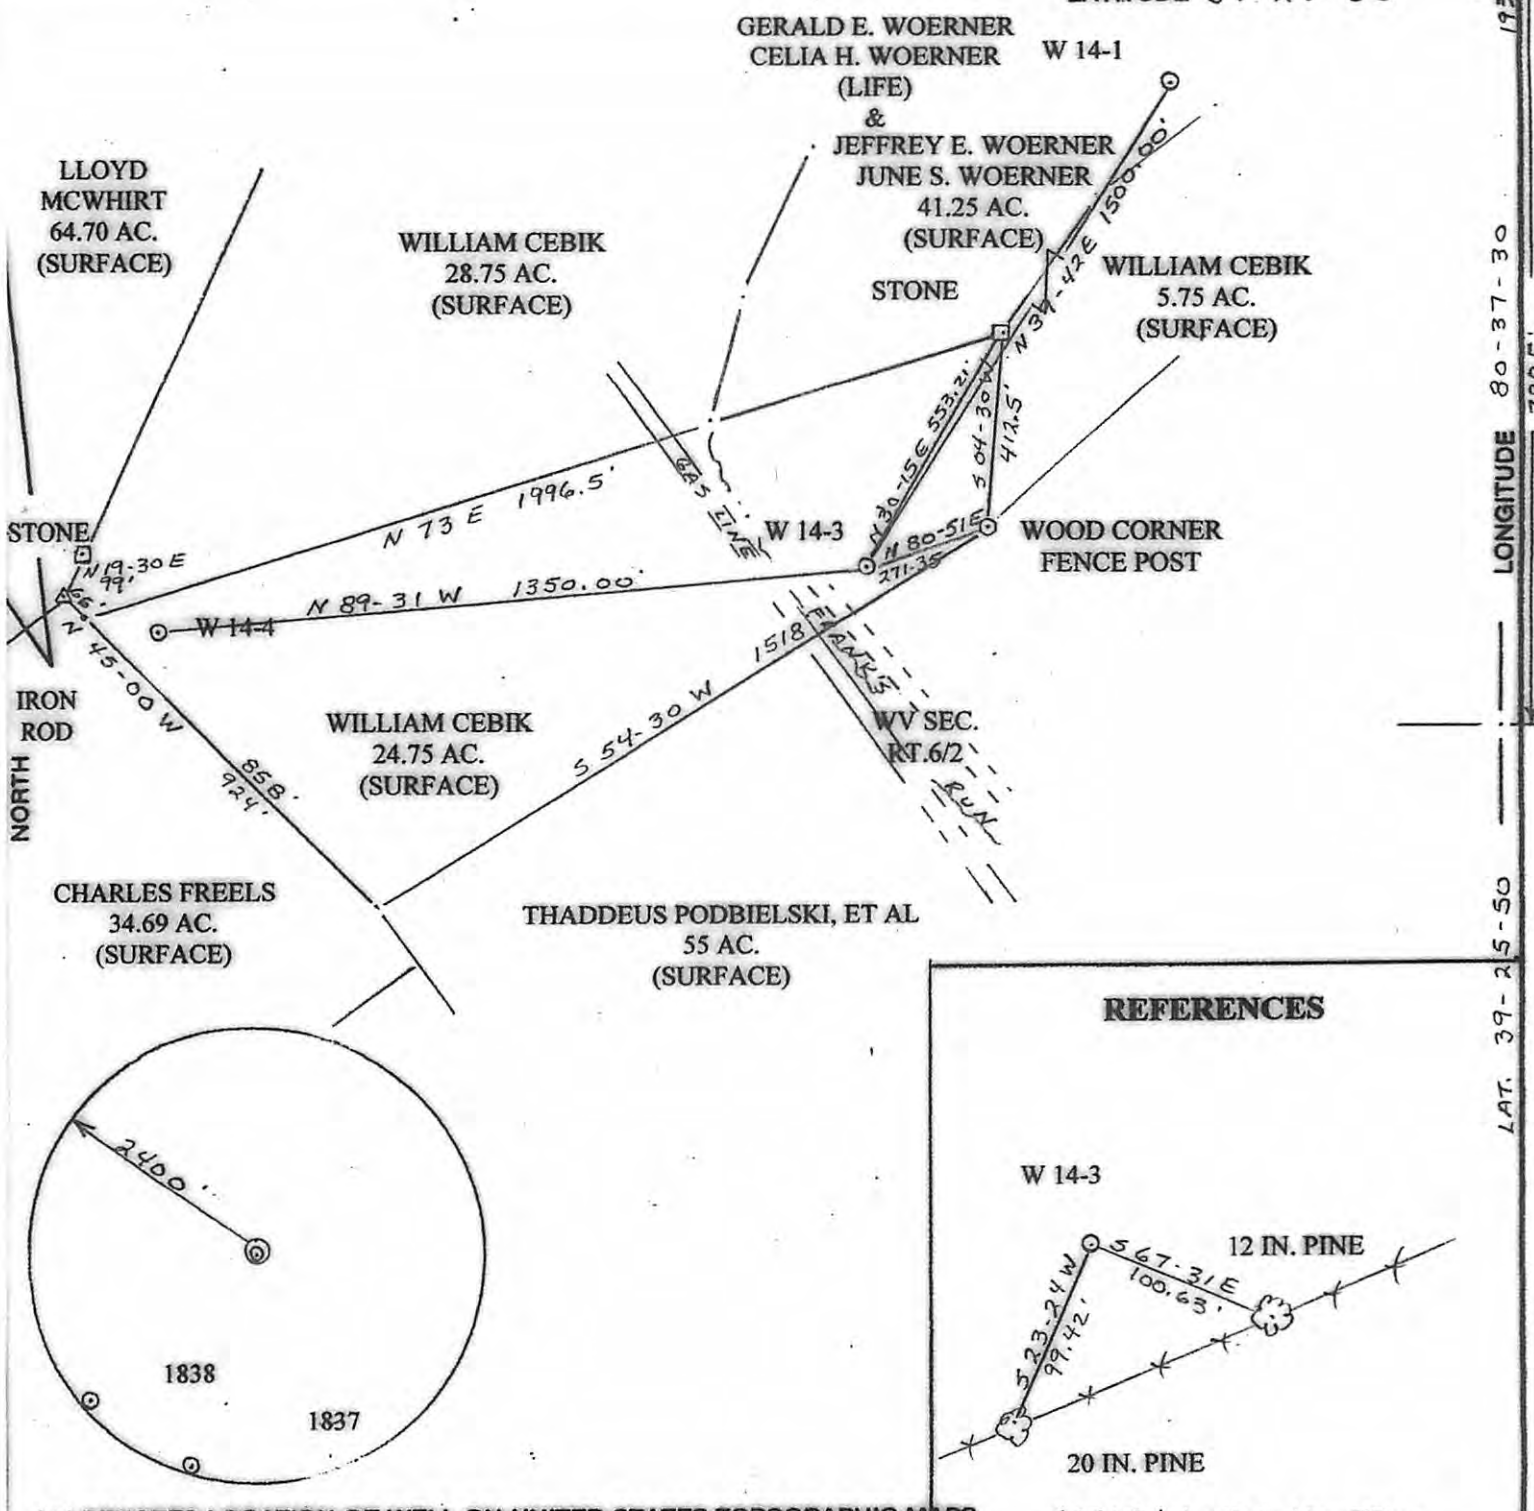

REFERENCES

W 14-3

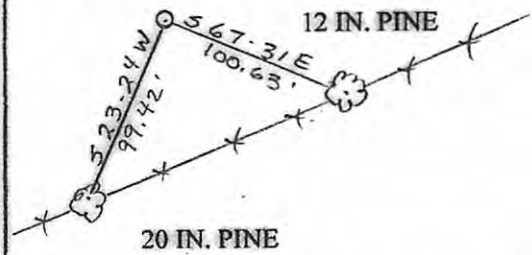


SCALE: 1 IN. = 100 FT.

(+) DENOTES LOCATION OF WELL ON UNITED STATES TOPOGRAPHIC MAPS

FILE NO. _____
 DRAWING NO. W 14-3
 SCALE 1 IN. = 400 FT.
 MINIMUM DEGREE OF ACCURACY 1/2500
 PROVEN SOURCE OF ELEVATION USGS BM ALONG WV SEC. RT. 4 - ELEV 1087'

I THE UNDERSIGNED, HEREBY CERTIFY THAT THIS PLAT IS CORRECT TO THE BEST OF MY KNOWLEDGE AND BELIEF AND SHOWS ALL THE INFORMATION REQUIRED BY LAW AND THE REGULATIONS ISSUED AND PRESCRIBED BY THE DEPARTMENT OF ENERGY
 (SIGNED) Daniel J. Wellings 03/14/07
 R.P.E. _____ L.L.S. #1851

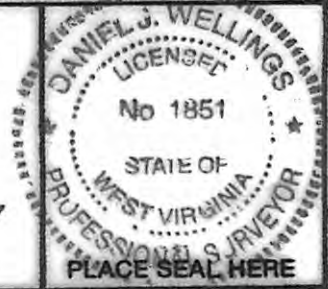

STATE OF WEST VIRGINIA
 DIVISION OF ENVIRONMENTAL PROTECTION
 OFFICE OF OIL AND GAS



DATE MARCH 14, 2007
 OPERATOR'S WELL NO. W 14-3 F
 API WELL NO. _____

WELL TYPE: OIL GAS LIQUID INJECTION _____ WASTE DISPOSAL _____
 (IF "GAS,") PRODUCTION _____ STORAGE _____ DEEP SHALLOW _____
 LOCATION: ELEVATION 1043 WATERSHED FRANK'S RUN
 DISTRICT MCCLELLAN COUNTY BOADRIDGE
 QUADRANGLE CENTER POINT

47 - 017 - 05166F
 STATE COUNTY PERMIT

CANCELLED

SURFACE OWNER WILLIAM CEBIK ACREAGE 24.75
 OIL & GAS ROYALTY OWNER REFER TO APPLICATION LEASE ACREAGE 24.75

PROPOSED WORK: DRILL CONVERT _____ DRILL DEEPER _____ REDRILL _____ FRACTURE OR STIMULATE PLUG OFF OLD FORMATION _____ PERFORATE NEW FORMATION _____ OTHER PHYSICAL CHANGE IN WELL (SPECIFY) _____

PLUG AND ABANDON _____ CLEAN OUT AND REPLUG _____
 TARGET FORMATION Goleson ESTIMATED DEPTH 3000'
 WELL OPERATOR JAY BEE OIL & GAS INC. DESIGNATED AGENT RANDY BRODA
 ADDRESS 1720 RT. 22 EAST UNION NJ 07083 ADDRESS RT. 1 BOX 5 CAIRO, WV 26337