
	Т.
WW-7	
8-30-06	
West Virginia Department of Environmental Protect	ion
Office of Oil and Gas	
WELL LOCATION FORM: GPS	
API: 47-017-06077 WELL NO.: Erwin 2H	1
FARM NAME: Erwin Hilltop	
RESPONSIBLE PARTY NAME: Antero Resources Corpora	ition
COUNTY: Doddridge DISTRICT: New Milton	n
QUADRANGLE: New Milton	
SURFACE OWNER: Sandra E. Erwin	
ROYALTY OWNER:	
UTM GPS NORTHING: 4336599.24 m	
UTM GPS EASTING: 525142.23 m GPS ELEVATION: 1226	6.3 ft
 The Responsible Party named above has chosen to submit GPS coordinates in lieu preparing a new well location plat for a plugging permit or assigned API number of above well. The Office of Oil and Gas will not accept GPS coordinates that do not the following requirements: Datum: NAD 1983, Zone: 17 North, Coordinate Units: meters, Altitude height above mean sea level (MSL) – meters. Accuracy to Datum – 3.05 meters Data Collection Method: 	on the t meet
Survey grade GPS <u>×</u> : Post Processed Differential	RECEIVED Office of Oil and Gas
Real-Time Differential X	
Mapping Grade GPS X : Post Processed Differential	JUN 13 2022
Real-Time Differential X	WV Department of Environmental Protection

4. Letter size copy of the topography map showing the well location. I the undersigned, hereby certify this data is correct to the best of my knowledge and belief and shows all the information required by law and the regulations issued and prescribed by the Office of Oil and Gas.

Permitting Manager 5/10/22 Title Date Signature

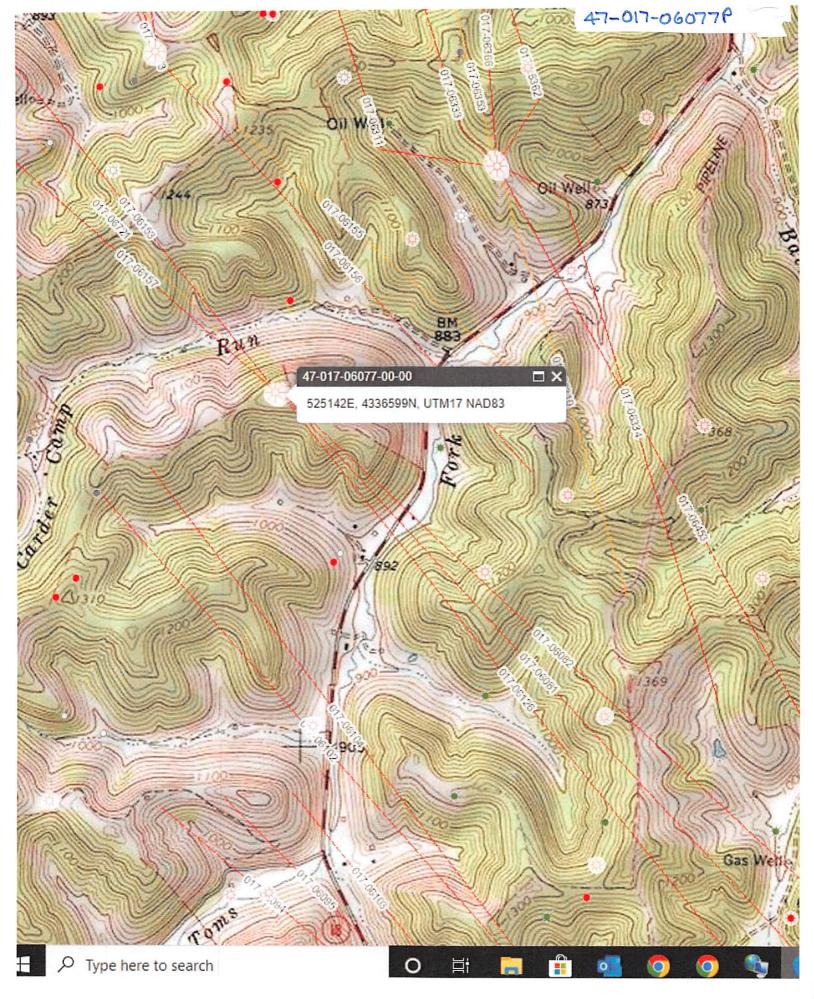

06/24/2022