

**RECEIVED**

AUG 03 2015

**WV GEOLOGICAL SURVEY**  
MORGANTOWN, WV



**Antero Resources**  
Cross Unit 2H  
Doddridge County WV  
Northing: 14230769.12  
Easting: 1736361.60  
As Drilled

**WELL DETAILS: Cross Unit 2H**

|               |       |             |            |                                 |      |
|---------------|-------|-------------|------------|---------------------------------|------|
| +N/-S         | +E/-W | Northing    | Easting    | Longitude                       | Slct |
| 0.0           | 0.0   | 14230769.12 | 1736361.60 | 11° 18.791' N 80° 39' 40.868" W |      |
| Ground Level: |       | 1332.0      |            |                                 |      |

**PROJECT DETAILS: Doddridge County WV**

Geodetic System: Universal Transverse Mercator (US Survey Feet)  
Datum: NAD 1983 (NAD83 CONUS)  
Ellipsoid: Clarke 1866  
Zone: Zone 17N (84 W to 78 W)  
System Datum: Mean Sea Level

**REFERENCE INFORMATION**

Copyright © 2015 Antero Resources, LLC. All Rights Reserved.  
Map Data © 2015 Antero Resources, LLC. All Rights Reserved.  
Map Data © 2015 Antero Resources, LLC. All Rights Reserved.  
Map Data © 2015 Antero Resources, LLC. All Rights Reserved.

Genie Lightfoot  
Scientific Drilling  
421 South Eagle Lane  
Oklahoma City, Oklahoma  
405-787-3663




**LEGEND**

- ▲ Dorothy Unit 2H, Original Wellpath, As Drilled V0
- ◊ Cross Unit 1H, Original Wellpath, As Drilled V0
- ⊕ Dorothy Unit 1H, Original Wellpath, As Drilled V0
- ⊖ Cross Unit 2H, Original Wellpath, Plan 7 V0
- As Drilled

**DESIGN TARGET DETAILS**


| Name                     | TVD    | +N/-S  | Northing            | Easting         | Latitude                        | Longitude         |
|--------------------------|--------|--------|---------------------|-----------------|---------------------------------|-------------------|
| SHL Cross Unit 2H        | 0.0    | 0.0    | 0.014230769 12      | 1736361.6039 11 | 11° 18.791' N 80° 39' 40.868" W | 80° 39' 40.868" W |
| Actual BHL Cross Unit 2H | 7362.1 | 7502.8 | -20665.014238271 82 | 1734296.6289 12 | 33.052° N 80° 40' 6.873" W      |                   |

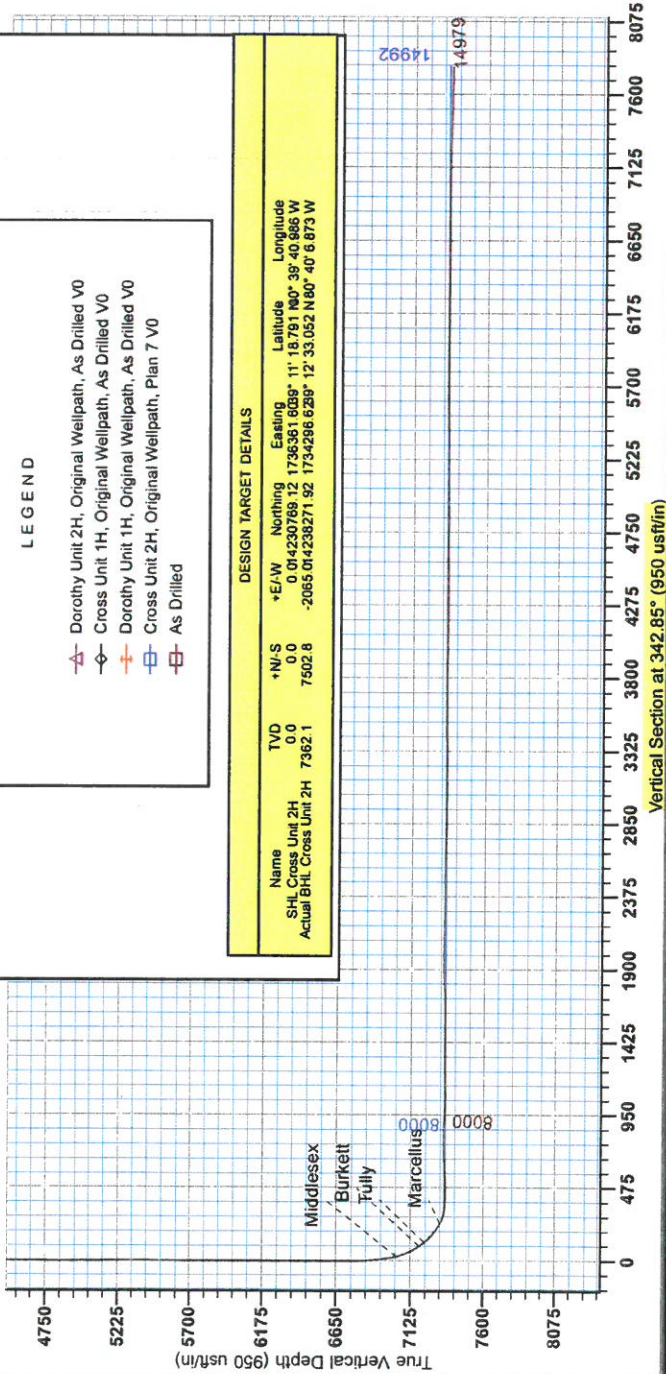

To convert Magnetic North to Grid, Subtract 8.72°  
To convert True North to Grid, Subtract 0.21°

**Magnetic Field**  
Strength: 52501.5 nT  
Angle: 116.52013  
Date: 11/6/2013  
Model: IGRF2010

**Asimuth to Grid North**  
True North: -0.21°  
Magnetic North: -8.72°

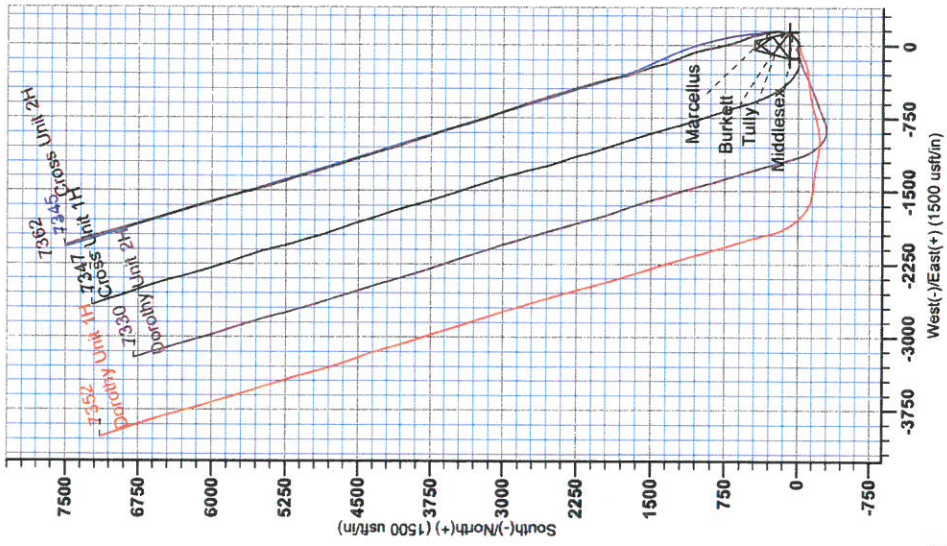



**RECEIVED**  
AUG 03 2015  
WV GEOLOGICAL SURVEY  
MORGANTOWN, WV

## **Antero Resources**

**Doddridge County WV  
Stewart Pad  
Cross Unit 2H  
Original Wellpath**

**Design: As Drilled**

## **EOW Completion Report**


**27 March, 2014**





RECEIVED

AUG 03 2015

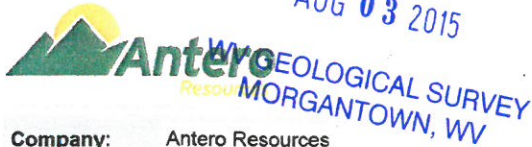

EOW Completion Report



**Company:** Antero Resources  
**Project:** Doddridge County WV  
**Site:** Stewart Pad  
**Well:** Cross Unit 2H  
**Wellbore:** Original Wellpath  
**Design:** As Drilled

**Local Co-ordinate Reference:** Well Cross Unit 2H  
**TVD Reference:** 1332' GL + 22.5' RKB @ 1354.5usft  
**MD Reference:** 1332' GL + 22.5' RKB @ 1354.5usft  
**North Reference:** Grid  
**Survey Calculation Method:** Minimum Curvature  
**Database:** Oklahoma District

|                    |  |                      |                |
|--------------------|--|----------------------|----------------|
| <b>Project</b>     | Doddridge County WV, McClellan District        |                      |                |
| <b>Map System:</b> | Universal Transverse Mercator (US Survey Feet) | <b>System Datum:</b> | Mean Sea Level |
| <b>Geo Datum:</b>  | NAD 1927 (NADCON CONUS)                        |                      |                |
| <b>Map Zone:</b>   | Zone 17N (84 W to 78 W)                        |                      |                |

|                              |             |                     |                    |                          |                  |
|------------------------------|-------------|---------------------|--------------------|--------------------------|------------------|
| <b>Site</b>                  | Stewart Pad |                     |                    |                          |                  |
| <b>Site Position:</b>        |             | <b>Northing:</b>    | 14,230,768.62 usft | <b>Latitude:</b>         | 39° 11' 18.788 N |
| <b>From:</b>                 | Map         | <b>Easting:</b>     | 1,736,331.61 usft  | <b>Longitude:</b>        | 80° 39' 41.367 W |
| <b>Position Uncertainty:</b> | 0.0 usft    | <b>Slot Radius:</b> | 13-3/16"           | <b>Grid Convergence:</b> | 0.21 °           |

|                             |                          |          |                            |                    |                      |                  |
|-----------------------------|--------------------------|----------|----------------------------|--------------------|----------------------|------------------|
| <b>Well</b>                 | Cross Unit 2H, Marcellus |          |                            |                    |                      |                  |
| <b>Well Position</b>        | <b>+N/-S</b>             | 0.0 usft | <b>Northing:</b>           | 14,230,769.12 usft | <b>Latitude:</b>     | 39° 11' 18.791 N |
|                             | <b>+E/-W</b>             | 0.0 usft | <b>Easting:</b>            | 1,736,361.60 usft  | <b>Longitude:</b>    | 80° 39' 40.986 W |
| <b>Position Uncertainty</b> | 2.0 usft                 |          | <b>Wellhead Elevation:</b> | 1,345.0 usft       | <b>Ground Level:</b> | 1,332.0 usft     |

|                  |                   |                    |                        |                      |                            |
|------------------|-------------------|--------------------|------------------------|----------------------|----------------------------|
| <b>Wellbore</b>  | Original Wellpath |                    |                        |                      |                            |
| <b>Magnetics</b> | <b>Model Name</b> | <b>Sample Date</b> | <b>Declination (°)</b> | <b>Dip Angle (°)</b> | <b>Field Strength (nT)</b> |
|                  | IGRF2010          | 11/5/2013          | -8.51                  | 66.78                | 52,302                     |

|                          |                                |                     |                     |                      |     |
|--------------------------|--------------------------------|---------------------|---------------------|----------------------|-----|
| <b>Design</b>            | As Drilled                     |                     |                     |                      |     |
| <b>Audit Notes:</b>      |                                |                     |                     |                      |     |
| <b>Version:</b>          | 1.0                            | <b>Phase:</b>       | ACTUAL              | <b>Tie On Depth:</b> | 0.0 |
| <b>Vertical Section:</b> | <b>Depth From (TVD) (usft)</b> | <b>+N/-S (usft)</b> | <b>+E/-W (usft)</b> | <b>Direction (°)</b> |     |
|                          | 0.0                            | 0.0                 | 0.0                 | 342.85               |     |

|                       |                  |  |                     |  |  |
|-----------------------|------------------|--|---------------------|--|--|
| <b>Survey Program</b> | Date 3/27/2014   |  |                     |  |  |
| <b>From (usft)</b>    | <b>To (usft)</b> | <b>Survey (Wellbore)</b>                 | <b>Tool Name</b>    | <b>Description</b>                                 |  |
| 109.5                 | 6,734.1          | Survey #4 Final Gyro (Original Wellpath) | SDI Standard Keeper | Scientific Drilling Intl. Standard Wireline Keeper |  |
| 6,734.1               | 14,979.0         | Survey #5 MWD (Original Wellpath)        | SDI MWD             | Scientific Drilling Intl. MWD - Standard ver 1.0.1 |  |

| MD (usft) | Inc (°) | Azi (azimuth) (°) | TVD (usft) | N/S (usft) | E/W (usft) | V. Sec (usft) | DLeg (°/100usft) |
|-----------|---------|-------------------|------------|------------|------------|---------------|------------------|
| 0.0       | 0.00    | 0.00              | 0.0        | 0.0        | 0.0        | 0.0           | 0.00             |
| 109.5     | 0.38    | 83.23             | 109.5      | 0.0        | 0.4        | -0.1          | 0.35             |
| 209.5     | 0.28    | 81.09             | 209.5      | 0.1        | 0.9        | -0.2          | 0.10             |
| 309.5     | 0.21    | 83.16             | 309.5      | 0.2        | 1.4        | -0.2          | 0.07             |
| 409.5     | 0.21    | 123.62            | 409.5      | 0.1        | 1.7        | -0.4          | 0.15             |
| 509.5     | 0.17    | 83.59             | 509.5      | 0.0        | 2.0        | -0.6          | 0.14             |
| 609.5     | 0.16    | 132.73            | 609.5      | -0.1       | 2.2        | -0.7          | 0.14             |
| 709.5     | 0.19    | 115.69            | 709.5      | -0.2       | 2.5        | -1.0          | 0.06             |
| 809.5     | 0.17    | 165.12            | 809.5      | -0.4       | 2.7        | -1.2          | 0.15             |
| 909.5     | 0.18    | 133.01            | 909.5      | -0.7       | 2.8        | -1.5          | 0.10             |
| 1,009.5   | 0.19    | 164.99            | 1,009.5    | -1.0       | 3.0        | -1.8          | 0.10             |

AUG 03 2015



EOW Completion Report



**Company:** Antero Resources  
**Project:** Doddridge County WV  
**Site:** Stewart Pad  
**Well:** Cross Unit 2H  
**Wellbore:** Original Wellpath  
**Design:** As Drilled

**Local Co-ordinate Reference:** Well Cross Unit 2H  
**TVD Reference:** 1332' GL + 22.5' RKB @ 1354.5usft  
**MD Reference:** 1332' GL + 22.5' RKB @ 1354.5usft  
**North Reference:** Grid  
**Survey Calculation Method:** Minimum Curvature  
**Database:** Oklahoma District

Survey

| MD (usft) | Inc (°) | Azi (azimuth) (°) | TVD (usft) | N/S (usft) | E/W (usft) | V. Sec (usft) | DLeg (°/100usft) |
|-----------|---------|-------------------|------------|------------|------------|---------------|------------------|
| 1,109.5   | 0.19    | 129.21            | 1,109.5    | -1.2       | 3.2        | -2.1          | 0.12             |
| 1,209.5   | 0.16    | 170.64            | 1,209.5    | -1.5       | 3.3        | -2.4          | 0.13             |
| 1,309.5   | 0.24    | 140.22            | 1,309.5    | -1.8       | 3.5        | -2.7          | 0.13             |
| 1,409.5   | 0.12    | 142.44            | 1,409.5    | -2.0       | 3.7        | -3.0          | 0.12             |
| 1,509.5   | 0.25    | 148.07            | 1,509.5    | -2.3       | 3.8        | -3.3          | 0.13             |
| 1,609.5   | 0.26    | 143.57            | 1,609.5    | -2.6       | 4.1        | -3.7          | 0.02             |
| 1,709.5   | 0.40    | 143.03            | 1,709.5    | -3.1       | 4.4        | -4.3          | 0.14             |
| 1,809.5   | 0.32    | 125.33            | 1,809.5    | -3.6       | 4.9        | -4.8          | 0.14             |
| 1,909.5   | 0.31    | 138.09            | 1,909.5    | -3.9       | 5.3        | -5.3          | 0.07             |
| 2,009.5   | 0.42    | 123.84            | 2,009.5    | -4.3       | 5.8        | -5.8          | 0.14             |
| 2,109.5   | 0.29    | 128.25            | 2,109.5    | -4.7       | 6.3        | -6.3          | 0.13             |
| 2,209.5   | 0.48    | 126.28            | 2,209.5    | -5.1       | 6.8        | -6.9          | 0.19             |
| 2,309.5   | 0.35    | 125.66            | 2,309.5    | -5.5       | 7.4        | -7.4          | 0.13             |
| 2,409.5   | 0.38    | 123.42            | 2,409.5    | -5.9       | 7.9        | -7.9          | 0.03             |
| 2,509.5   | 0.22    | 106.04            | 2,509.5    | -6.1       | 8.4        | -8.3          | 0.18             |
| 2,609.5   | 0.14    | 124.92            | 2,609.5    | -6.2       | 8.7        | -8.5          | 0.10             |
| 2,709.5   | 0.17    | 86.60             | 2,709.5    | -6.3       | 8.9        | -8.6          | 0.11             |
| 2,809.5   | 0.02    | 17.45             | 2,809.5    | -6.3       | 9.1        | -8.7          | 0.16             |
| 2,909.5   | 0.09    | 260.41            | 2,909.5    | -6.3       | 9.0        | -8.6          | 0.10             |
| 3,009.5   | 0.09    | 271.99            | 3,009.5    | -6.3       | 8.8        | -8.6          | 0.02             |
| 3,109.5   | 0.16    | 333.85            | 3,109.5    | -6.1       | 8.7        | -8.4          | 0.14             |
| 3,209.5   | 0.09    | 353.69            | 3,209.5    | -5.9       | 8.6        | -8.2          | 0.08             |
| 3,309.5   | 0.03    | 301.57            | 3,309.5    | -5.8       | 8.6        | -8.1          | 0.08             |
| 3,409.5   | 0.08    | 276.40            | 3,409.5    | -5.8       | 8.5        | -8.1          | 0.05             |
| 3,509.5   | 0.04    | 42.07             | 3,509.5    | -5.8       | 8.5        | -8.0          | 0.11             |
| 3,609.5   | 0.12    | 295.00            | 3,609.5    | -5.7       | 8.4        | -7.9          | 0.14             |
| 3,709.5   | 0.17    | 312.39            | 3,709.5    | -5.6       | 8.2        | -7.7          | 0.07             |
| 3,809.5   | 0.15    | 322.84            | 3,809.5    | -5.4       | 8.0        | -7.5          | 0.04             |
| 3,909.5   | 0.08    | 22.16             | 3,909.5    | -5.2       | 7.9        | -7.3          | 0.13             |
| 4,009.5   | 0.10    | 231.90            | 4,009.5    | -5.2       | 7.9        | -7.3          | 0.17             |
| 4,109.5   | 0.24    | 300.80            | 4,109.5    | -5.1       | 7.7        | -7.2          | 0.22             |
| 4,209.5   | 0.12    | 294.20            | 4,209.5    | -5.0       | 7.4        | -6.9          | 0.12             |
| 4,309.5   | 0.15    | 280.35            | 4,309.5    | -4.9       | 7.2        | -6.8          | 0.04             |
| 4,409.5   | 0.34    | 252.79            | 4,409.5    | -5.0       | 6.7        | -6.8          | 0.22             |
| 4,509.5   | 0.56    | 251.17            | 4,509.5    | -5.2       | 6.0        | -6.8          | 0.22             |
| 4,609.5   | 0.83    | 247.31            | 4,609.5    | -5.7       | 4.9        | -6.9          | 0.27             |
| 4,709.5   | 1.11    | 241.06            | 4,709.4    | -6.4       | 3.4        | -7.1          | 0.30             |
| 4,809.5   | 1.18    | 246.66            | 4,809.4    | -7.3       | 1.6        | -7.4          | 0.13             |
| 4,909.5   | 1.20    | 243.35            | 4,909.4    | -8.2       | -0.3       | -7.7          | 0.07             |
| 5,009.5   | 0.55    | 281.51            | 5,009.4    | -8.5       | -1.7       | -7.7          | 0.84             |
| 5,109.5   | 2.65    | 32.60             | 5,109.4    | -6.5       | -1.0       | -5.9          | 2.89             |
| 5,209.5   | 4.63    | 63.43             | 5,209.2    | -2.8       | 3.9        | -3.8          | 2.72             |
| 5,309.5   | 5.61    | 73.47             | 5,308.8    | 0.4        | 12.2       | -3.2          | 1.32             |
| 5,409.5   | 4.05    | 76.93             | 5,408.4    | 2.6        | 20.3       | -3.5          | 1.59             |




AUG 03 2015



WV GEOLOGICAL SURVEY  
MORGANTOWN, WV

EOW Completion Report

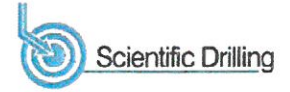

**Company:** Antero Resources  
**Project:** Doddridge County WV  
**Site:** Stewart Pad  
**Well:** Cross Unit 2H  
**Wellbore:** Original Wellpath  
**Design:** As Drilled

**Local Co-ordinate Reference:** Well Cross Unit 2H  
**TVD Reference:** 1332' GL + 22.5' RKB @ 1354.5usft  
**MD Reference:** 1332' GL + 22.5' RKB @ 1354.5usft  
**North Reference:** Grid  
**Survey Calculation Method:** Minimum Curvature  
**Database:** Oklahoma District

**Survey**

| MD (usft)        | Inc (°) | Azi (azimuth) (°) | TVD (usft) | N/S (usft) | EW (usft) | V. Sec (usft) | DLeg (°/100usft) |
|------------------|---------|-------------------|------------|------------|-----------|---------------|------------------|
| 5,509.5          | 3.01    | 79.72             | 5,508.2    | 3.9        | 26.3      | -4.0          | 1.05             |
| 5,609.5          | 2.27    | 73.34             | 5,608.1    | 4.9        | 30.8      | -4.4          | 0.80             |
| 5,709.5          | 1.44    | 80.72             | 5,708.1    | 5.7        | 34.0      | -4.6          | 0.86             |
| 5,809.5          | 0.83    | 88.23             | 5,808.0    | 5.9        | 35.9      | -4.9          | 0.63             |
| 5,909.5          | 0.57    | 100.41            | 5,908.0    | 5.9        | 37.1      | -5.3          | 0.30             |
| 6,009.5          | 0.56    | 78.33             | 6,008.0    | 5.9        | 38.1      | -5.6          | 0.22             |
| 6,109.5          | 0.40    | 83.44             | 6,108.0    | 6.0        | 38.9      | -5.7          | 0.17             |
| 6,209.5          | 0.41    | 71.25             | 6,208.0    | 6.2        | 39.6      | -5.8          | 0.09             |
| 6,309.5          | 0.26    | 128.87            | 6,308.0    | 6.1        | 40.1      | -6.0          | 0.35             |
| 6,409.5          | 0.36    | 62.77             | 6,408.0    | 6.1        | 40.6      | -6.1          | 0.35             |
| 6,509.5          | 0.15    | 80.29             | 6,508.0    | 6.3        | 41.0      | -6.1          | 0.22             |
| 6,609.5          | 0.14    | 96.25             | 6,608.0    | 6.3        | 41.3      | -6.1          | 0.04             |
| 6,709.5          | 0.16    | 59.87             | 6,708.0    | 6.4        | 41.5      | -6.1          | 0.10             |
| 6,734.1          | 0.14    | 112.74            | 6,732.6    | 6.4        | 41.6      | -6.2          | 0.55             |
| 6,758.0          | 0.62    | 65.27             | 6,756.5    | 6.4        | 41.7      | -6.2          | 2.24             |
| 6,790.0          | 2.99    | 45.15             | 6,788.5    | 7.1        | 42.4      | -5.7          | 7.55             |
| 6,821.0          | 5.80    | 46.29             | 6,819.4    | 8.7        | 44.2      | -4.7          | 9.07             |
| 6,852.0          | 9.58    | 46.29             | 6,850.1    | 11.6       | 47.1      | -2.8          | 12.19            |
| 6,882.0          | 12.75   | 47.26             | 6,879.5    | 15.6       | 51.4      | -0.3          | 10.58            |
| 6,912.0          | 15.65   | 49.01             | 6,908.6    | 20.5       | 56.9      | 2.8           | 9.77             |
| 6,943.0          | 18.91   | 51.30             | 6,938.2    | 26.4       | 64.0      | 6.3           | 10.74            |
| 6,974.0          | 22.42   | 50.86             | 6,967.2    | 33.2       | 72.5      | 10.4          | 11.33            |
| 7,004.0          | 24.71   | 47.96             | 6,994.7    | 41.0       | 81.6      | 15.2          | 8.55             |
| 7,035.0          | 25.59   | 41.90             | 7,022.8    | 50.4       | 90.8      | 21.3          | 8.78             |
| 7,051.0          | 26.19   | 38.52             | 7,037.2    | 55.7       | 95.3      | 25.1          | 9.96             |
| <b>Middlesex</b> |         |                   |            |            |           |               |                  |
| 7,066.0          | 26.82   | 35.48             | 7,050.6    | 61.1       | 99.4      | 29.0          | 9.96             |
| 7,096.0          | 28.14   | 28.89             | 7,077.2    | 72.8       | 106.7     | 38.1          | 11.04            |
| 7,126.0          | 30.25   | 22.91             | 7,103.4    | 85.9       | 113.1     | 48.8          | 11.99            |
| 7,156.0          | 32.92   | 19.91             | 7,129.0    | 100.5      | 118.8     | 61.0          | 10.32            |
| 7,186.0          | 35.53   | 17.73             | 7,153.8    | 116.5      | 124.2     | 74.7          | 9.61             |
| 7,217.0          | 38.60   | 15.44             | 7,178.5    | 134.4      | 129.6     | 90.2          | 10.86            |
| 7,222.0          | 39.15   | 14.95             | 7,182.4    | 137.5      | 130.4     | 92.9          | 12.56            |
| <b>Burkett</b>   |         |                   |            |            |           |               |                  |
| 7,247.0          | 41.91   | 12.65             | 7,201.4    | 153.2      | 134.2     | 106.8         | 12.56            |
| 7,265.0          | 43.96   | 10.44             | 7,214.6    | 165.2      | 136.7     | 117.6         | 14.12            |
| <b>Tully</b>     |         |                   |            |            |           |               |                  |
| 7,278.0          | 45.46   | 8.94              | 7,223.8    | 174.3      | 138.2     | 125.7         | 14.12            |
| 7,309.0          | 47.57   | 3.49              | 7,245.2    | 196.6      | 140.6     | 146.4         | 14.45            |
| 7,339.0          | 50.32   | 358.64            | 7,264.9    | 219.2      | 141.0     | 167.9         | 15.25            |
| 7,370.0          | 53.02   | 354.35            | 7,284.1    | 243.5      | 139.5     | 191.5         | 13.91            |
| 7,401.0          | 56.98   | 351.18            | 7,301.9    | 268.6      | 136.3     | 216.5         | 15.27            |
| 7,431.0          | 62.61   | 349.69            | 7,317.0    | 294.2      | 132.0     | 242.2         | 19.25            |
| <b>Marcellus</b> |         |                   |            |            |           |               |                  |
| 7,462.0          | 69.94   | 349.78            | 7,329.4    | 322.1      | 127.0     | 270.3         | 23.65            |

RECEIVED

AUG 03 2015



EOW Completion Report



Company: Antero Resources
Project: Doddridge County WV
Site: Stewart Pad
Well: Cross Unit 2H
Wellbore: Original Wellpath
Design: As Drilled

Local Co-ordinate Reference: Well Cross Unit 2H
TVD Reference: 1332' GL + 22.5' RKB @ 1354.5usft
MD Reference: 1332' GL + 22.5' RKB @ 1354.5usft
North Reference: Grid
Survey Calculation Method: Minimum Curvature
Database: Oklahoma District

Survey

Table with 9 columns: MD (usft), Inc (°), Azi (azimuth) (°), TVD (usft), N/S (usft), E/W (usft), V. Sec (usft), DLeg (°/100usft). Contains 50 rows of survey data.




RECEIVED

AUG 03 2015



WV GEOLOGICAL SURVEY  
MORGANTOWN, WV

EOW Completion Report

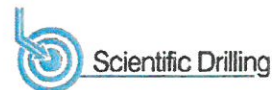

Company: Antero Resources  
Project: Doddridge County WV  
Site: Stewart Pad  
Well: Cross Unit 2H  
Wellbore: Original Wellpath  
Design: As Drilled

Local Co-ordinate Reference: Well Cross Unit 2H  
TVD Reference: 1332' GL + 22.5' RKB @ 1354.5usft  
MD Reference: 1332' GL + 22.5' RKB @ 1354.5usft  
North Reference: Grid  
Survey Calculation Method: Minimum Curvature  
Database: Oklahoma District

Survey

| MD (usft) | Inc (°) | Azi (azimuth) (°) | TVD (usft) | N/S (usft) | E/W (usft) | V. Sec (usft) | DLeg (°/100usft) |
|-----------|---------|-------------------|------------|------------|------------|---------------|------------------|
| 11,548.0  | 90.31   | 343.18            | 7,348.5    | 4,217.2    | -1,080.8   | 4,348.4       | 0.30             |
| 11,642.0  | 90.40   | 343.18            | 7,347.9    | 4,307.2    | -1,108.0   | 4,442.4       | 0.10             |
| 11,737.0  | 90.48   | 343.62            | 7,347.2    | 4,398.2    | -1,135.1   | 4,537.4       | 0.47             |
| 11,832.0  | 91.01   | 344.24            | 7,346.0    | 4,489.5    | -1,161.4   | 4,632.3       | 0.86             |
| 11,926.0  | 88.55   | 340.28            | 7,346.3    | 4,579.0    | -1,190.1   | 4,726.3       | 4.96             |
| 12,021.0  | 89.60   | 341.87            | 7,347.8    | 4,668.8    | -1,220.9   | 4,821.2       | 2.01             |
| 12,116.0  | 90.13   | 343.54            | 7,348.1    | 4,759.5    | -1,249.1   | 4,916.2       | 1.84             |
| 12,211.0  | 91.36   | 343.45            | 7,346.8    | 4,850.6    | -1,276.1   | 5,011.2       | 1.30             |
| 12,306.0  | 89.60   | 342.39            | 7,346.0    | 4,941.4    | -1,304.0   | 5,106.2       | 2.16             |
| 12,401.0  | 90.04   | 343.01            | 7,346.3    | 5,032.1    | -1,332.2   | 5,201.2       | 0.80             |
| 12,496.0  | 91.10   | 345.03            | 7,345.4    | 5,123.4    | -1,358.4   | 5,296.2       | 2.40             |
| 12,591.0  | 88.72   | 340.46            | 7,345.5    | 5,214.1    | -1,386.6   | 5,391.1       | 5.42             |
| 12,686.0  | 92.15   | 343.01            | 7,344.8    | 5,304.3    | -1,416.3   | 5,486.1       | 4.50             |
| 12,781.0  | 91.54   | 343.54            | 7,341.8    | 5,395.2    | -1,443.7   | 5,581.0       | 0.85             |
| 12,876.0  | 89.87   | 344.15            | 7,340.6    | 5,486.5    | -1,470.1   | 5,676.0       | 1.87             |
| 12,971.0  | 90.31   | 345.21            | 7,340.4    | 5,578.1    | -1,495.2   | 5,771.0       | 1.21             |
| 13,066.0  | 89.43   | 345.65            | 7,340.7    | 5,670.0    | -1,519.1   | 5,865.9       | 1.04             |
| 13,161.0  | 89.43   | 345.73            | 7,341.6    | 5,762.1    | -1,542.6   | 5,960.8       | 0.08             |
| 13,256.0  | 89.43   | 343.98            | 7,342.6    | 5,853.8    | -1,567.4   | 6,055.7       | 1.84             |
| 13,351.0  | 89.96   | 344.33            | 7,343.1    | 5,945.2    | -1,593.3   | 6,150.7       | 0.67             |
| 13,446.0  | 89.52   | 343.54            | 7,343.5    | 6,036.5    | -1,619.6   | 6,245.6       | 0.95             |
| 13,540.0  | 88.93   | 343.16            | 7,344.8    | 6,126.5    | -1,646.5   | 6,339.6       | 0.75             |
| 13,635.0  | 89.96   | 343.18            | 7,345.7    | 6,217.4    | -1,674.0   | 6,434.6       | 1.08             |
| 13,729.0  | 89.87   | 341.95            | 7,345.8    | 6,307.1    | -1,702.2   | 6,528.6       | 1.31             |
| 13,823.0  | 90.31   | 342.83            | 7,345.7    | 6,396.7    | -1,730.6   | 6,622.6       | 1.05             |
| 13,918.0  | 90.22   | 343.10            | 7,345.2    | 6,487.5    | -1,758.5   | 6,717.6       | 0.30             |
| 14,013.0  | 90.02   | 342.92            | 7,345.0    | 6,578.4    | -1,786.2   | 6,812.6       | 0.28             |
| 14,107.0  | 88.90   | 342.74            | 7,345.9    | 6,668.2    | -1,814.0   | 6,906.6       | 1.21             |
| 14,202.0  | 90.84   | 344.06            | 7,346.1    | 6,759.2    | -1,841.1   | 7,001.6       | 2.47             |
| 14,297.0  | 89.08   | 344.50            | 7,346.2    | 6,850.7    | -1,866.9   | 7,096.6       | 1.91             |
| 14,391.0  | 89.69   | 345.82            | 7,347.2    | 6,941.5    | -1,890.9   | 7,190.5       | 1.55             |
| 14,487.0  | 87.85   | 343.71            | 7,349.3    | 7,034.1    | -1,916.1   | 7,286.4       | 2.92             |
| 14,581.0  | 87.76   | 343.62            | 7,352.9    | 7,124.3    | -1,942.6   | 7,380.3       | 0.14             |
| 14,677.0  | 88.11   | 342.83            | 7,356.3    | 7,216.1    | -1,970.3   | 7,476.2       | 0.90             |
| 14,867.0  | 89.08   | 340.99            | 7,361.0    | 7,396.7    | -2,029.2   | 7,666.2       | 1.09             |
| 14,919.0  | 89.87   | 342.31            | 7,361.5    | 7,446.0    | -2,045.6   | 7,718.1       | 2.96             |
| 14,979.0  | 89.00   | 340.00            | 7,362.1    | 7,502.8    | -2,065.0   | 7,778.1       | 4.11             |



**Company:** Antero Resources  
**Project:** Doddridge County WV  
**Site:** Stewart Pad  
**Well:** Cross Unit 2H  
**Wellbore:** Original Wellpath  
**Design:** As Drilled

**Local Co-ordinate Reference:** Well Cross Unit 2H  
**TVD Reference:** 1332' GL + 22.5' RKB @ 1354.5usft  
**MD Reference:** 1332' GL + 22.5' RKB @ 1354.5usft  
**North Reference:** Grid  
**Survey Calculation Method:** Minimum Curvature  
**Database:** Oklahoma District

**Design Annotations**

| Measured Depth (usft) | Vertical Depth (usft) | Local Coordinates |              | Comment   |
|-----------------------|-----------------------|-------------------|--------------|-----------|
|                       |                       | +N/-S (usft)      | +E/-W (usft) |           |
| 7,051.0               | 7,037.2               | 55.7              | 95.3         | Middlesex |
| 7,222.0               | 7,182.4               | 137.5             | 130.4        | Burkett   |
| 7,265.0               | 7,214.6               | 165.2             | 136.7        | Tully     |
| 7,431.0               | 7,317.0               | 294.2             | 132.0        | Marcellus |

Checked By: \_\_\_\_\_ Approved By: \_\_\_\_\_ Date: \_\_\_\_\_

RECEIVED

AUG 03 2015

WV GEOLOGICAL SURVEY  
MORGANTOWN, WV