

RECEIVED

JUN 08 2015

WV GEOLOGICAL SURVEY

MORGANTOWN, WV



Antero Resources
Swisher Unit 1H
Doddridge County WV
Northing: 14238707.44
Easting: 1734919.21
As Drilled

WELL DETAILS: Swisher Unit 1H
 Ground Level: 976.0
 Slot
 Longitude
 Latitude
 Slot
 Longitude
 Latitude
 Slot

REFERENCE INFORMATION
 Co-ordinate (NE) Reference: Well Swisher Unit 1H, Grid North
 Vertical (TVD) Reference: Swisher 1H 976 CL + 24 KB @ 1000.0usft
 Section (VS) Reference: Slot - (0.0N, 0.0E)
 Measured Depth Reference: Swisher 1H 976 CL + 24 KB @ 1000.0usft
 Calculation Method: Minimum Curvature

PROJECT DETAILS: Doddridge County WV
 Geodetic System: Universal Transverse Mercator (US Survey Feet)
 Datum: NAD83 (NAD 83)
 Ellipsoid: Clarke 1866
 Zone: Zone 17N (84 W to 78 W)
 System Datum: Mean Sea Level

Geie Lightfoot
 10:51, December 09 2013
 Scientific Drilling
 421 South Eagle Lane
 Oklahoma City, OK





LEGEND

- ✖ Josie Unit 1H, Original Wellpath, As Drilled V0
- ✖ Josie Unit 2H, Original Wellpath, As Drilled V0
- ✖ Swisher Unit 1H, Original Wellpath, Plan 4 Post Gyro V0
- As Drilled

DESIGN TARGET DETAILS

Name	TVD	+N/-S	+E/-W	Northing	Easting	Latitude	Longitude
SHL Swisher Unit 1H	0.0	0.0	0.0	0.014238707.44	1734919.21	37.336 N 0° 39' 58.941 W	
Actual BHL Swisher Unit 1H	116966.3	-7894.1		3747.44230813.31	1738666.599	11° 19.142 N 0° 39' 11.699 W	

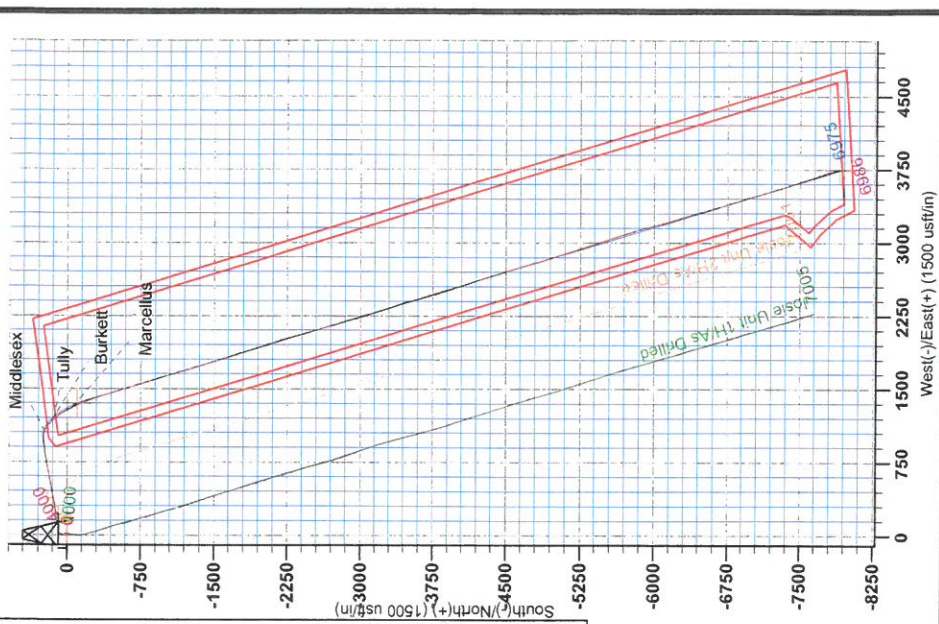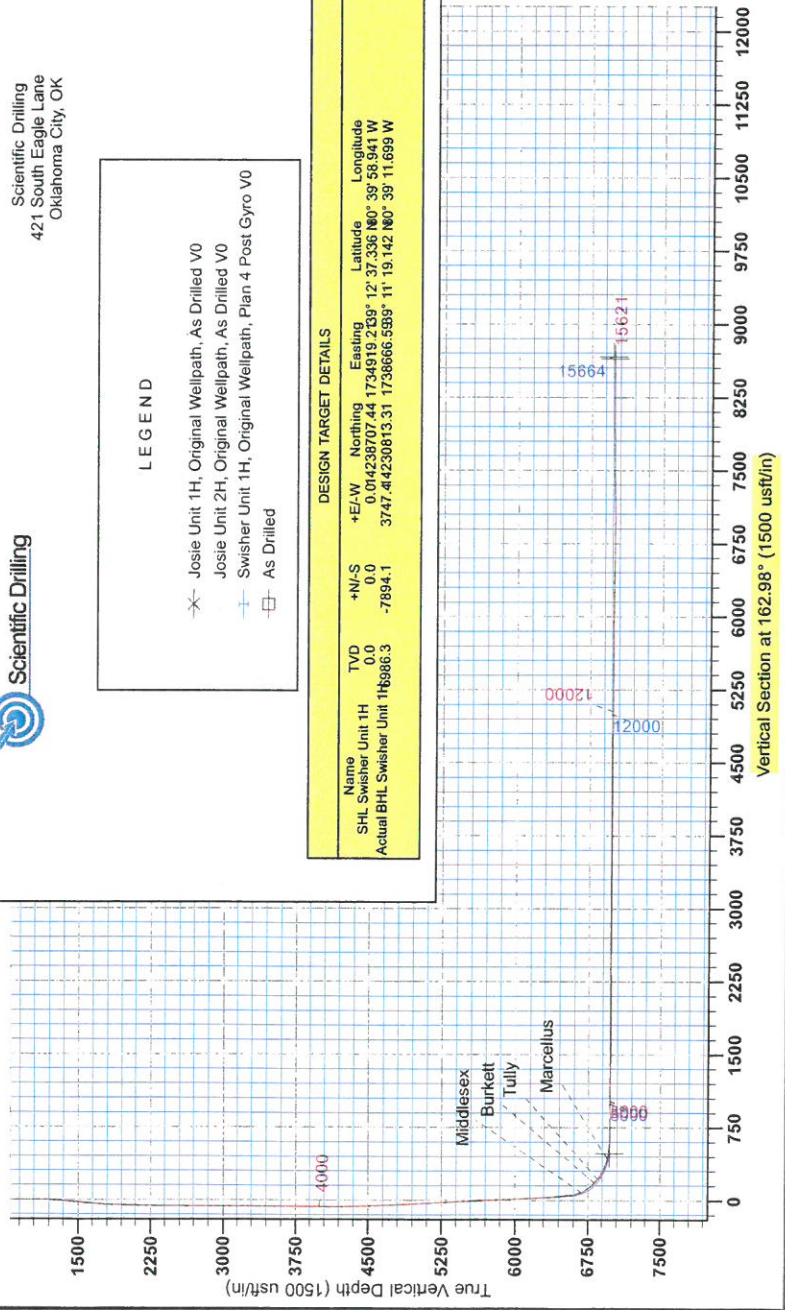



RECEIVED

JUN 08 2015

WV GEOLOGICAL SURVEY
MORGANTOWN, WV

Antero Resources

**Doddridge County WV
Josie/Swisher/Union Pad
Swisher Unit 1H
Original Wellpath**

Design: As Drilled

EOW Completion Report

09 December, 2013





Company: Antero Resources
Project: Doddridge County WV
Site: Josie/Swisher/Union Pad
Well: Swisher Unit 1H
Wellbore: Original Wellpath
Design: As Drilled
Local Co-ordinate Reference: Well Swisher Unit 1H
TVD Reference: Swisher 1H 976 GL + 24 KB @ 1000.0usft
MD Reference: Swisher 1H 976 GL + 24 KB @ 1000.0usft
North Reference: Grid
Survey Calculation Method: Minimum Curvature
Database: Oklahoma District

Project	Doddridge County WV, McClellan District		
Map System:	Universal Transverse Mercator (US Survey Feet)	System Datum:	Mean Sea Level
Geo Datum:	NAD 1927 (NADCON CONUS)		
Map Zone:	Zone 17N (84 W to 78 W)		

Site Josie/Swisher/Union Pad
Site Position:
From: Map
Position Uncertainty: 2.0 usft
Northing: 14,238,711.36 usft
Easting: 1,734,928.40 usft
Slot Radius: 13-3/16"
Latitude: 39° 12' 37.374 N
Longitude: 80° 39' 58.824 W
Grid Convergence: 0.21 °

Well Swisher Unit 1H, Marcellus
Well Position
+N/-S 0.0 usft
+E/-W 0.0 usft
Position Uncertainty 2.0 usft
Northing: 14,238,707.44 usft
Easting: 1,734,919.21 usft
Wellhead Elevation: 1,000.0 usft
Latitude: 39° 12' 37.336 N
Longitude: 80° 39' 58.941 W
Ground Level: 976.0 usft

Wellbore	Original Wellpath				
Magnetics	Model Name	Sample Date	Declination (°)	Dip Angle (°)	Field Strength (nT)
	IGRF2010	9/21/2013	-8.51	66.80	52,331

Design As Drilled
Audit Notes:
Version: 1.0
Phase: ACTUAL
Tie On Depth: 0.0
Vertical Section:

Depth From (TVD) (usft)	+N/-S (usft)	+E/-W (usft)	Direction (°)
0.0	0.0	0.0	162.98


Survey Program	Date 12/9/2013			
From (usft)	To (usft)	Survey (Wellbore)	Tool Name	Description
100.0	1,117.5	Survey #2 Def Gyro (Original Wellpath)	SDI Standard Keeper	Scientific Drilling Intl. Standard Wireline Keeper
1,200.0	2,658.4	Survey #4 Def Gyro to Int (Original Wellpa	SDI Standard Keeper	Scientific Drilling Intl. Standard Wireline Keeper
2,700.0	4,074.3	Survey #6 Final Gyro (Original Wellpath)	SDI Standard Keeper	Scientific Drilling Intl. Standard Wireline Keeper
4,100.0	6,306.6	Survey #8 Final Gyro (Original Wellpath)	SDI Standard Keeper	Scientific Drilling Intl. Standard Wireline Keeper
6,350.0	15,621.0	Survey #7 MWD (Original Wellpath)	SDI MWD	Scientific Drilling Intl. MWD - Standard ver 1.0.1

Survey							
MD (usft)	Inc (°)	Azi (azimuth) (°)	TVD (usft)	N/S (usft)	E/W (usft)	V. Sec (usft)	DLeg (°/100usft)
0.0	0.00	0.00	0.0	0.0	0.0	0.0	0.00
100.0	0.85	302.18	100.0	0.4	-0.6	-0.6	0.85
200.0	0.61	341.44	200.0	1.3	-1.4	-1.7	0.54
300.0	0.75	6.68	300.0	2.4	-1.5	-2.8	0.33
400.0	0.64	14.45	400.0	3.6	-1.3	-3.9	0.14
500.0	0.28	40.31	500.0	4.4	-1.0	-4.5	0.41
600.0	0.29	339.79	600.0	4.8	-0.9	-4.9	0.29
700.0	0.16	340.35	700.0	5.2	-1.1	-5.2	0.13

JUN 08 2015



EOW Completion Report

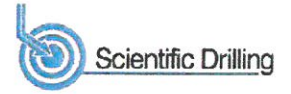

Company: Antero Resources
Project: Doddridge County WV
Site: Josie/Swisher/Union Pad
Well: Swisher Unit 1H
Wellbore: Original Wellpath
Design: As Drilled

Local Co-ordinate Reference: Well Swisher Unit 1H
TVD Reference: Swisher 1H 976 GL + 24 KB @ 1000.0usft
MD Reference: Swisher 1H 976 GL + 24 KB @ 1000.0usft
North Reference: Grid
Survey Calculation Method: Minimum Curvature
Database: Oklahoma District

Survey

MD (usft)	Inc (°)	Azi (azimuth) (°)	TVD (usft)	N/S (usft)	E/W (usft)	V. Sec (usft)	DLeg (°/100usft)
800.0	0.17	41.80	800.0	5.4	-1.0	-5.5	0.17
900.0	0.12	119.73	900.0	5.5	-0.8	-5.5	0.19
1,000.0	0.06	4.09	1,000.0	5.5	-0.7	-5.4	0.16
1,100.0	0.02	209.61	1,100.0	5.5	-0.7	-5.5	0.08
1,117.5	0.12	151.48	1,117.5	5.5	-0.7	-5.5	0.63
1,200.0	1.00	13.29	1,200.0	6.1	-0.5	-6.0	1.32
1,300.0	3.60	12.60	1,299.9	10.0	0.4	-9.5	2.60
1,400.0	6.46	14.45	1,399.5	18.5	2.5	-17.0	2.86
1,500.0	6.84	15.05	1,498.8	29.7	5.4	-26.8	0.39
1,600.0	6.77	8.18	1,598.1	41.3	7.8	-37.2	0.82
1,700.0	4.91	359.92	1,697.6	51.4	8.6	-46.7	2.04
1,800.0	3.32	14.04	1,797.3	58.5	9.3	-53.2	1.87
1,900.0	2.59	21.00	1,897.2	63.4	10.8	-57.5	0.81
2,000.0	2.16	15.66	1,997.1	67.4	12.1	-60.9	0.48
2,100.0	1.44	18.47	2,097.1	70.4	13.1	-63.5	0.73
2,200.0	0.93	27.83	2,197.0	72.3	13.8	-65.1	0.54
2,300.0	0.75	23.47	2,297.0	73.6	14.5	-66.1	0.19
2,400.0	0.51	13.95	2,397.0	74.6	14.8	-67.0	0.26
2,500.0	0.34	358.80	2,497.0	75.4	14.9	-67.7	0.20
2,600.0	0.31	63.73	2,597.0	75.8	15.2	-68.0	0.35
2,658.4	0.28	4.32	2,655.4	76.0	15.3	-68.2	0.50
2,700.0	0.24	22.43	2,697.0	76.2	15.4	-68.3	0.22
2,800.0	0.22	357.50	2,797.0	76.6	15.4	-68.7	0.10
2,900.0	0.30	328.74	2,897.0	77.0	15.3	-69.1	0.15
3,000.0	0.38	316.02	2,997.0	77.4	14.9	-69.7	0.11
3,100.0	0.24	331.71	3,097.0	77.9	14.6	-70.2	0.16
3,200.0	0.10	49.65	3,197.0	78.1	14.6	-70.4	0.24
3,300.0	0.12	98.85	3,297.0	78.1	14.7	-70.4	0.09
3,400.0	0.30	116.02	3,397.0	78.0	15.1	-70.2	0.19
3,500.0	0.12	65.47	3,497.0	77.9	15.4	-70.0	0.24
3,600.0	0.03	29.53	3,597.0	78.0	15.5	-70.0	0.10
3,700.0	0.14	322.75	3,697.0	78.1	15.5	-70.2	0.13
3,800.0	0.21	336.61	3,797.0	78.4	15.3	-70.5	0.08
3,900.0	0.17	327.48	3,897.0	78.7	15.2	-70.8	0.05
4,000.0	0.28	328.61	3,997.0	79.0	14.9	-71.2	0.11
4,074.3	0.15	34.06	4,071.3	79.2	14.9	-71.4	0.35
4,100.0	0.14	338.29	4,097.0	79.3	14.9	-71.5	0.53
4,200.0	3.24	69.35	4,196.9	80.4	17.5	-71.8	3.25
4,300.0	7.31	77.60	4,296.5	82.8	26.4	-71.4	4.13
4,400.0	10.83	80.43	4,395.2	85.7	41.9	-69.7	3.55
4,500.0	13.71	83.17	4,492.9	88.7	62.9	-66.4	2.94
4,600.0	16.28	82.58	4,589.5	91.9	88.6	-62.0	2.57
4,700.0	17.89	78.05	4,685.1	96.9	117.5	-58.3	2.09
4,800.0	19.43	80.91	4,779.9	102.7	148.9	-54.6	1.79



Company: Antero Resources
Project: Doddridge County WV
Site: Josie/Swisher/Union Pad
Well: Swisher Unit 1H
Wellbore: Original Wellpath
Design: As Drilled

Local Co-ordinate Reference: Well Swisher Unit 1H
TVD Reference: Swisher 1H 976 GL + 24 KB @ 1000.0usft
MD Reference: Swisher 1H 976 GL + 24 KB @ 1000.0usft
North Reference: Grid
Survey Calculation Method: Minimum Curvature
Database: Oklahoma District

Survey

MD (usft)	Inc (°)	Azi (azimuth) (°)	TVD (usft)	N/S (usft)	E/W (usft)	V. Sec (usft)	DLeg (°/100usft)
4,900.0	21.60	79.98	4,873.5	108.5	183.5	-50.1	2.19
5,000.0	23.13	82.93	4,966.0	114.1	221.1	-44.4	1.90
5,100.0	23.38	80.70	5,057.9	119.8	260.2	-38.4	0.92
5,200.0	24.88	79.44	5,149.1	126.8	300.5	-33.3	1.59
5,300.0	26.35	79.17	5,239.3	134.9	342.9	-28.6	1.47
5,400.0	27.42	79.37	5,328.5	143.3	387.4	-23.6	1.07
5,500.0	27.10	79.62	5,417.4	151.6	432.4	-18.4	0.34
5,600.0	25.89	78.61	5,506.9	160.0	476.2	-13.6	1.29
5,700.0	25.60	79.24	5,597.0	168.4	518.8	-9.1	0.40
5,800.0	24.89	79.68	5,687.4	176.2	560.8	-4.3	0.73
5,900.0	24.72	78.12	5,778.2	184.3	601.9	0.0	0.68
6,000.0	26.91	78.20	5,868.2	193.2	644.5	3.9	2.19
6,100.0	28.74	77.47	5,956.6	203.0	690.2	7.9	1.86
6,200.0	26.55	79.10	6,045.2	212.5	735.6	12.1	2.32
6,300.0	26.62	79.65	6,134.6	220.7	779.6	17.1	0.26
6,306.6	26.82	79.74	6,140.5	221.3	782.5	17.5	3.11
6,350.0	26.13	77.33	6,179.4	225.1	801.5	19.3	2.94
6,443.0	26.42	78.85	6,262.8	233.6	841.7	23.0	0.79
6,538.0	26.28	82.44	6,347.9	240.5	883.3	28.6	1.68
6,632.0	27.77	86.29	6,431.6	244.6	925.8	37.1	2.44
6,723.0	26.71	85.06	6,512.6	247.7	967.3	46.2	1.32
6,757.0	26.24	85.01	6,543.0	249.1	982.4	49.4	1.38
6,789.0	25.96	86.42	6,571.7	250.1	996.5	52.5	2.13
6,817.0	26.90	94.06	6,596.8	250.0	1,008.9	56.2	12.59
6,851.0	29.11	104.69	6,626.8	247.4	1,024.6	63.3	16.03
6,883.0	31.51	106.49	6,654.5	243.1	1,040.2	72.0	8.02
6,911.0	34.12	107.38	6,678.0	238.6	1,054.7	80.5	9.48
6,919.0	34.67	108.99	6,684.6	237.2	1,059.0	83.1	13.27
Middlesex							
6,945.0	36.58	113.92	6,705.7	231.7	1,073.0	92.6	13.27
6,977.0	39.61	119.39	6,730.9	222.8	1,090.6	106.2	14.17
7,005.0	41.50	123.69	6,752.2	213.3	1,106.1	119.9	12.05
7,039.0	44.26	127.98	6,777.1	199.7	1,124.9	138.3	11.81
7,071.0	47.48	131.38	6,799.4	185.0	1,142.5	157.5	12.62
7,099.0	49.81	134.89	6,817.9	170.7	1,157.9	175.7	12.56
7,106.0	50.19	135.49	6,822.4	166.9	1,161.6	180.5	8.53
Burkett							
7,133.0	51.69	137.74	6,839.4	151.6	1,176.0	199.3	8.53
7,161.0	53.91	138.55	6,856.3	135.0	1,190.9	219.5	8.26
Tully							
7,165.0	54.23	138.66	6,858.7	132.6	1,193.1	222.4	8.26
7,193.0	56.98	141.22	6,874.5	114.9	1,207.9	243.7	12.38
7,228.0	62.11	144.97	6,892.2	90.8	1,226.0	272.1	17.32
7,259.0	65.71	147.79	6,905.9	67.6	1,241.4	298.7	14.20
7,287.0	68.61	150.66	6,916.7	45.4	1,254.6	323.8	14.02



EOW Completion Report



WV GEOLOGICAL SURVEY
MORGANTOWN, WV

Company: Antero Resources
Project: Doddridge County WV
Site: Josie/Swisher/Union Pad
Well: Swisher Unit 1H
Wellbore: Original Wellpath
Design: As Drilled

Local Co-ordinate Reference: Well Swisher Unit 1H
TVD Reference: Swisher 1H 976 GL + 24 KB @ 1000.0usft
MD Reference: Swisher 1H 976 GL + 24 KB @ 1000.0usft
North Reference: Grid
Survey Calculation Method: Minimum Curvature
Database: Oklahoma District

Survey

MD (usft)	Inc (°)	Azi (azimuth) (°)	TVD (usft)	N/S (usft)	EW (usft)	V. Sec (usft)	DLeg (°/100usft)
7,322.0	70.60	151.48	6,928.9	16.7	1,270.5	355.9	6.09
7,353.0	72.69	151.43	6,938.7	-9.1	1,284.5	384.7	6.74
7,382.0	75.14	151.79	6,946.7	-33.7	1,297.8	412.0	8.53
7,401.0	77.24	152.63	6,951.3	-50.0	1,306.4	430.2	11.85
Marcellus							
7,416.0	78.90	153.28	6,954.4	-63.0	1,313.0	444.6	11.85
7,447.0	80.48	153.86	6,959.9	-90.4	1,326.6	474.7	5.42
7,476.0	81.41	154.22	6,964.5	-116.1	1,339.2	503.0	3.43
7,510.0	85.14	156.62	6,968.5	-146.8	1,353.2	536.5	13.02
7,568.0	89.73	161.85	6,971.1	-201.0	1,373.7	594.2	11.99
7,601.0	90.23	161.86	6,971.1	-232.3	1,384.0	627.2	1.52
7,695.0	89.93	162.53	6,970.9	-321.8	1,412.7	721.2	0.78
7,789.0	89.63	162.37	6,971.3	-411.4	1,441.1	815.2	0.36
7,883.0	88.96	162.02	6,972.5	-500.9	1,469.8	909.2	0.80
7,980.0	90.40	163.46	6,973.0	-593.5	1,498.6	1,006.2	2.10
8,074.0	89.56	162.84	6,973.0	-683.5	1,525.9	1,100.2	1.11
8,168.0	87.92	161.43	6,975.1	-772.9	1,554.7	1,194.2	2.30
8,262.0	87.79	161.22	6,978.6	-861.9	1,584.8	1,288.1	0.26
8,357.0	89.26	163.37	6,981.1	-952.4	1,613.6	1,383.0	2.74
8,450.0	90.54	163.91	6,981.2	-1,041.6	1,639.8	1,476.0	1.49
8,544.0	90.23	164.01	6,980.6	-1,132.0	1,665.8	1,570.0	0.35
8,639.0	89.69	164.07	6,980.7	-1,223.3	1,691.9	1,665.0	0.57
8,733.0	89.83	163.17	6,981.1	-1,313.5	1,718.4	1,759.0	0.97
8,827.0	89.53	162.21	6,981.6	-1,403.2	1,746.4	1,853.0	1.07
8,921.0	90.13	161.81	6,981.9	-1,492.6	1,775.4	1,946.9	0.77
9,013.0	90.17	162.26	6,981.6	-1,580.1	1,803.8	2,038.9	0.49
9,104.0	90.50	162.55	6,981.1	-1,666.9	1,831.3	2,129.9	0.48
9,196.0	90.70	162.81	6,980.1	-1,754.7	1,858.7	2,221.9	0.36
9,287.0	90.94	162.28	6,978.8	-1,841.5	1,886.0	2,312.9	0.64
9,379.0	91.20	161.66	6,977.1	-1,929.0	1,914.5	2,404.9	0.73
9,470.0	88.86	161.05	6,977.1	-2,015.2	1,943.6	2,495.8	2.66
9,562.0	88.43	162.36	6,979.2	-2,102.5	1,972.4	2,587.8	1.50
9,653.0	90.40	163.72	6,980.2	-2,189.6	1,999.0	2,678.8	2.63
9,745.0	90.44	162.97	6,979.5	-2,277.7	2,025.3	2,770.8	0.82
9,836.0	89.39	164.35	6,979.6	-2,365.0	2,050.9	2,861.8	1.91
9,928.0	89.53	163.75	6,980.5	-2,453.5	2,076.2	2,953.7	0.67
10,019.0	89.97	164.33	6,980.9	-2,541.0	2,101.2	3,044.7	0.80
10,113.0	90.40	165.47	6,980.6	-2,631.7	2,125.7	3,138.7	1.30
10,207.0	90.17	163.36	6,980.1	-2,722.2	2,151.0	3,232.6	2.26
10,301.0	89.77	163.41	6,980.2	-2,812.3	2,177.9	3,326.6	0.43
10,395.0	90.03	163.68	6,980.3	-2,902.5	2,204.5	3,420.6	0.40
10,489.0	90.44	164.73	6,979.9	-2,992.9	2,230.1	3,514.6	1.20
10,584.0	89.53	162.18	6,980.0	-3,084.0	2,257.1	3,609.6	2.85
10,678.0	89.50	162.13	6,980.8	-3,173.5	2,285.9	3,703.6	0.06



Company: Antero Resources
Project: Doddridge County WV
Site: Josie/Swisher/Union Pad
Well: Swisher Unit 1H
Wellbore: Original Wellpath
Design: As Drilled

Local Co-ordinate Reference: Well Swisher Unit 1H
TVD Reference: Swisher 1H 976 GL + 24 KB @ 1000.0usft
MD Reference: Swisher 1H 976 GL + 24 KB @ 1000.0usft
North Reference: Grid
Survey Calculation Method: Minimum Curvature
Database: Oklahoma District

Survey

MD (usft)	Inc (°)	Azi (azimuth) (°)	TVD (usft)	N/S (usft)	EW (usft)	V. Sec (usft)	DLeg (°/100usft)
10,772.0	89.90	162.43	6,981.3	-3,263.0	2,314.5	3,797.6	0.53
10,866.0	89.90	162.90	6,981.4	-3,352.7	2,342.5	3,891.6	0.50
10,960.0	90.10	163.03	6,981.4	-3,442.6	2,370.1	3,985.6	0.25
11,055.0	89.80	163.48	6,981.5	-3,533.6	2,397.5	4,080.6	0.57
11,149.0	89.83	163.85	6,981.8	-3,623.8	2,423.9	4,174.5	0.39
11,243.0	89.93	163.93	6,982.0	-3,714.1	2,450.0	4,268.5	0.14
11,337.0	89.97	162.98	6,982.1	-3,804.2	2,476.7	4,362.5	1.01
11,431.0	89.93	162.99	6,982.2	-3,894.1	2,504.2	4,456.5	0.04
11,525.0	89.93	163.10	6,982.3	-3,984.0	2,531.7	4,550.5	0.12
11,620.0	89.43	160.58	6,982.8	-4,074.2	2,561.3	4,645.5	2.70
11,714.0	89.23	160.06	6,983.9	-4,162.7	2,592.9	4,739.4	0.59
11,808.0	89.87	162.29	6,984.7	-4,251.7	2,623.3	4,833.3	2.47
11,902.0	89.83	162.93	6,984.9	-4,341.4	2,651.3	4,927.3	0.68
11,996.0	89.50	162.70	6,985.5	-4,431.2	2,679.1	5,021.3	0.43
12,090.0	89.53	162.83	6,986.2	-4,521.0	2,707.0	5,115.3	0.14
12,185.0	89.66	163.11	6,986.9	-4,611.8	2,734.8	5,210.3	0.32
12,279.0	89.43	163.24	6,987.7	-4,701.8	2,762.0	5,304.3	0.28
12,373.0	90.70	163.96	6,987.6	-4,792.0	2,788.5	5,398.3	1.55
12,467.0	90.67	163.47	6,986.4	-4,882.2	2,814.9	5,492.3	0.52
12,561.0	90.40	163.27	6,985.6	-4,972.3	2,841.8	5,586.3	0.36
12,655.0	89.46	161.58	6,985.7	-5,061.9	2,870.2	5,680.3	2.06
12,749.0	90.30	162.04	6,985.9	-5,151.2	2,899.5	5,774.3	1.02
12,843.0	90.30	161.77	6,985.4	-5,240.5	2,928.7	5,868.2	0.29
12,937.0	88.66	160.47	6,986.2	-5,329.5	2,959.1	5,962.2	2.23
13,031.0	88.56	160.80	6,988.5	-5,418.1	2,990.3	6,056.1	0.37
13,125.0	89.13	162.11	6,990.4	-5,507.2	3,020.2	6,150.0	1.52
13,219.0	89.10	161.86	6,991.9	-5,596.6	3,049.2	6,244.0	0.27
13,313.0	88.59	163.10	6,993.8	-5,686.2	3,077.5	6,338.0	1.43
13,407.0	88.49	163.17	6,996.1	-5,776.1	3,104.8	6,431.9	0.13
13,501.0	88.66	163.17	6,998.5	-5,866.1	3,132.0	6,525.9	0.18
13,594.0	90.27	165.07	6,999.4	-5,955.5	3,157.5	6,618.9	2.68
13,689.0	91.07	166.19	6,998.2	-6,047.5	3,181.0	6,713.8	1.45
13,782.0	89.56	162.71	6,997.7	-6,137.1	3,206.0	6,806.7	4.08
13,877.0	89.33	161.82	6,998.6	-6,227.6	3,234.9	6,901.7	0.97
13,971.0	89.16	163.29	6,999.9	-6,317.3	3,263.1	6,995.7	1.57
14,065.0	91.01	165.29	6,999.7	-6,407.7	3,288.5	7,089.7	2.90
14,159.0	91.31	165.20	6,997.8	-6,498.6	3,312.5	7,183.6	0.33
14,253.0	91.17	163.07	6,995.8	-6,589.0	3,338.1	7,277.5	2.27
14,347.0	91.14	162.93	6,993.9	-6,678.9	3,365.6	7,371.5	0.15
14,441.0	91.48	163.94	6,991.8	-6,769.0	3,392.4	7,465.5	1.13
14,536.0	91.07	162.40	6,989.7	-6,859.9	3,419.9	7,560.5	1.68
14,630.0	89.43	163.12	6,989.2	-6,949.6	3,447.8	7,654.4	1.91
14,724.0	90.70	163.32	6,989.1	-7,039.6	3,474.9	7,748.4	1.37
14,818.0	90.22	163.72	6,988.4	-7,129.8	3,501.6	7,842.4	0.66



Company: Antero Resources
Project: Doddridge County WV
Site: Josie/Swisher/Union Pad
Well: Swisher Unit 1H
Wellbore: Original Wellpath
Design: As Drilled

Local Co-ordinate Reference: Well Swisher Unit 1H
TVD Reference: Swisher 1H 976 GL + 24 KB @ 1000.0usft
MD Reference: Swisher 1H 976 GL + 24 KB @ 1000.0usft
North Reference: Grid
Survey Calculation Method: Minimum Curvature
Database: Oklahoma District

Survey

MD (usft)	Inc (°)	Azi (azimuth) (°)	TVD (usft)	N/S (usft)	E/W (usft)	V. Sec (usft)	DLeg (°/100usft)
14,912.0	89.97	163.40	6,988.2	-7,219.9	3,528.2	7,936.4	0.43
15,006.0	90.54	162.67	6,987.8	-7,309.8	3,555.6	8,030.4	0.99
15,101.0	90.54	162.02	6,986.9	-7,400.4	3,584.4	8,125.4	0.68
15,195.0	90.47	162.05	6,986.1	-7,489.8	3,613.4	8,219.4	0.08
15,289.0	89.66	160.93	6,986.0	-7,578.9	3,643.2	8,313.4	1.47
15,383.0	89.30	161.38	6,986.8	-7,667.9	3,673.6	8,407.3	0.61
15,477.0	90.27	161.98	6,987.2	-7,757.1	3,703.2	8,501.3	1.21
15,543.0	90.30	162.00	6,986.9	-7,819.9	3,723.6	8,567.3	0.05
15,621.0	90.50	162.42	6,986.3	-7,894.1	3,747.4	8,645.3	0.60

Design Annotations

Measured Depth (usft)	Vertical Depth (usft)	Local Coordinates		Comment
		+N/-S (usft)	+E/-W (usft)	
6,919.0	6,684.6	237.2	1,059.0	Middlesex
7,106.0	6,822.4	166.9	1,161.6	Burkett
7,161.0	6,856.3	135.0	1,190.9	Tully
7,401.0	6,951.3	-50.0	1,306.4	Marcellus

Checked By: _____ Approved By: _____ Date: _____

RECEIVED
 JUN 08 2015
 WV GEOLOGICAL SURVEY
 MORGANTOWN, WV