


4701706494

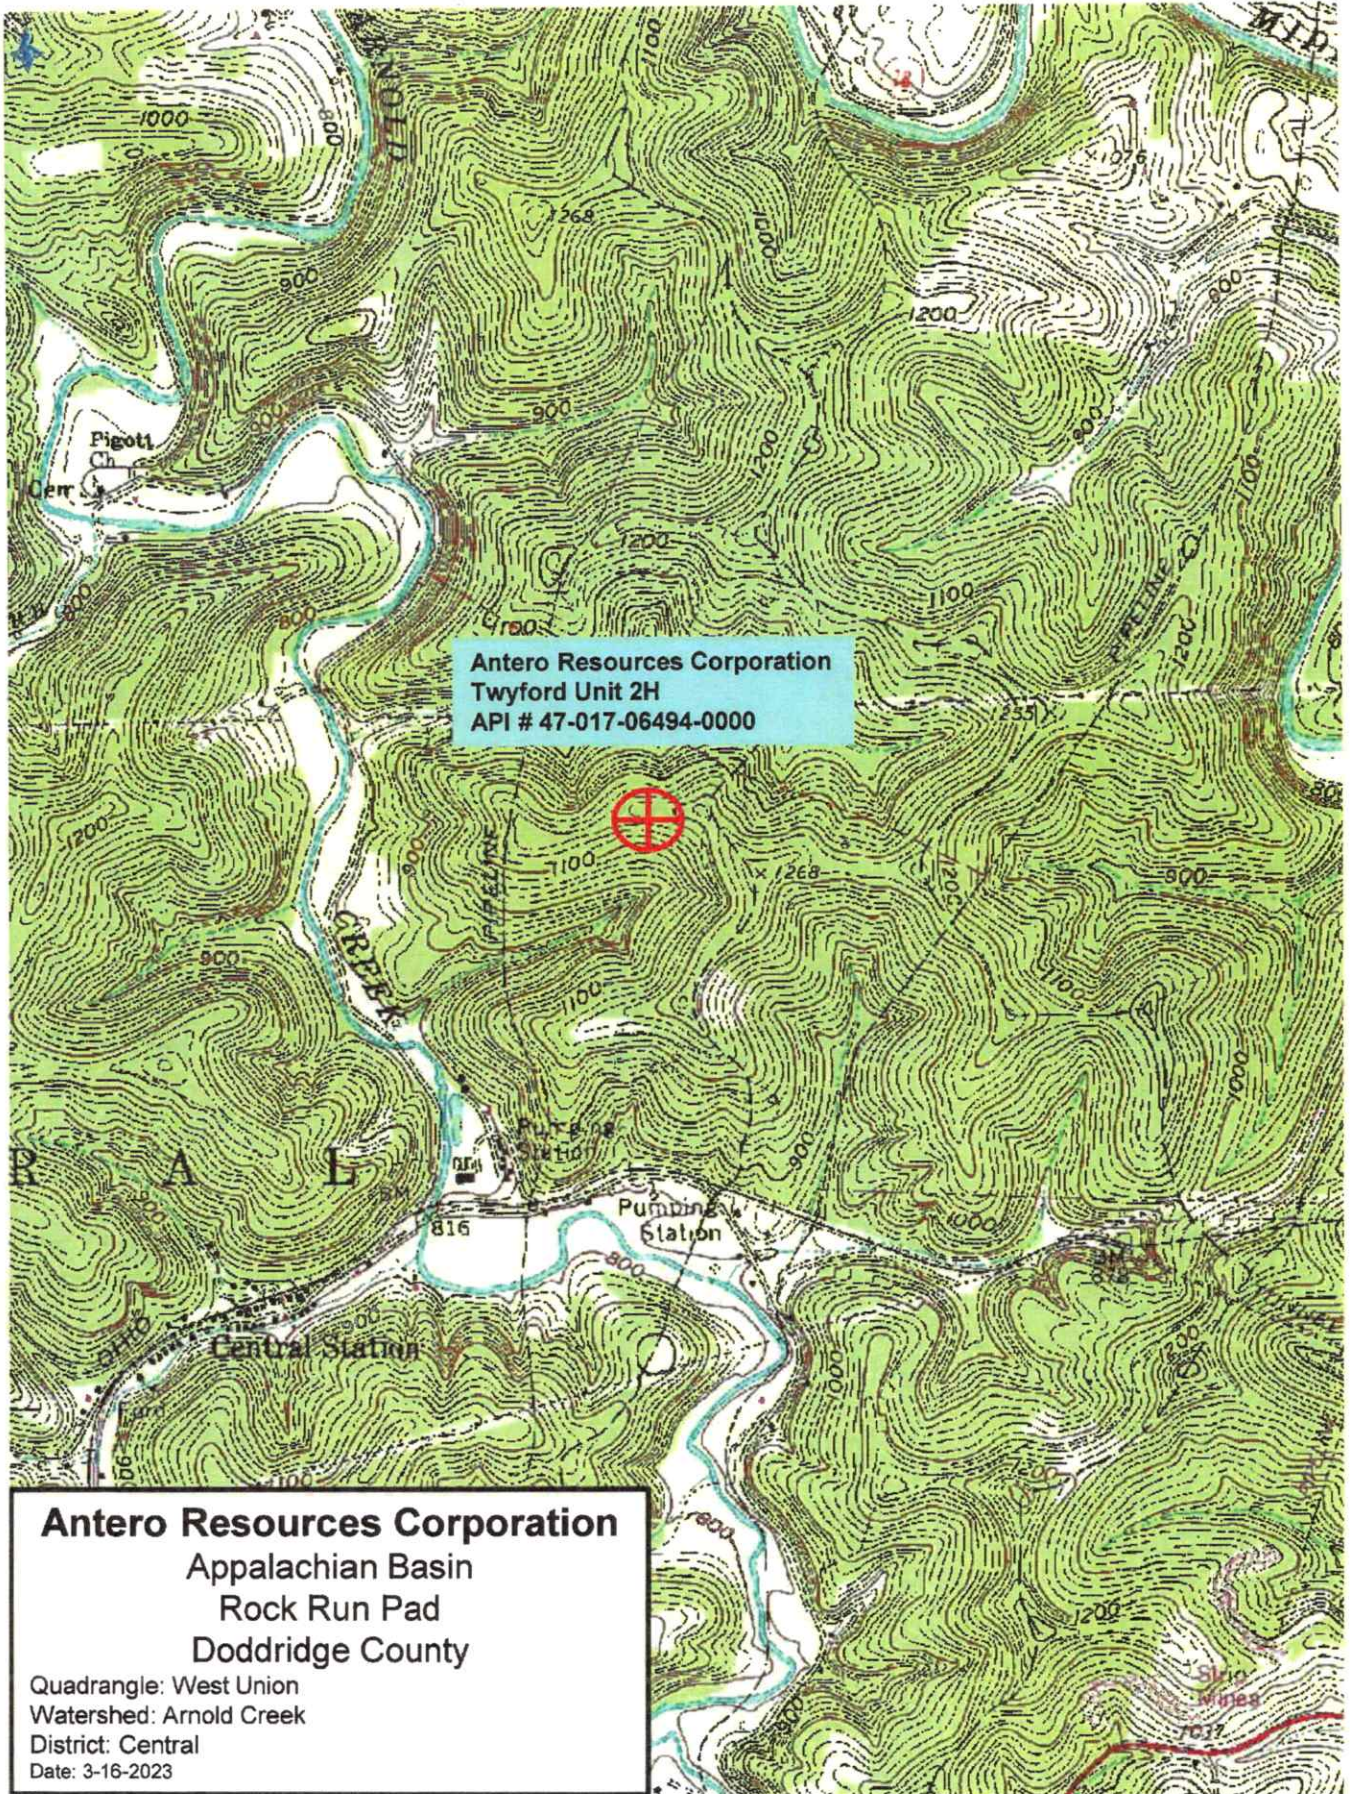

Antero Resources Corporation
Twyford Unit 2H
API # 47-017-06494-0000

Antero Resources Corporation
Appalachian Basin
Rock Run Pad
Doddridge County

Quadrangle: West Union
Watershed: Arnold Creek
District: Central
Date: 3-16-2023

04/21/2023

WW-7
8-30-06



West Virginia Department of Environmental Protection
Office of Oil and Gas

WELL LOCATION FORM: GPS

API: 47-017-06494 WELL NO.: Twyford 2H
 FARM NAME: Rock Run
 RESPONSIBLE PARTY NAME: Antero Resources Corporation
 COUNTY: Doddridge DISTRICT: Central
 QUADRANGLE: West Union
 SURFACE OWNER: George D. Lambert
 ROYALTY OWNER: _____
 UTM GPS NORTHING: 4350634.52m
 UTM GPS EASTING: 515969.76m GPS ELEVATION: 1171.1 ft

The Responsible Party named above has chosen to submit GPS coordinates in lieu of preparing a new well location plat for a plugging permit or assigned API number on the above well. The Office of Oil and Gas will not accept GPS coordinates that do not meet the following requirements:

1. Datum: NAD 1983, Zone: 17 North, Coordinate Units: meters, Altitude: height above mean sea level (MSL) – meters.
2. Accuracy to Datum – 3.05 meters
3. Data Collection Method:

Survey grade GPS : Post Processed Differential _____
 Real-Time Differential

Mapping Grade GPS : Post Processed Differential _____
 Real-Time Differential

4. Letter size copy of the topography map showing the well location.

I the undersigned, hereby certify this data is correct to the best of my knowledge and belief and shows all the information required by law and the regulations issued and prescribed by the Office of Oil and Gas.

M. J. Turner
Signature

Kevin M. Menger
Title

4/5/23
Date