

WW-7
8-30-06



West Virginia Department of Environmental Protection
Office of Oil and Gas

WELL LOCATION FORM: GPS

API: ~~47-017-71611~~ 47-017-06805 WELL NO.: 9

FARM NAME: Joseph Freeman

RESPONSIBLE PARTY NAME: Antero Resources Corporation

COUNTY: Doddridge DISTRICT: West Union

QUADRANGLE: West Union

SURFACE OWNER: John P. Strickling, Et Al

ROYALTY OWNER: N/A

UTM GPS NORTHING: 4353705.63 m

UTM GPS EASTING: 518591.42 m GPS ELEVATION: 315.2 m (1034')

The Responsible Party named above has chosen to submit GPS coordinates in lieu of preparing a new well location plat for a plugging permit or assigned API number on the above well. The Office of Oil and Gas will not accept GPS coordinates that do not meet the following requirements:

1. Datum: NAD 1983, Zone: 17 North, Coordinate Units: meters, Altitude: height above mean sea level (MSL) – meters.
2. Accuracy to Datum – 3.05 meters
3. Data Collection Method:

Survey grade GPS _____: Post Processed Differential _____

Real-Time Differential _____

Mapping Grade GPS _____: Post Processed Differential _____

Real-Time Differential _____


4. **Letter size copy of the topography map showing the well location.**

I the undersigned, hereby certify this data is correct to the best of my knowledge and belief and shows all the information required by law and the regulations issued and prescribed by the Office of Oil and Gas.

Mallory Stanton
Signature
Mallory Stanton

Permitting Supervisor
Title

1/23/17
Date

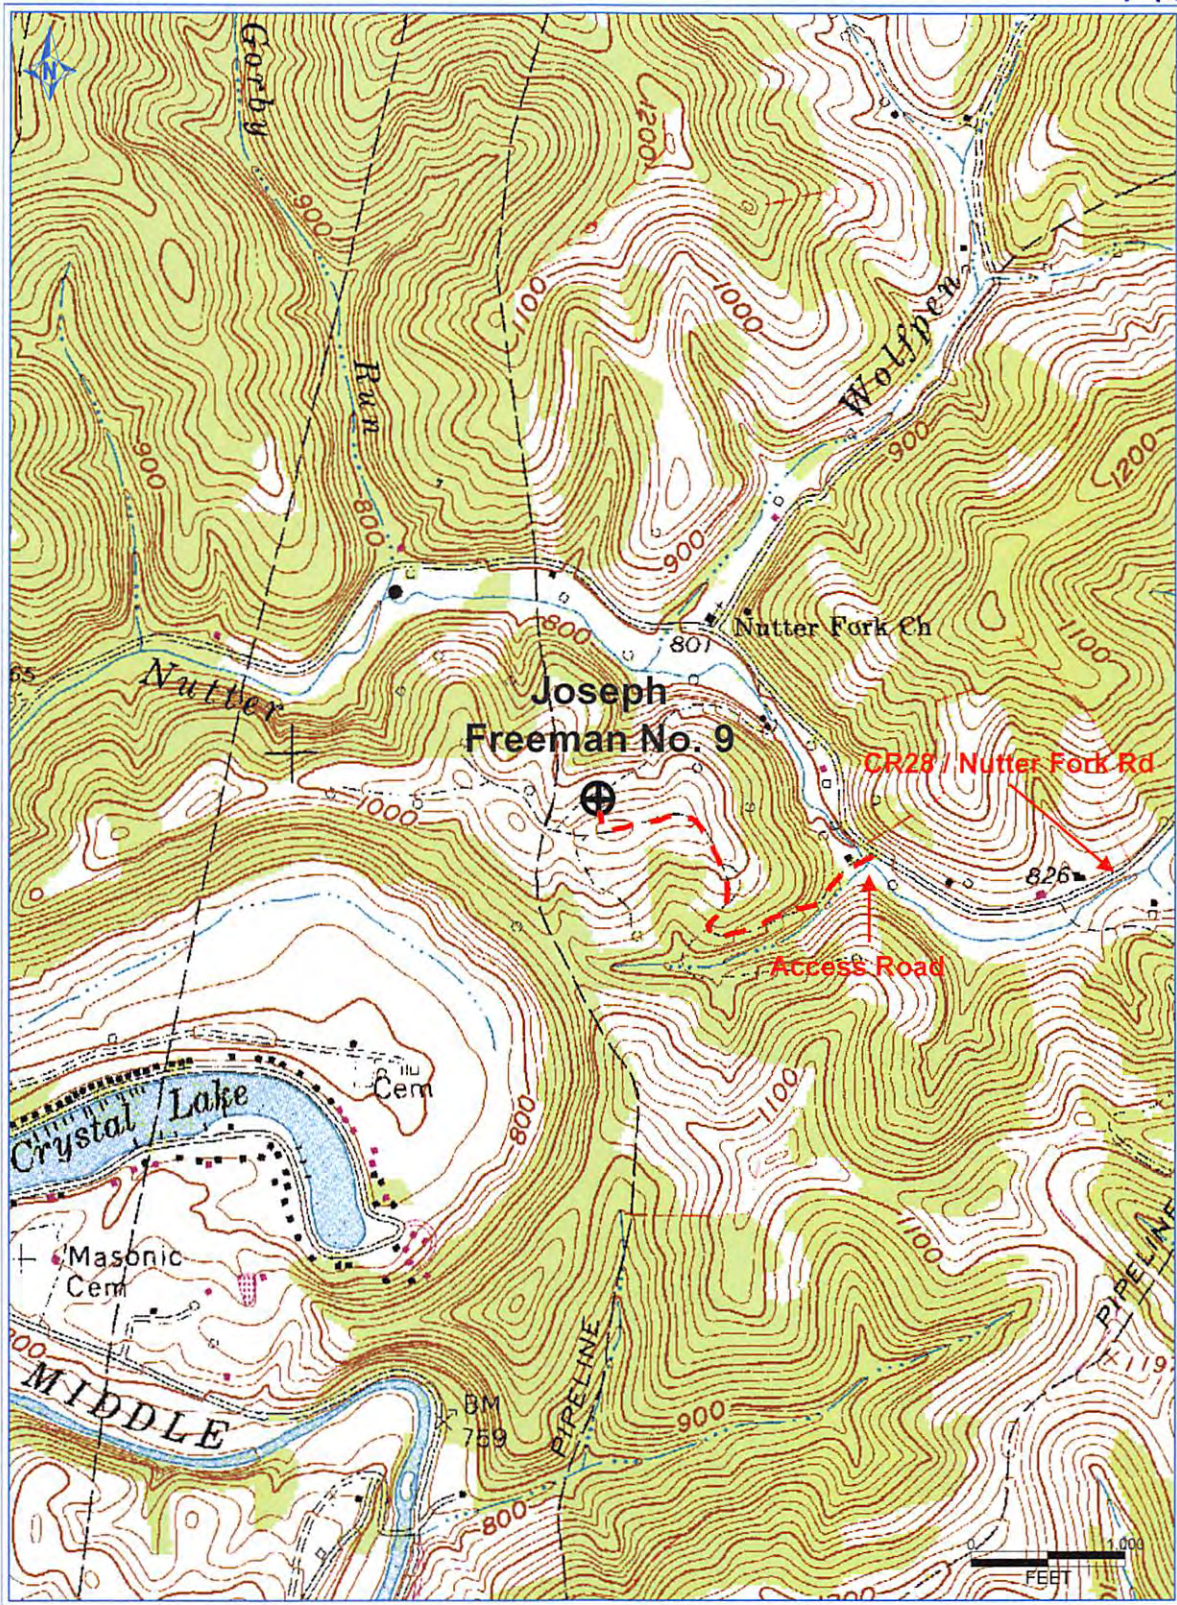

Antero Resources Corporation

Appalachian Basin
Joseph Freeman No 9
Doddridge County

Quadrangle: West Union
Watershed: Nutter Fork
District: West Union
Date: 01-05-2017

RECEIVED
Office of Oil and Gas
JAN 24 2017
WV Department of
Environmental Protection
03/10/2017