

LATITUDE 39°12'30"

11,728'

LATITUDE 39°15'00"

7,111' TO BOTTOM HOLE

Antero Resources
Corporation
Well No. Farley #2H


AS DRILLED DATA:
WELL 2H TOP HOLE INFORMATION:
N: 249,754ft E: 1,622,108ft
LAT: 39°10'40.89" LON: 80°49'58.93"
BOTTOM HOLE INFORMATION:
N: 261,523ft E: 1,615,087ft
LAT: 39°12'36.16" LON: 80°51'30.35"
WEST VIRGINIA COORDINATE
SYSTEM OF 1927 NORTH ZONE.
ZONE WAS DERIVED FROM
MEASUREMENTS TAKEN WITH
TRIMBLE GEOXT SUBMETER
MAPPING GRADE GPS UNIT.
PLAT ORIENTATION, CORNER,
AND WELL REFERENCE TIE LINES
ARE BASED ON GRID NORTH.

(NAD) 83 (UTM) ZONE 17 COORDS:
WELL 2H TOP HOLE INFORMATION:
N: 4,336,555m E: 514,436m
BOTTOM HOLE INFORMATION:
N: 4,340,105m E: 512,237m

(NAD) 27 (UTM) ZONE 17 COORDS:
WELL 2H TOP HOLE INFORMATION:
N: 14,226,800ft E: 1,687,732ft
POINT OF ENTRY INFORMATION:
N: 14,226,888ft E: 1,685,346ft
BOTTOM HOLE INFORMATION:
N: 14,238,446ft E: 1,680,518ft

SOUTHWEST DIST. DODDRIDGE CO.
1-1 JEFFREY POLAN
4-2 CEVASCO FAMILY TRUST
4-4 JUANITA LEGGETT
4-5 I L MORRIS
4-18 JAMES WEBB
4-19 DANA HURST
4-19.6 THERON SWICK
4-19.7 JAMES WEBB
4-19.8 JAMES WEBB
4-19.9 JAMES WEBB
4-21 ANTHONY AYERS
4-24 I L MORRIS
4-26 ANTHONY AYERS
4-27 ANTHONY AYERS
4-28 STEVEN SMITH
4-28.1 STANLEY WEBB
4-28.2 DEPT. OF HIGHWAYS
4-28.3 CHRIS FARLEY
4-30 RICHARD PARSONS
4-31 VICKI MOORE
4-32 JOHN HEWINS
4-32.1 NICOLAS WEBB
4-33 TINA OSBORNE
8-01 RICHARD BROWN
8-03 RANDALL RUSSELL
8-04 JOHN GRAY HRS.
8-05 LARRY GANDER
9-1.1 TINA OSBORNE
9-2.1 BRIAN PRIM
9-3.2 JUANITA LEGGETT
9-07 BRIAN PRIM
9-08 ROBERT LEE BROWNFIELD JR.
9-09 ANTERO RESOURCES CORP.
9-10 DELBERT OSBORNE
9-14 KERRY JUNKINS
9-15 ROBERT LEE BROWNFIELD JR.
12-01 DAVID BALL JR.
UNION DIST. RITCHIE CO.
15-05 LARRY GANDER

C1	MILDRED RIDDLE ET VIR
C2	MILDRED RIDDLE ET VIR
D	ANTHONY C. AYERS AND MELANIE H. AYERS
E	SHARON WICK
F	BRENT MAXWELL ET UX
G	W.L. STINESPRING ET UX
H1	D.W. GRAY AND M.E. GRAY
H2	D.W. GRAY AND M.E. GRAY
H3	D.W. GRAY AND M.E. GRAY
I1	OWEN T. WISE ET UX
I2	OWEN T. WISE ET UX
J1	SARAH D. SCOTT AND ROSCOE SCOTT
J2	SARAH D. SCOTT AND ROSCOE SCOTT
K	M.B. GRAY ET AL
M1	MARY ZINN
M2	MARY ZINN
N	E.W. OSBURN ET AL
Q	CHARLES J. DENNISON
R	DAVID DALE BALL ET UX
S	J. S. BRITTON ET UX
T	BILLIE L. BARTEE
U	N.H. LEGGETT ET AL
V	J. S. BRITTON ET UX

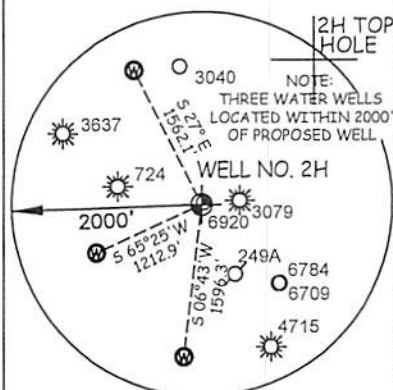


I THE UNDERSIGNED, HEREBY CERTIFY THAT THIS PLAT IS CORRECT TO THE BEST OF MY KNOWLEDGE AND BELIEF AND SHOWS ALL THE INFORMATION REQUIRED BY LAW AND THE RULES ISSUED AND PERSCRIBED BY THE DEPARTMENT OF ENVIRONMENTAL PROTECTION.



STATE OF WEST VIRGINIA, DIVISION
OF ENVIRONMENTAL PROTECTION,
OFFICE OF OIL AND GAS

WILLOW LAND SURVEYING PLLC
220 MASONIC AVE. PENNSBORO
WEST VIRGINIA 26415

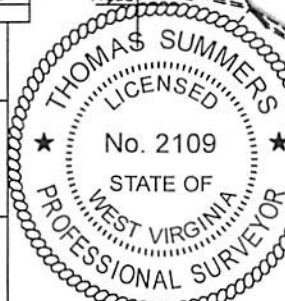

JOB # 23-019WA
DRAWING # FARLEY2HAD
SCALE 1" = 2000'
MINIMUM DEGREE OF
ACCURACY SUBMETER
PROVEN SOURCE OF ELEV.
SUBMETER MAPPING GRADE GPS

STATE OF WEST VIRGINIA
DEPARTMENT OF ENERGY
DIVISION OF OIL AND GAS

LEGEND

--- Surface Owner Boundary Lines +/-
--- Interior Surface Tracts +/-
○ --- Proposed Well Path
○ --- As Drilled Well Path

THOMAS SUMMERS P.S. 2109

DATE 7/23/25

OPERATOR'S WELL# FARLEY UNIT #2H

PAD LAYOUT



NOT TO
SCALE

NOTE
1. NO OCCUPIED DWELLINGS OR BUILDINGS TWO THOUSAND FIVE HUNDRED (2,500) SQUARE FEET OR LARGER USED TO HOUSE OR SHELTER DAIRY CATTLE OR POULTRY HUSBANDRY ARE LOCATED WITHIN SIX HUNDRED TWENTY-FIVE (625) FEET OF THE CENTER OF THE WELL PAD.
2. TOP HOLE DATA SHOWN HEREON WAS PROVIDED BY ANTERO RESOURCES CORPORATION.
3. AS DRILLED DATA WAS PROVIDED BY ANTERO RESOURCES CORPORATION.
4. WLS IS NOT CERTIFYING THE DATA AND INFORMATION PROVIDED LISTED IN NOTES 2 AND 3, ONLY THE RELATIONSHIP TO THE DATA AND INFORMATION PROVIDED TO THE LEASE BOUNDARIES.
5. WLS IS BY NO MEANS RESPONSIBLE FOR ANY ERRORS OR INACCURACIES WITH THE DATA AND INFORMATION THAT HAS BEEN PROVIDED.

WELL TYPE: OIL ☐ GAS ☒ LIQUID INJECTION ☐ WASTE DISPOSAL ☐ 47 - 017 - 06971
(IF "GAS") PRODUCTION ☒ STORAGE ☐ DEEP ☐ SHALLOW ☒ STATE COUNTY PERMIT
LOCATION: ELEVATION 1,100.5' - AS BUILT WATERSHED SOUTH FORK HUGHES RIVER
QUADRANGLE OXFORD 7.5' DISTRICT SOUTHWEST COUNTY DODDRIDGE
SURFACE OWNER ANTERO RESOURCES CORPORATION ACREAGE 59.74 ACRES +/- 01/23/2026
OIL & GAS ROYALTY OWNER E. W. OSBORNE ET AL LEASE ACREAGE 180 AC±

PROPOSED WORK: DRILL ☐ CONVERT ☐ DRILL DEEPER ☐ REDRILL ☐ FRACTURE OR STIMULATE
PLUG OFF OLD FORMATION ☐ PERFORATE NEW FORMATION ☐ OTHER PHYSICAL CHANGE IN WELL ☒
(SPECIFY) AS DRILLED PLUG & ABANDON CLEAN OUT & REPLUG
TARGET FORMATION MARCELLUS ESTIMATED DEPTH 6,612' TVD 19,671' MD
WELL OPERATOR ANTERO RESOURCES CORP. DESIGNATED AGENT CONRAD BASTON
ADDRESS 1615 WYNKOOP ST. ADDRESS 535 WHITE OAKS BLVD
FORM WW-6 DENVER, CO 80202 BRIDGEPORT, WV 26330

COUNTY NAME

PERMIT

As-Drilled

LATITUDE 39°12'30"

11,728'

LATITUDE 39°15'00"

7,111' TO BOTTOM HOLE

Antero Resources
Corporation
Well No. Farley #2H

AS DRILLED DATA:

WELL 2H TOP HOLE INFORMATION:

N: 249,754ft E: 1,622,108ft

LAT: 39°10'40.89" LON: 80°49'58.93"

BOTTOM HOLE INFORMATION:

N: 261,523ft E: 1,615,087ft

LAT: 39°12'36.16" LON: 80°51'30.35"

WEST VIRGINIA COORDINATE

SYSTEM OF 1927 NORTH ZONE.

ZONE WAS DERIVED FROM

MEASUREMENTS TAKEN WITH

TRIMBLE GEOXT SUBMETER

MAPPING GRADE GPS UNIT.

PLAT ORIENTATION, CORNER,

AND WELL REFERENCE TIE LINES

ARE BASED ON GRID NORTH.

(NAD) 83 (UTM) ZONE 17 COORDS:

WELL 2H TOP HOLE INFORMATION:

N: 4,336,555m E: 514,436m

BOTTOM HOLE INFORMATION:

N: 4,340,105m E: 512,237m

(NAD) 27 (UTM) ZONE 17 COORDS:

WELL 2H TOP HOLE INFORMATION:

N: 14,226,800ft E: 1,687,732ft

POINT OF ENTRY INFORMATION:

N: 14,226,888ft E: 1,685,346ft

BOTTOM HOLE INFORMATION:

N: 14,238,446ft E: 1,680,518ft

SOUTHWEST DIST. DODDRIDGE CO.

1-1 JEFFREY POLAN

4-2 CEVASCO FAMILY TRUST

4-4 JUANITA LEGGETT

4-5 I.L. MORRIS

4-18 JAMES WEBB

4-19 DANA HURST

4-19.6 THERON SWICK

4-19.7 JAMES WEBB

4-19.8 JAMES WEBB

4-19.9 JAMES WEBB

4-21 ANTHONY AYERS

4-24 I.L. MORRIS

4-26 ANTHONY AYERS

4-27 ANTHONY AYERS

4-28 STEVEN SMITH

4-28.1 STANLEY WEBB

4-28.2 DEPT. OF HIGHWAYS

4-28.3 CHRIS FARLEY

4-30 RICHARD PARSONS

4-31 VICKI MOORE

4-32 JOHN HEWINS

4-32.1 NICOLAS WEBB

4-33 TINA OSBORNE

8-01 RICHARD BROWN

8-03 RANDALL RUSSELL

8-04 JOHN GRAY HRS.

8-05 LARRY GANDER

9-11 TINA OSBORNE

9-21 BRIAN PRIM

9-3.2 JUANITA LEGGETT

9-07 BRIAN PRIM

9-08 ROBERT LEE BROWNFIELD JR.

9-09 ANTERO RESOURCES CORP.

9-10 DELBERT OSBORNE

9-14 KERRY JUNKINS

9-15 ROBERT LEE BROWNFIELD JR.

12-01 DAVID BALL JR.

UNION DIST. RITCHIE CO.

15-05 LARRY GANDER


C1	MILDRED RIDDLE ET VIR
C2	MILDRED RIDDLE ET VIR
D	ANTHONY C. AYERS AND MELANIE H. AYERS
E	SHARON WICK
F	BRENT MAXWELL ET UX
G	W.L. STINESPRING ET UX
H1	D.W. GRAY AND M.E. GRAY
H2	D.W. GRAY AND M.E. GRAY
H3	D.W. GRAY AND M.E. GRAY
I1	OWEN T. WISE ET UX
I2	OWEN T. WISE ET UX
J1	SARAH D. SCOTT AND ROSCOE SCOTT
J2	SARAH D. SCOTT AND ROSCOE SCOTT
K	M.B. GRAY ET AL
M1	MARY ZINN
M2	MARY ZINN
N	E.W. OSBURN ET AL
Q	CHARLES J. DENNISON
R	DAVID DALE BALL ET UX
S	J. S. BRITTON ET UX
T	BILLIE L. BARTEE
U	N.H. LEGGETT ET AL
V	J. S. BRITTON ET UX

14,553' TO BOTTOM HOLE

11,039'

LONGITUDE 80°50'00"

LONGITUDE 80°47'30"

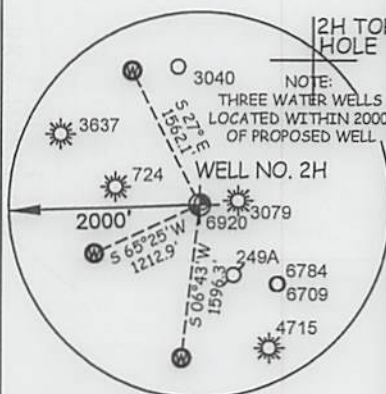

2H TOP HOLE

NOTE:

THREE WATER WELLS

LOCATED WITHIN 2000'


OF PROPOSED WELL

I THE UNDERSIGNED, HEREBY CERTIFY THAT THIS PLAT IS CORRECT TO THE BEST OF MY KNOWLEDGE AND BELIEF AND SHOWS ALL THE INFORMATION REQUIRED BY LAW AND THE RULES ISSUED AND PERSCRIBED BY THE DEPARTMENT OF ENVIRONMENTAL PROTECTION.



STATE OF WEST VIRGINIA, DIVISION
OF ENVIRONMENTAL PROTECTION,
OFFICE OF OIL AND GAS

WILLOW LAND SURVEYING PLLC
220 MASONIC AVE. PENNSBORO
WEST VIRGINIA 26415

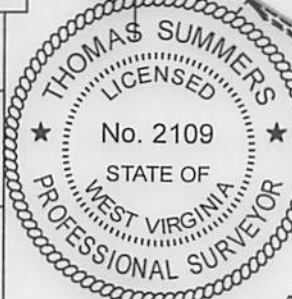

JOB # 23-019WA

DRAWING # FARLEY2HAD

SCALE 1" = 2000'

MINIMUM DEGREE OF

ACCURACY SUBMETER

PROVEN SOURCE OF ELEV.

SUBMETER MAPPING GRADE GPS

STATE OF WEST VIRGINIA

DEPARTMENT OF ENERGY

DIVISION OF OIL AND GAS

LEGEND

- Surface Owner Boundary Lines +/-
- - - Interior Surface Tracts +/-
- Proposed Well Path
- As Drilled Well Path

THOMAS SUMMERS P.S. 2109

DATE 7/23/25

OPERATOR'S WELL# FARLEY UNIT #2H

PAD LAYOUT



NOT TO SCALE

1. NO OCCUPIED DWELLINGS OR BUILDINGS TWO THOUSAND FIVE HUNDRED (2,500) SQUARE FEET OR LARGER USED TO HOUSE OR SHELTER DAIRY CATTLE OR POULTRY HUSBANDRY ARE LOCATED WITHIN SIX HUNDRED TWENTY-FIVE (625) FEET OF THE CENTER OF THE WELL PAD.
2. TOP HOLE DATA SHOWN HEREIN WAS PROVIDED BY ANTERO RESOURCES CORPORATION.
3. AS DRILLED DATA WAS PROVIDED BY ANTERO RESOURCES CORPORATION.
4. WLS IS NOT CERTIFYING THE DATA AND INFORMATION PROVIDED LISTED IN NOTES 2 AND 3, ONLY THE RELATIONSHIP TO THE DATA AND INFORMATION PROVIDED TO THE LEASE BOUNDARIES.
5. WLS IS BY NO MEANS RESPONSIBLE FOR ANY ERRORS OR INACCURACIES WITH THE DATA AND INFORMATION THAT HAS BEEN PROVIDED.

WELL TYPE: OIL ☐ GAS ☒ LIQUID INJECTION ☐ WASTE DISPOSAL ☐ 47 -- 017 -- 06971
(IF "GAS") PRODUCTION ☒ STORAGE ☐ DEEP ☐ SHALLOW ☒ STATE COUNTY PERMIT
LOCATION: ELEVATION 1,100.5' - AS BUILT WATERSHED SOUTH FORK HUGHES RIVER
QUADRANGLE OXFORD 7.5 DISTRICT SOUTHWEST COUNTY DODDRIDGE
SURFACE OWNER ANTERO RESOURCES CORPORATION ACREAGE 59.74 ACRES +/- 01/23/2026
OIL & GAS ROYALTY OWNER E.W. OSBORNE ET AL LEASE ACREAGE 180 AC±

PROPOSED WORK: DRILL ☐ CONVERT ☐ DRILL DEEPER ☐ REDRILL ☐ FRACTURE OR STIMULATE
PLUG OFF OLD FORMATION ☐ PERFORATE NEW FORMATION ☐ OTHER PHYSICAL CHANGE IN WELL ☒
(SPECIFY) AS DRILLED PLUG & ABANDON CLEAN OUT & REPLUG
TARGET FORMATION MARCELLUS ESTIMATED DEPTH 6,612' TVD 19,671' MD
WELL OPERATOR ANTERO RESOURCES CORP. DESIGNATED AGENT CONRAD BASTON
ADDRESS 1615 WYNKOOP ST. ADDRESS 535 WHITE OAKS BLVD
FORM WW-6 DENVER, CO 80202 BRIDGEPORT, WV 26330

COUNTY NAME PERMIT