

**Antero Resources
Well No. Dodrill 1H
As-Drilled
Antero Resources Corporation**

Page 1 of 2



Top Hole Coordinates, As-drilled data, and information was provided by Antero Resources Corporation. Allegany Surveys Inc. (ASI) is not certifying the data and information provided. ASI is not responsible for any errors or inaccuracies with the data and information that has been provided.

I, the undersigned, hereby certify that this plat is correct to the best of my knowledge and belief and shows all the information required by law and the rules issued and prescribed by the Department of Environmental Protection.

Bradley D. Miller, P.S. 2167



As-Drilled Well No. Dodrill Unit 1H

47-017-02258

47-017-30466

47-017-02227

47-017-03996

47-017-01016

47-017-05155

47-017-03106

47-017-01016

47-017-03106

47-017-03106

5,381' to Top Hole
1,380' to Bottom Hole
TOP HOLE LATITUDE 39 - 25 - 00
BTM HOLE LATITUDE 39 - 22 - 30


Notes
West Virginia Coordinate System of 1927, North Zone based upon Differential GPS Measurements.
Well No. Dodrill Unit 1H Top Hole coordinates are
N: 324,448.56' Latitude: 39°23'05.03"
E: 1,664,865.24' Longitude: 80°41'08.54"
Bottom Hole coordinates are
N: 312,971.42' Latitude: 39°21'12.10"
E: 1,668,717.30' Longitude: 80°40'17.57"
UTM Zone 17, NAD 1983
Top Hole Coordinates Bottom Hole Coordinates
N: 4,359,528.439m N: 4,356,051.478m
E: 527,082.621m E: 528,314.496m
Plat orientation and corner and well references are based upon the grid north meridian.
Well location references are based upon the magnetic meridian.

LONGITUDE 80 - 40 - 00
7,882' to Bottom Hole
11,632' to Top Hole




Notes:
Well No. Dodrill Unit 1H As-Drilled POE Coordinates
WV Coordinate System of 1927, North Zone
N: 324,456.20'
E: 1,665,013.70'
Lat: 39°23'05.13"
Lon: 80°41'06.65"
UTM Zone 17, NAD 1983
N: 4,359,531.524m
E: 527,127.811m

	Bearing	Dist.
L1	S 81°22' E	2,040.7'
L2	S 27°30' W	560.3'
L3	S 79°08' W	816.9'
L4	N 67°00' W	1,013.4'

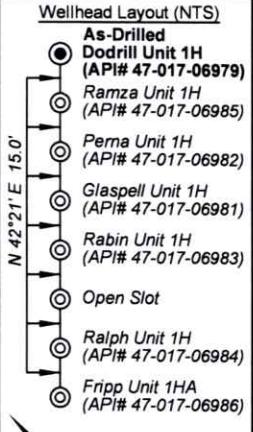

Note: 3 water wells were found within 2000' of proposed well. No occupied dwellings or buildings 2,500 square feet or larger used to house or shelter dairy cattle or poultry husbandry are located within 625' of the center of the well pad.

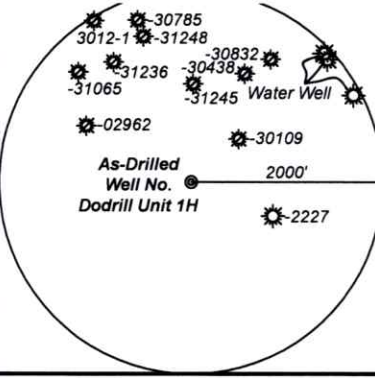

Legend

- Proposed gas well
- Monument, as noted
- Existing Well, as noted
- Digitized Well, as noted
- Creek or Drain
- Road
- Surface boundary (approx.)
- Interior surface tracts (approx.)

FILE NO: 259-30-M-23
DRAWING NO: Dodrill 1H As-Drilled
SCALE: 1" = 2000'
MINIMUM DEGREE OF ACCURACY: Submeter
PROVEN SOURCE OF ELEVATION: WVDOT, Harrisville, WV

STATE OF WEST VIRGINIA
DEPARTMENT OF ENVIRONMENTAL PROTECTION
OIL AND GAS DIVISION

DATE: October 17 20 25
OPERATOR'S WELL NO. Dodrill 1H
API WELL NO
47 - 017 - 06979
STATE COUNTY PERMIT

WELL TYPE: OIL GAS LIQUID INJECTION WASTE DISPOSAL
(IF GAS) PRODUCTION: STORAGE DEEP SHALLOW
LOCATION: ELEVATION: As-Built: 1,222' WATERSHED: McElroy Creek QUADRANGLE: Center Point
DISTRICT: McClellan COUNTY: Doddridge
SURFACE OWNER: Shawn A. Glaspell ACREAGE: 100
ROYALTY OWNER: Minda Allen LEASE NO: ACREAGE: 100
PROPOSED WORK: DRILL CONVERT DRILL DEEPER FRACTURE OR STIMULATE PLUG OFF OLD FORMATION
 PERFORATE NEW FORMATION OTHER PHYSICAL CHANGE IN WELL (SPECIFY) As-Drilled
 PLUG AND ABANDON CLEAN OUT AND REPLUG TARGET FORMATION: Marcellus Shale ESTIMATED DEPTH: 7,214' TVD 19,488' MD

WELL OPERATOR: Antero Resources Corporation DESIGNATED AGENT: Conrad Baston
ADDRESS: 1615 Wynkoop Street ADDRESS: 535 White Oaks Blvd.
Denver, CO 80202 Bridgeport, WV 26330



Leases	
A	Minda Allen
B	Morris Mountaineer Oil & Gas LLC
C	Shawn Gaspell
D	Johnnie Huy Rominger
E	CNX Gas Company, LLC
F	Acropolis, Inc.
G	AMP IV, LP
H	Cliff Wilson & Opal Willson
I	Brian A. Moreno & Diane P. Blanchette
J	Clyde Ford, III
K	Romona L. Clauson
L	Burnetta C. Hoskinson
M	Ollie M. Ford, et al
N	Roy Hoskinson & Faye Hoskinson
O	Peter Ash
P	Antero Minerals, LLC
Q	Arthur G. Doak, et ux
R	R. Clyde Roberts, et al
S	Mary A. Murphy Simons

ID	TM-Par	Owner	Bk/Pg	Acres
1	17-3.3	Shawn A. Gaspell	283/601	100.00
2	17-3.6	Shawn A. Gaspell	283/601	13.05
3	17-10	Kathryn Renee Blessing, et al	W39/506	48.50
4	17-3.2	Shawn A. Gaspell	283/601	135.00
5	17-3.4	Shawn A. Gaspell	283/601	17.50
6	17-18	Faith L. Fry	238/167	80.14
7	17-19	Shawn A. Gaspell	372/215	13.82
8	17-20	Shawn A. Gaspell	372/215	12.07
9	17-25	Shawn A. Gaspell	372/215	7.89
10	17-21	Patrick M. MacMillan	379/615	30.69
11	22-2	Timothy C. Pitts	W100/240	45.13
12	22-3	Timothy C. Pitts	W100/240	29.89
13	22-4	Debra Mellott	249/417	17.50
14	22-3.1	George D. Payton & Donald V. Sandstrom	236/354	24.11
15	23-8	Steven R. Chipps & Nathaniel Hoskinson	432/200	40.99
16	6-16	Brian A. Moreno & Diane P. Blanchette	389/382	104.80
17	22-6	Robert F. & Deborah C. Fetty	304/421	1.30
18	22-5	Jerry W. Harman	282/436	27.00
19	23-12	Jerry W. Harman	282/436	73.00
20	6-17	Clyde M. Ford III	234/474	65.6
21	7-1	Steven M. & Mary Ellen Perna	286/506	132.54
22	7-5	David A. Hoskinson	168/787	10.23

FILE NO: 259-30-M-23
 DRAWING NO: Dodrill 1H As-Drilled
 SCALE: 1" = 2000'
 MINIMUM DEGREE OF ACCURACY: Submeter
 PROVEN SOURCE OF ELEVATION: WVDOT, Harrisville, WV

STATE OF WEST VIRGINIA
 DEPARTMENT OF ENVIRONMENTAL PROTECTION
OIL AND GAS DIVISION



DATE: October 17 20 25
 OPERATOR'S WELL NO. Dodrill 1H
API WELL NO
47 - 017 - 06979
 STATE COUNTY PERMIT

WELL TYPE: OIL GAS LIQUID INJECTION WASTE DISPOSAL
 (IF GAS) PRODUCTION: STORAGE DEEP SHALLOW
 LOCATION: ELEVATION: As-Built: 1,222' WATERSHED: McElroy Creek QUADRANGLE: Center Point
 DISTRICT: McClellan COUNTY: Doddridge
 SURFACE OWNER: Shawn A. Gaspell ACREAGE: 100
 ROYALTY OWNER: Minda Allen LEASE NO: _____ ACREAGE: 100
 PROPOSED WORK: DRILL CONVERT DRILL DEEPER FRACTURE OR STIMULATE PLUG OFF OLD FORMATION
 PERFORATE NEW FORMATION OTHER PHYSICAL CHANGE IN WELL (SPECIFY) As-Drilled
 PLUG AND ABANDON CLEAN OUT AND REPLUG TARGET FORMATION: Marcellus Shale ESTIMATED DEPTH: 19,488' MD 7,214' TVD

WELL OPERATOR: Antero Resources Corporation DESIGNATED AGENT: Conrad Baston
 ADDRESS: 1615 Wynkoop Street ADDRESS: 535 White Oaks Blvd.
Denver, CO 80202 Bridgeport, WV 26330