

Antero Resources
Well No. Ramza 1H
As-Drilled
Antero Resources Corporation

Page 1 of 2




Top Hole Coordinates, As-drilled data, and information was provided by Antero Resources Corporation. Allegany Surveys Inc. (ASI) is not certifying the data and information provided. ASI is not responsible for any errors or inaccuracies with the data and information that has been provided.

I, the undersigned, hereby certify that this plat is correct to the best of my knowledge and belief and shows all the information required by law and the rules issued and prescribed by the Department of Environmental Protection.

Bradley D. Miller
 Bradley D. Miller, P.S. 2167



Note: 3 water wells were found within 2000' of proposed well. No occupied dwellings or buildings 2,500 square feet or larger used to house or shelter dairy cattle or poultry husbandry are located within 625' of the center of the well pad.

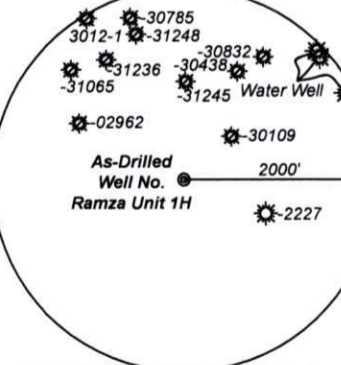

Legend

- Proposed gas well
- Monument, as noted
- Existing Well, as noted
- Digitized Well, as noted
- Creek or Drain
- Road
- Surface boundary (approx.)
- Interior surface tracts (approx.)


2,091' to Bottom Hole
 TOP HOLE LATITUDE 39 - 25 - 00
 BTM HOLE LATITUDE 39 - 22 - 30

Notes
 West Virginia Coordinate System of 1927, North Zone
 based upon Differential GPS Measurements.
 Well No. Ramza Unit 1H Top Hole coordinates are
 N: 324,437.63' Latitude: 39°23'04.92"
 E: 1,664,855.27' Longitude: 80°41'08.66"
 Bottom Hole coordinates are
 N: 312,381.79' Latitude: 39°21'06.18"
 E: 1,667,999.09' Longitude: 80°40'26.62"
 UTM Zone 17, NAD 1983
 Top Hole Coordinates Bottom Hole Coordinates
 N: 4,359,525.058m N: 4,355,868.190m
 E: 527,079.640m E: 528,098.680m
 Plat orientation and corner and well references are based upon the grid north meridian.
 Well location references are based upon the magnetic meridian.

Notes:
 Well No. Ramza Unit 1H As-Drilled POE Coordinates
 WV Coordinate System of 1927, North Zone
 N: 324,209.52'
 E: 1,664,220.73'
 Lat: 39°23'02.58"
 Lon: 80°41'16.70"
 UTM Zone 17, NAD 1983
 N: 4,359,452.334m
 E: 526,887.480m



	Bearing	Dist.
L1	S 81°01' E	2,032.6'
L2	S 27°53' W	574.6'
L3	S 78°31' W	828.8'
L4	N 67°47' W	1,018.4'

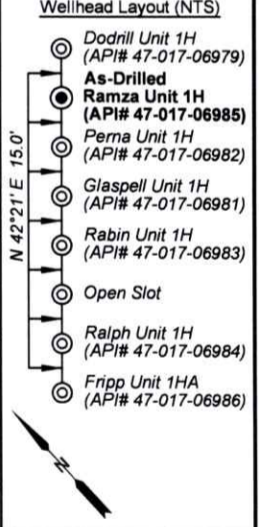

FILE NO: 266-30-M-22
 DRAWING NO: Ramza 1H As-Drilled
 SCALE: 1" = 2000'
 MINIMUM DEGREE OF ACCURACY: Submeter
 PROVEN SOURCE OF ELEVATION: WVDOT, Harrisville, WV

STATE OF WEST VIRGINIA
 DEPARTMENT OF ENVIRONMENTAL PROTECTION
OIL AND GAS DIVISION

DATE: October 17 20 25
 OPERATOR'S WELL NO. Ramza 1H
 API WELL NO
 47 - 017 - 06985
 STATE COUNTY PERMIT

WELL TYPE: OIL GAS LIQUID INJECTION WASTE DISPOSAL
 (IF GAS) PRODUCTION: STORAGE DEEP SHALLOW

LOCATION: ELEVATION: As-Built: 1,222' WATERSHED: McElroy Creek QUADRANGLE: Center Point
 DISTRICT: McClellan Shawn A. COUNTY: Doddridge
 SURFACE OWNER: Glaspell ACREAGE: 100
 ROYALTY OWNER: Minda Allen LEASE NO: ACREAGE: 100

PROPOSED WORK: DRILL CONVERT DRILL DEEPER FRACTURE OR STIMULATE PLUG OFF OLD FORMATION
 PERFORATE NEW FORMATION OTHER PHYSICAL CHANGE IN WELL (SPECIFY) As-Drilled
 PLUG AND ABANDON CLEAN OUT AND REPLUG TARGET FORMATION: Marcellus Shale ESTIMATED DEPTH: 7,188' TVD 19,926' MD

WELL OPERATOR: Antero Resources Corporation DESIGNATED AGENT: Conrad Baston
 ADDRESS: 1615 Wynkoop Street ADDRESS: 535 White Oaks Blvd.
 Denver, CO 80202 Bridgeport, WV 26330

09/13/2026



Leases	
A	Minda Allen
B	Thomas H. Downs
C	Morris Mountaineer Oil & Gas, LLC
D	Robert O. Hopkins
E	Arthur G. Doak, et al
F	Arthur G. Doak, et ux
G	Shawn Giaspell
H	Jonnie Huy Rominger
I	A. H. Low, et ux
J	CNX Gas Company, LLC
K	Acropolis, Inc.
L	CNX Gas Company, LLC
M	Cliff Wilson & Opal Wilson
N	Brian A. Moreno & Diane P. Blanchette
O	Brenda V. Ney
P	Clyde M. Ford, III
Q	Romona L. Clauson
R	Mary A. Murphy Simons
S	Ollie M. Ford, et al
T	Kathleen E. Davis, et al
U	AMP IV, LP
V	Margaret J. & Martha A. McMillan
W	Roy Hoskinson & Faye Hoskinson

ID	TM-Par	Owner	Bk/Pg	Acres
1	17-3.3	Shawn A. Giaspell	283/601	100.00
2	17-3.2	Shawn A. Giaspell	283/601	135.00
3	17-13	Shawn A. Giaspell	468/444	65.00
4	17-16	Faith L. Fry	238/167	36.84
5	17-18.1	Faith L. & Michael Fry	342/340	19.50
6	17-18	Faith L. Fry	238/167	80.14
7	17-19	Shawn A. Giaspell	372/215	13.82
8	17-20	Shawn A. Giaspell	372/215	12.07
9	17-25	Shawn A. Giaspell	372/215	7.89
10	6-6	Duaine Doak, et al	WB31/416	50.00
11	17-21	Patrick M. MacMillan	379/615	30.69
12	22-1	Donald V. Sandstrom	266/650	34.63
13	22-2	Timothy C. Pitts	W100/240	45.13
14	6-11.1	Danny R. & Joyce A. Groover	301/149	44.94
15	6-11.2	Danny R. & Joyce A. Groover	301/149	0.64
16	6-11	Danny R. & Joyce A. Groover	301/149	47.30
17	22-3.1	George D. Payton & Donald V. Sandstrom	236/354	24.11
18	22-3	Timothy C. Pitts	W100/240	29.89
19	23-8	Steven R. Chipps & Nathaniel Hoskinson	432/200	40.99
20	22-6	Robert F. & Deborah C. Fetty	304/421	1.30
21	6-16	Brian A. Moreno & Diane P. Blanchette	389/382	104.80
22	22-5	Jerry W. Harman	282/436	27.00
23	6-17	Clyde M. Ford III	234/474	65.6
24	6-23	Werner F. Blei	272/340	52.50
25	7-1	Steven M. & Mary Ellen Perna	286/506	132.54
26	7-5	David A. Hoskinson	168/787	10.23
27	10-1	Josephine Donnahoe	WB31/4	23.14

FILE NO: 266-30-M-22
 DRAWING NO: Ramza 1H As-Drilled
 SCALE: 1" = 2000'
 MINIMUM DEGREE OF ACCURACY: Submeter
 PROVEN SOURCE OF ELEVATION: WVDOT, Harrisville, WV

STATE OF WEST VIRGINIA
 DEPARTMENT OF ENVIRONMENTAL PROTECTION
OIL AND GAS DIVISION



DATE: October 17 2025
 OPERATOR'S WELL NO. Ramza 1H
 API WELL NO
47 - 017 - 06985
 STATE COUNTY PERMIT

WELL TYPE: OIL GAS LIQUID INJECTION WASTE DISPOSAL
 (IF GAS) PRODUCTION: STORAGE DEEP SHALLOW

LOCATION: ELEVATION: As-Built: 1,222' WATERSHED: McElroy Creek QUADRANGLE: Center Point
 DISTRICT: McClellan COUNTY: Doddridge
 SURFACE OWNER: Shawn A. Giaspell ACREAGE: 100
 ROYALTY OWNER: Minda Allen LEASE NO: _____ ACREAGE: 100

PROPOSED WORK: DRILL CONVERT DRILL DEEPER FRACTURE OR STIMULATE PLUG OFF OLD FORMATION
 PERFORATE NEW FORMATION OTHER PHYSICAL CHANGE IN WELL (SPECIFY) As-Drilled
 PLUG AND ABANDON CLEAN OUT AND REPLUG TARGET FORMATION: Marcellus Shale ESTIMATED DEPTH: 19,926' MD ^{7,188' TVD}

WELL OPERATOR: Antero Resources Corporation DESIGNATED AGENT: Conrad Baston
 ADDRESS: 1615 Wynkoop Street ADDRESS: 535 White Oaks Blvd.
Denver, CO 80202 Bridgeport, WV 26330