


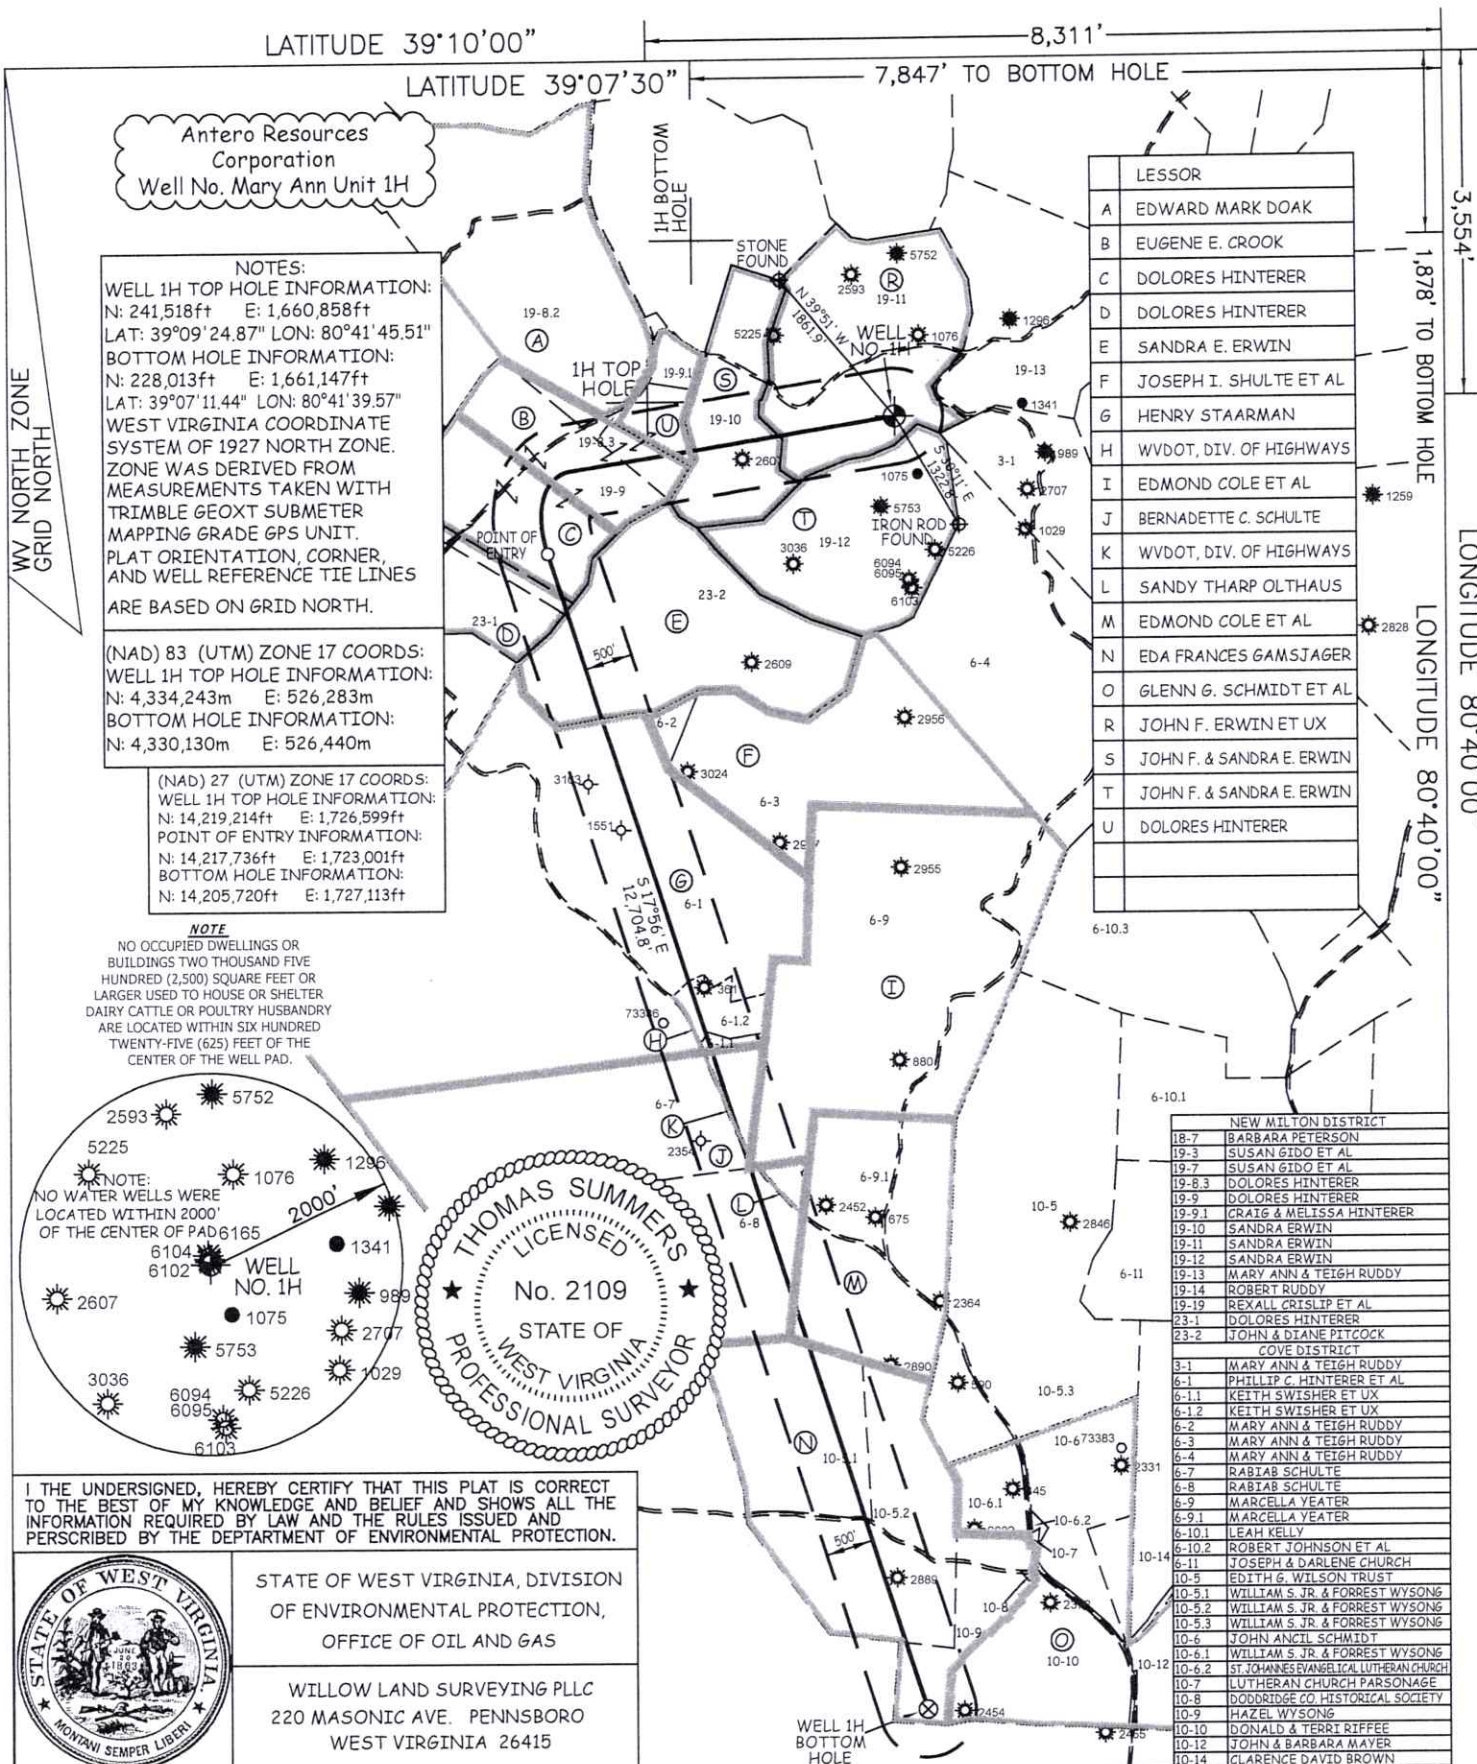

I THE UNDERSIGNED, HEREBY CERTIFY THAT THIS PLAT IS CORRECT TO THE BEST OF MY KNOWLEDGE AND BELIEF AND SHOWS ALL THE INFORMATION REQUIRED BY LAW AND THE RULES ISSUED AND PERSCRIBED BY THE DEPARTMENT OF ENVIRONMENTAL PROTECTION.

JOB # 25-015WA
DRAWING # MARYANN1H
SCALE 1" = 2000'
MINIMUM DEGREE OF ACCURACY SUBMETER
PROVEN SOURCE OF ELEV. SUBMETER MAPPING GRADE GPS

STATE OF WEST VIRGINIA
DEPARTMENT OF ENERGY
DIVISION OF OIL AND GAS

LEGEND
— Surface Owner Boundary Lines +/-
--- Adjoining Surface Tracts +/-
⊕ Found monument, as noted

THOMAS SUMMERS P.S. 2109
DATE 08/18/25
OPERATOR'S WELL# MARY ANN UNIT #1H

PAD LAYOUT
MARY ANN UNIT 1H
MARY ANN UNIT 2H
WYSONG UNIT 1H
WYSONG UNIT 2H
DIAL UNIT 1H
SHULTE UNIT 1H
HINTERER UNIT 2H
HINTERER UNIT 1H

NOT TO SCALE

REFERENCES
STAKE/NAIL, SET
WELL NO. 1H
N 58°36' E
205.8'
S 29°50' W
264.2'

STAKE/NAIL, SET
1" = 300'

WELL TYPE: OIL ☐ GAS ☒ LIQUID INJECTION ☐ WASTE DISPOSAL ☐
(IF "GAS") PRODUCTION ☒ STORAGE ☐ DEEP ☐ SHALLOW ☒
LOCATION: ELEVATION ASBUILT - 1,213' WATERSHED HEADWATERS MIDDLE ISLAND CREEK STATE COUNTY PERMIT
QUADRANGLE NEW MILTON 7.5' DISTRICT NEW MILTON COUNTY DODDRIDGE
SURFACE OWNER SANDRA E. ERWIN ACREAGE 104 ACRES +/-
OIL & GAS ROYALTY OWNER JOHN F. ERWIN ET UX LEASE ACREAGE 104 ACRES± 11/07/2025
PROPOSED WORK: DRILL ☐ CONVERT ☐ DRILL DEEPER ☒ REDRILL ☐ FRACTURE OR
STIMULATE ☒ PLUG OFF OLD FORMATION ☐ PERFORATE NEW FORMATION ☒
OTHER PHYSICAL CHANGE IN WELL (SPECIFY) MOD-BHL
PLUG & ABANDON ☐ CLEAN OUT & REPLUG ☐ ESTIMATED DEPTH 7,700' TVD 24,900' MD
TARGET FORMATION MARCELLUS
WELL OPERATOR ANTERO RESOURCES CORP.
ADDRESS 1615 WYNKOOP STREET
DENVER, CO 80202
DESIGNATED AGENT CONRAD BASTON
ADDRESS 535 WHITE OAK BLVD.
BRIDGEPORT, WV 26330

FORM WW-6