

-8,301'

5,886' TO BOTTOM HOLE

NOTES:
WELL 2H TOP HOLE INFORMATION:
N: 241.473ft E: 1,660,867ft
LAT: 39°09'24.44" LON: 80°41'45.38"
BOTTOM HOLE INFORMATION:
N: 229,987ft E: 1,663,134ft
LAT: 39°07'31.21" LON: 80°41'14.69"
WEST VIRGINIA COORDINATE
SYSTEM OF 1927 NORTH ZONE.
ZONE WAS DERIVED FROM
MEASUREMENTS TAKEN WITH
TRIMBLE GEOTX SUBMETER
MAPPING GRADE GPS UNIT.
PLAT ORIENTATION, CORNER,
AND WELL REFERENCE TIE LINES
ARE BASED ON GRID NORTH.

(NAD) 83 (UTM) ZONE 17 COORDS:
WELL 2H TOP HOLE INFORMATION:
N: 4,334,230m E: 526,286m
BOTTOM HOLE INFORMATION:
N: 4,330,742m E: 527,035m

(NAD) 27 (UTM) ZONE 17 COORDS:
WELL 2H TOP HOLE INFORMATION:
N: 14,219,170ft E: 1,726,609ft
POINT OF ENTRY INFORMATION:
N: 14,216,134ft E: 1,726,195ft
BOTTOM HOLE INFORMATION:
N: 14,207,727ft E: 1,729,066ft

NOTE
NO OCCUPIED DWELLINGS OR BUILDINGS TWO THOUSAND FIVE HUNDRED (2,500) SQUARE FEET OR LARGER USED TO HOUSE OR SHELTER DAIRY CATTLE OR POULTRY HUSBANDRY ARE LOCATED WITHIN SIX HUNDRED TWENTY-FIVE (625) FEET OF THE CENTER OF THE WELL PAD. \

RECEIVED
Office of Oil and Gas
OCT 16 2025 733
WV Department of
Environmental Protection

A circular seal for a professional surveyor. The outer ring contains the text "THOMAS SUMMERS" at the top and "PROFESSIONAL SURVEYOR" at the bottom, separated by two stars. The inner circle contains the text "LICENSED" at the top, "No. 2109" in the center, and "STATE OF WEST VIRGINIA" at the bottom.

I THE UNDERSIGNED, HEREBY CERTIFY THAT THIS PLAT IS CORRECT TO THE BEST OF MY KNOWLEDGE AND BELIEF AND SHOWS ALL THE INFORMATION REQUIRED BY LAW AND THE RULES ISSUED AND PERSCRIBED BY THE DEPARTMENT OF ENVIRONMENTAL PROTECTION.



STATE OF WEST VIRGINIA, DIVISION
OF ENVIRONMENTAL PROTECTION,
OFFICE OF OIL AND GAS

WILLOW LAND SURVEYING PLLC
220 MASONIC AVE. PENNSBORO
WEST VIRGINIA 26415

JOB # 25-011WA
DRAWING # WYSONG2H
SCALE 1" = 2000'
MINIMUM DEGREE OF
ACCURACY SUBMETER
PROVEN SOURCE OF ELEV.
SUBMETER MAPPING GRADE GPS

STATE OF WEST VIRGINIA
DEPARTMENT OF ENERGY
DIVISION OF OIL AND GAS

LEGEND

— — — Surface Owner Boundary Lines +/-
 — — — Adjoining Surface Tracts +/-
 Found monument, as noted

THOMAS SUMMERS P.S. 2109

DATE 08/18/25
OPERATOR'S WELL# WYSONG UNIT #2H

PAD LAYOUT

NOT TO

REFERENCES

MARY ANN UNIT 1H
15'
MARY ANN UNIT 2H
15'
WYSONG UNIT 1H
15'
WYSONG UNIT 2H
15'
DIAL UNIT 1H
15'
SHULTE UNIT 1H
20'
HINTERER UNIT 2H
10'
HINTERER UNIT 1H

1"=48' W

GRID NORTH

WELL TYPE: OIL	☐	GAS	☒	LIQUID INJECTION	☐	WASTE DISPOSAL	☐	API WELL #	47	-	017	-	06995
(IF "GAS") PRODUCTION	☒	STORAGE	☐	DEEP	☐	SHALLOW	☒						
LOCATION: ELEVATION	ASBUILT - 1,213'			WATERSHED	HEADWATERS MIDDLE ISLAND CREEK			STATE	COUNTY		PERMIT		
QUADRANGLE	NEW MILTON 7.5'			DISTRICT	NEW MILTON			COUNTY	DODDRIDGE				
SURFACE OWNER	SANDRA E. ERWIN					ACREAGE	104 ACRES +/-						
OIL & GAS ROYALTY OWNER	JOHN F. ERWIN ET UX					LEASE ACREAGE	104 ACRES±						
PROPOSED WORK: DRILL	☐	CONVERT	☐	DRILL DEEPER	☒	REDRILL	☐	FRACTURE OR					
STIMULATE	☒	PLUG OFF OLD FORMATION	☐	PERFORATE NEW FORMATION	☒								
OTHER PHYSICAL CHANGE IN WELL (SPECIFY)	MOD-BHL												
PLUG & ABANDON	☐	CLEAN OUT & REPLUG	☐	ESTIMATED DEPTH	7,700' TVD 20,200' MD								
TARGET FORMATION	MARCELLUS												
WELL OPERATOR	ANTERO RESOURCES CORP.					DESIGNATED AGENT	CONRAD BASTON						
ADDRESS	1615 WYNKOOP STREET					ADDRESS	535 WHITE OAK BLVD.						
	DENVER, CO 80202						BRIDGEPORT, WV 26330						

FORM WW-6

LATITUDE 39°10'00"

8,301'

LATITUDE 39°10'00" 5,886' TO BOTTOM HOLE



Antero Resources
Corporation
Well No. Wysong Unit 2H

NOTES:
WELL 2H TOP HOLE INFORMATION:
N: 241,473ft E: 1,660,867ft
LAT: 39°09'24.44" LON: 80°41'45.38"
BOTTOM HOLE INFORMATION:
N: 229,987ft E: 1,663,134ft
LAT: 39°07'31.21" LON: 80°41'14.69"
WEST VIRGINIA COORDINATE
SYSTEM OF 1927 NORTH ZONE.
ZONE WAS DERIVED FROM
MEASUREMENTS TAKEN WITH
TRIMBLE GEOXT SUBMETER
MAPPING GRADE GPS UNIT.
PLAT ORIENTATION, CORNER,
AND WELL REFERENCE TIE LINES
ARE BASED ON GRID NORTH.

(NAD) 83 (UTM) ZONE 17 COORDS:
WELL 2H TOP HOLE INFORMATION:
N: 4,334,230m E: 526,286m
BOTTOM HOLE INFORMATION:
N: 4,330,742m E: 527,035m

(NAD) 27 (UTM) ZONE 17 COORDS:
WELL 2H TOP HOLE INFORMATION:
N: 14,219,170ft E: 1,726,609ft
POINT OF ENTRY INFORMATION:
N: 14,216,134ft E: 1,726,195ft
BOTTOM HOLE INFORMATION:
N: 14,207,727ft E: 1,729,066ft

NOTE
NO OCCUPIED DWELLINGS OR
BUILDINGS TWO THOUSAND FIVE
HUNDRED (2,500) SQUARE FEET OR
LARGER USED TO HOUSE OR SHELTER
DAIRY CATTLE OR POULTRY HUSBANDRY
ARE LOCATED WITHIN SIX HUNDRED
TWENTY-FIVE (625) FEET OF THE
CENTER OF THE WELL PAD.

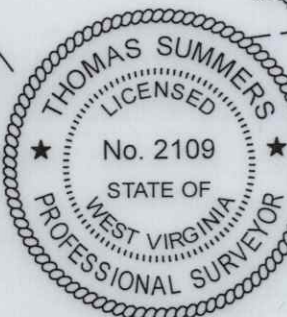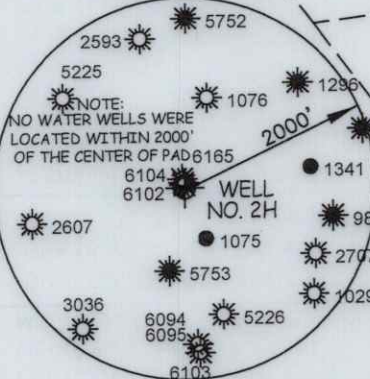

I THE UNDERSIGNED, HEREBY CERTIFY THAT THIS PLAT IS CORRECT
TO THE BEST OF MY KNOWLEDGE AND BELIEF AND SHOWS ALL THE
INFORMATION REQUIRED BY LAW AND THE RULES ISSUED AND
PERSCRIBED BY THE DEPARTMENT OF ENVIRONMENTAL PROTECTION.



STATE OF WEST VIRGINIA, DIVISION
OF ENVIRONMENTAL PROTECTION,
OFFICE OF OIL AND GAS

WILLOW LAND SURVEYING PLLC
220 MASONIC AVE. PENNSBORO
WEST VIRGINIA 26415

JOB # 25-011WA

DRAWING # WYSONG2H

SCALE 1" = 2000'

MINIMUM DEGREE OF

ACCURACY SUBMETER

PROVEN SOURCE OF ELEV.

SUBMETER MAPPING GRADE GPS

STATE OF WEST VIRGINIA

DEPARTMENT OF ENERGY

DIVISION OF OIL AND GAS

LEGEND

- Surface Owner Boundary Lines +/-
- Adjoining Surface Tracts +/-
- Found monument, as noted

THOMAS SUMMERS P.S. 2109

DATE 08/18/25

OPERATOR'S WELL# WYSONG UNIT #2H

PAD LAYOUT

NOT TO
SCALE

REFERENCES

WELL TYPE: OIL ☐ GAS ☒ LIQUID INJECTION ☐ WASTE DISPOSAL ☐(IF "GAS") PRODUCTION ☒ STORAGE ☐ DEEP ☐ SHALLOW ☒

LOCATION: ELEVATION ASBUILT - 1,213'

WATERSHED HEADWATERS MIDDLE ISLAND CREEK

API WELL #

47

017

-

06995

QUADRANGLE NEW MILTON 7.5'

DISTRICT NEW MILTON

COUNTY DODDRIDGE

SURFACE OWNER SANDRA E. ERWIN

ACREAGE 104 ACRES +/-

OIL & GAS ROYALTY OWNER JOHN F. ERWIN ET UX

LEASE ACREAGE 104 ACRES±

PROPOSED WORK: DRILL ☐ CONVERT ☐ DRILL DEEPER ☒ REDRILL ☐ FRACTURE ORSTIMULATE ☒ PLUG OFF OLD FORMATION ☐ PERFORATE NEW FORMATION ☒

OTHER PHYSICAL CHANGE IN WELL (SPECIFY) MOD-BHL

PLUG & ABANDON ☐ CLEAN OUT & REPLUG ☐

ESTIMATED DEPTH 7,700' TVD 20,200' MD

TARGET FORMATION MARCELLUS

WELL OPERATOR ANTERO RESOURCES CORP.

DESIGNATED AGENT CONRAD BASTON

ADDRESS 1615 WYNKOOP STREET

ADDRESS 535 WHITE OAK BLVD.

DENVER, CO 80202

BRIDGEPORT, WV 26330

LONGITUDE 80°40'00" 15,054' TO BOTTOM HOLE

LONGITUDE 80°40'00"

3,598'

LESSOR	
B	SANDRA E. ERWIN
C	JOSEPH I. SHULTE ET AL
D	EDMOND COLE ET AL
F	EDMOND COLE ET AL
G	EDA FRANCES GAMSJAGER
H	FONCE E. & RITA B. BROWN
I	GLENN G. SCHMIDT ET AL
O	JOHN F. ERWIN ET UX
Q	JOHN F. & SANDRA E. ERWIN

NEW MILTON DISTRICT	
18-7	BARBARA PETERSON
19-3	SUSAN GIDO ET AL
19-7	SUSAN GIDO ET AL
19-8.3	DOLORES HINTERER
19-9	DOLORES HINTERER
19-9.1	CRATG & MELISSA HINTERER
19-10	SANDRA ERWIN
19-11	SANDRA ERWIN
19-12	SANDRA ERWIN
19-13	MARY ANN & TEIGH RUDDY
19-14	ROBERT RUDDY
19-19	REXALL CRISLIP ET AL
23-1	DOLORES HINTERER
23-2	JOHN & DIANE PITCOCK
COVE DISTRICT	
3-1	MARY ANN & TEIGH RUDDY
6-1	PHILLIP C. HINTERER ET AL
6-1.1	KEITH SWITSHER ET UX
6-1.2	KEITH SWITSHER ET UX
6-2	MARY ANN & TEIGH RUDDY
6-3	MARY ANN & TEIGH RUDDY
6-4	MARY ANN & TEIGH RUDDY
6-7	RABTAB SCHULTE
6-8	RABTAB SCHULTE
6-9	MARCELLA YEATER
6-9.1	MARCELLA YEATER
6-10.1	LEAH KELLY
6-10.2	ROBERT JOHNSON ET AL
6-11	JOSEPH & DARLENE CHURCH
10-5	EDITH G. WILSON TRUST
10-5.1	WILLIAM S. JR. & FORREST WYSONG
10-5.2	WILLIAM S. JR. & FORREST WYSONG
10-5.3	WILLIAM S. JR. & FORREST WYSONG
10-6	JOHN ANCIL SCHMIDT
10-6.1	WILLIAM S. JR. & FORREST WYSONG
10-6.2	ST. JOHANNES EVANGELICAL LUTHERAN CHURCH
10-7	LUTHERAN CHURCH PARSONAGE
10-8	DODDRIDGE CO. HISTORICAL SOCIETY
10-9	HAZEL WYSONG
10-10	DONALD & TERRI RIFFEE
10-12	JOHN & BARBARA MAYER
10-14	CLARENCE DAVID BROWN