

**Antero Resources Corporation**  
Appalachian Basin  
Wagner B Pad  
Doddridge County

Quadrangle: Big Isaac  
Watershed: Headwaters Middle Island Creek  
District: Greenbrier  
Date: 1-09-2026

REGENT  
Office of Oil and Gas  
JAN 15 2026  
WV Department of  
Environmental Protection

02/20/2026

LATITUDE 39°15'00"

5,883'

LATITUDE 39°15'00" 3,245' TO BOTTOM HOLE

Antero Resources Corporation  
Well No. Joran 1H

Greenbrier District - Doddridge County	
10-9.1	KENNETH KIRK
10-10	EVELYN HUGHES ET AL
10-15	PERRY PERINE SR.
10-17	TODD DEVERICKS
10-17.1	PATRICK MANNING
10-17.2	RETHA JOLLEY
10-17.3	THOMAS JOHNSON
10-17.4	SHAWNNA THOMAS
10-17.5	SHAWNNA THOMAS
10-17.6	DEMETRIUS TRAVIS
10-17.7	JOHN FRAME
10-17.8	JOSHUA POWELL
10-17.9	SHAWNNA THOMAS
10-20	CHARLES HESTON
10-20.1	DAVID CHIPPS
10-20.2	CRESTWOOD MARCELLUS MIDSTREAM LLC
10-20.3	RALPH CARTO
10-21	PERRY PERINE
10-22	BLAINE DEVERICKS
10-23.1	BLAINE DEVERICKS
10-24	JUANITA HERRON
10-27	DAVID BOWYER

WELL NO. 1H

POINT OF ENTRY

WELL 1H BOTTOM HOLE

NOTES:

WELL 1H TOP HOLE INFORMATION:  
N: 261,244ft E: 1,687,157ft  
LAT: 39°12'43.17" LON: 80°36'14.74"

BOTTOM HOLE INFORMATION:  
N: 260,760ft E: 1,689,789ft  
LAT: 39°12'38.70" LON: 80°35'41.23"

WEST VIRGINIA COORDINATE SYSTEM OF 1927 NORTH ZONE. ZONE WAS DERIVED FROM MEASUREMENTS TAKEN WITH TRIMBLE GEOXT SUBMETER MAPPING GRADE GPS UNIT. PLAT-ORIENTATION, CORNER, AND WELL REFERENCE TIE LINES ARE BASED ON GRID NORTH.

(NAD) 83 (UTM) ZONE 17 COORDS:  
WELL 1H TOP HOLE INFORMATION:  
N: 4,340,386m E: 534,195m  
BOTTOM HOLE INFORMATION:  
N: 4,340,252m E: 534,999m

(NAD) 27 (UTM) ZONE 17 COORDS:  
WELL 1H TOP HOLE INFORMATION:  
N: 14,239,368ft E: 1,752,557ft  
POINT OF ENTRY INFORMATION:  
N: 14,239,402ft E: 1,755,037ft  
BOTTOM HOLE INFORMATION:  
N: 14,238,928ft E: 1,755,196ft

NOTE  
NO OCCUPIED DWELLINGS OR BUILDINGS TWO THOUSAND FIVE HUNDRED (2,500) SQUARE FEET OR LARGER USED TO HOUSE OR SHELTER DAIRY CATTLE OR POULTRY HUSBANDRY ARE LOCATED WITHIN SIX HUNDRED TWENTY-FIVE (625) FEET OF THE CENTER OF THE WELL PAD.

WV NORTH ZONE  
GRID NORTH



14,296' TO BOTTOM HOLE

13,844'

LONGITUDE 80°35'00"

LONGITUDE 80°35'00"

LEASES	
A	JUDY FREEMAN POST
B	FRANKIE V. NEEL & BYRON DUANE NEEL
C	CLARENCE MUTSCHELKNAUS SR.
W	E. MAY SUMMERS
X	CLARENCE W. MUTSCHELKNAUS & MARY F. MUTSCHELKNAUS
Y	REXALL & ELVA BARNETT
Z	CLARENCE MUTSCHELKNAUS SR.

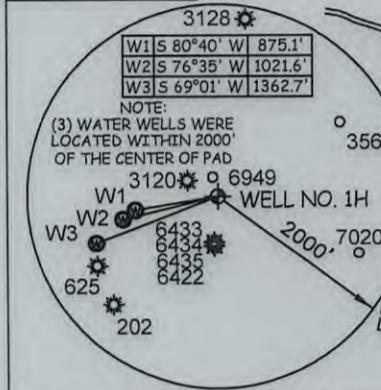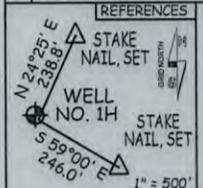

I THE UNDERSIGNED, HEREBY CERTIFY THAT THIS PLAT IS CORRECT TO THE BEST OF MY KNOWLEDGE AND BELIEF AND SHOWS ALL THE INFORMATION REQUIRED BY LAW AND THE RULES ISSUED AND PERSCRIBED BY THE DEPARTMENT OF ENVIRONMENTAL PROTECTION.



STATE OF WEST VIRGINIA, DIVISION OF ENVIRONMENTAL PROTECTION, OFFICE OF OIL AND GAS

WILLOW LAND SURVEYING PLLC  
220 MASONIC AVE. PENNSBORO WEST VIRGINIA 26415

JOB # 25-023WA  
DRAWING # JORAN1HS  
SCALE 1" = 2000'  
MINIMUM DEGREE OF ACCURACY SUBMETER  
PROVEN SOURCE OF ELEV. SUBMETER MAPPING GRADE GPS



STATE OF WEST VIRGINIA DEPARTMENT OF ENERGY DIVISION OF OIL AND GAS

LEGEND

- Surface Owner Boundary Lines +/-
- Adjoining Surface Tracts +/-
- Found monument, as noted

THOMAS SUMMERS P.S. 2109

DATE 01/12/26  
OPERATOR'S WELL# JORAN 1H

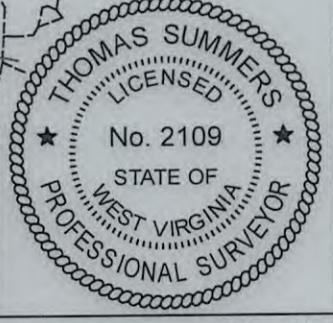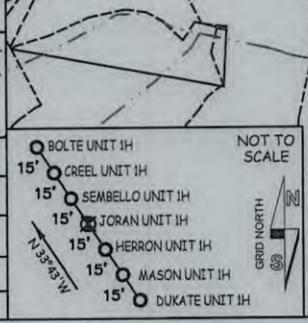

WELL TYPE: OIL \_\_\_ GAS X LIQUID INJECTION \_\_\_ WASTE DISPOSAL \_\_\_ 47 - 017 - 07008  
(IF "GAS") PRODUCTION X STORAGE \_\_\_ DEEP \_\_\_ SHALLOW X STATE COUNTY PERMIT

LOCATION: ELEVATION 1,311' AS-BUILT WATERSHED HEADWATERS MIDDLE ISLAND CREEK  
QUADRANGLE BIG ISAAC 7.5' DISTRICT GREENBRIER COUNTY DODDRIDGE

SURFACE OWNER TODD DEVERICKS ET AL ACREAGE 63.75 ACRES +/- 02/20/2026

OIL & GAS ROYALTY OWNER CLARENCE W. MUTSCHELKNAUS & MARY F. MUTSCHELKNAUS LEASE ACREAGE 59.84 AC.±

PROPOSED WORK: DRILL X CONVERT \_\_\_ DRILL DEEPER \_\_\_ REDRILL \_\_\_ FRACTURE OR STIMULATE X  
PLUG OFF OLD FORMATION \_\_\_ PERFORATE NEW FORMATION X OTHER PHYSICAL CHANGE IN WELL  
(SPECIFY) PLUG & ABANDON CLEAN OUT & REPLUG

TARGET FORMATION MARCELLUS ESTIMATED DEPTH 7,800' TVD 11,600' MD

WELL OPERATOR ANTERO RESOURCES CORP. DESIGNATED AGENT CONRAD BASTON

ADDRESS 1615 WYNKOOP ST. ADDRESS 535 WHITE OAK BLVD.  
DENVER, CO 80202 BRIDGEPORT, WV 26330

COUNTY NAME PERMIT

LATITUDE 39°15'00"

5,883'

LATITUDE 39°15'00"

3,245' TO BOTTOM HOLE

Antero Resources Corporation  
Well No. Joran 1H

Greenbrier District - Doddridge County	
10-9.1	KENNETH KIRK
10-10	EVELYN HUGHES ET AL
10-15	PERRY PERINE SR.
10-17	TODD DEVERICKS
10-17.1	PATRICK MANNING
10-17.2	RETHA JOLLEY
10-17.3	THOMAS JOHNSON
10-17.4	SHAWNA THOMAS
10-17.5	SHAWNA THOMAS
10-17.6	DEMETRIUS TRAVIS
10-17.7	JOHN FRAME
10-17.8	JOSHUA POWELL
10-17.9	SHAWNA THOMAS
10-20	CHARLES HESTON
10-20.1	DAVID CHIPPS
10-20.2	GRESHWOOD MARCELLUS MIDSTREAM LLC
10-20.3	RALPH CARITTO
10-21	PERRY PERINE
10-22	BLAINE DEVERICKS
10-23.1	BLAINE DEVERICKS
10-24	JUANITA HERRON
10-27	DAVID BOWYER

WELL NO. 1H

WELL 1H BOTTOM HOLE

NOTES:  
 WELL 1H TOP HOLE INFORMATION:  
 N: 261,244ft E: 1,687,157ft  
 LAT: 39°12'43.17" LON: 80°36'14.74"  
 BOTTOM HOLE INFORMATION:  
 N: 260,760ft E: 1,689,789ft  
 LAT: 39°12'38.70" LON: 80°35'41.23"  
 WEST VIRGINIA COORDINATE SYSTEM OF 1927 NORTH ZONE. ZONE WAS DERIVED FROM MEASUREMENTS TAKEN WITH TRIMBLE GEOXT SUBMETER MAPPING GRADE GPS UNIT. PLAT. ORIENTATION, CORNER, AND WELL REFERENCE TIE LINES ARE BASED ON GRID NORTH.

(NAD) 83 (UTM) ZONE 17 COORDS:  
 WELL 1H TOP HOLE INFORMATION:  
 N: 4,340,386m E: 534,195m  
 BOTTOM HOLE INFORMATION:  
 N: 4,340,252m E: 534,999m

(NAD) 27 (UTM) ZONE 17 COORDS:  
 WELL 1H TOP HOLE INFORMATION:  
 N: 14,239,368ft E: 1,752,557ft  
 POINT OF ENTRY INFORMATION:  
 N: 14,239,402ft E: 1,755,037ft  
 BOTTOM HOLE INFORMATION:  
 N: 14,238,928ft E: 1,755,196ft

NOTE  
 NO OCCUPIED DWELLINGS OR BUILDINGS TWO THOUSAND FIVE HUNDRED (2,500) SQUARE FEET OR LARGER USED TO HOUSE OR SHELTER DAIRY CATTLE OR POULTRY HUSBANDRY ARE LOCATED WITHIN SIX HUNDRED TWENTY-FIVE (625) FEET OF THE CENTER OF THE WELL PAD.



WV NORTH ZONE  
GRID NORTH

14,296' TO BOTTOM HOLE

13,844'

LONGITUDE 80°35'00"

LEASES	
A	JUDY FREEMAN POST
B	FRANKIE V. NEEL & BYRON DUANE NEEL
C	CLARENCE MUTSCHELKNAUS SR.
W	E. MAY SUMMERS
X	CLARENCE W. MUTSCHELKNAUS & MARY F. MUTSCHELKNAUS
Y	REXALL & ELVA BARNETT
Z	CLARENCE MUTSCHELKNAUS SR.

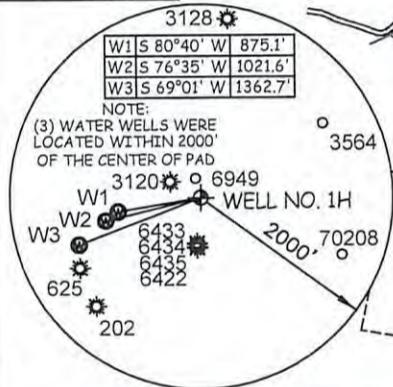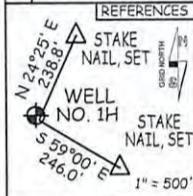


I THE UNDERSIGNED, HEREBY CERTIFY THAT THIS PLAT IS CORRECT TO THE BEST OF MY KNOWLEDGE AND BELIEF AND SHOWS ALL THE INFORMATION REQUIRED BY LAW AND THE RULES ISSUED AND PERSCRIBED BY THE DEPARTMENT OF ENVIRONMENTAL PROTECTION.



STATE OF WEST VIRGINIA, DIVISION OF ENVIRONMENTAL PROTECTION, OFFICE OF OIL AND GAS  
 WILLOW LAND SURVEYING PLLC  
 220 MASONIC AVE. PENNSBORO WEST VIRGINIA 26415

RECEIVED  
 Office of Oil and Gas  
 JAN 15 2026


WV Department of Environmental Protection

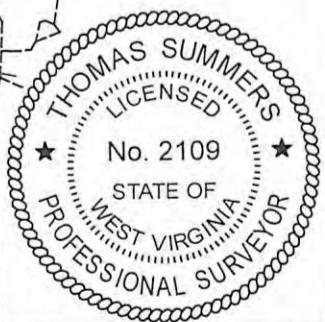

JOB # 25-023WA  
 DRAWING # JORAN1HS  
 SCALE 1" = 2000'  
 MINIMUM DEGREE OF ACCURACY SUBMETER  
 PROVEN SOURCE OF ELEV. SUBMETER MAPPING GRADE GPS

LEGEND  
 --- Surface Owner Boundary Lines +/-  
 --- Adjoining Surface Tracts +/-  
 ⊕ Found monument, as noted

*Thomas Summers*  
 THOMAS SUMMERS P.S. 2109

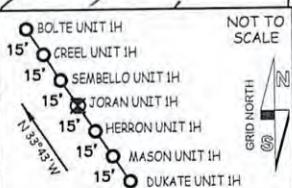

STATE OF WEST VIRGINIA DEPARTMENT OF ENERGY DIVISION OF OIL AND GAS

DATE 01/12/26  
 OPERATOR'S WELL# JORAN 1H

WELL TYPE: OIL  GAS  LIQUID INJECTION  WASTE DISPOSAL  47 - 017 - DT008  
 (IF "GAS") PRODUCTION  STORAGE  DEEP  SHALLOW  STATE COUNTY PERMIT  
 LOCATION: ELEVATION 1,311' AS-BUILT WATERSHED HEADWATERS MIDDLE ISLAND CREEK  
 QUADRANGLE BIG ISAAC 7.5' DISTRICT GREENBRIER COUNTY DODDRIDGE  
 SURFACE OWNER TODD DEVERICKS ET AL ACREAGE 63.75 ACRES +/- 02/20/2026  
 OIL & GAS ROYALTY OWNER CLARENCE W. MUTSCHELKNAUS & MARY F. MUTSCHELKNAUS LEASE ACREAGE 59.84 AC.±

PROPOSED WORK: DRILL  CONVERT  DRILL DEEPER  REDRILL  FRACTURE OR STIMULATE   
 PLUG OFF OLD FORMATION  PERFORATE NEW FORMATION  OTHER PHYSICAL CHANGE IN WELL  
 (SPECIFY) PLUG & ABANDON CLEAN OUT & REPLUG  
 TARGET FORMATION MARCELLUS ESTIMATED DEPTH 7,800' TVD 11,600' MD  
 WELL OPERATOR ANTERO RESOURCES CORP. DESIGNATED AGENT CONRAD BASTON  
 ADDRESS 1615 WYNKOOP ST. ADDRESS 535 WHITE OAK BLVD.  
 DENVER, CO 80202 BRIDGEPORT, WV 26330

COUNTY NAME PERMIT