

7.5' Latitude 39°20'00"
+

S80°35'00"

Longitude

Topo Location

7.5' Loc. 0.185 15' Loc. 0.185
1.59W (calc.) 1.59W

Company _____

Farm Boyer #1 _____

15' Quad Centripent SC
(sec.) _____

7.5' Quad Salen _____


District McClellan _____

WELL LOCATION PLAT

County 017 Permit 30036

Boil-36-A

ENGINEERS CERTIFICATE

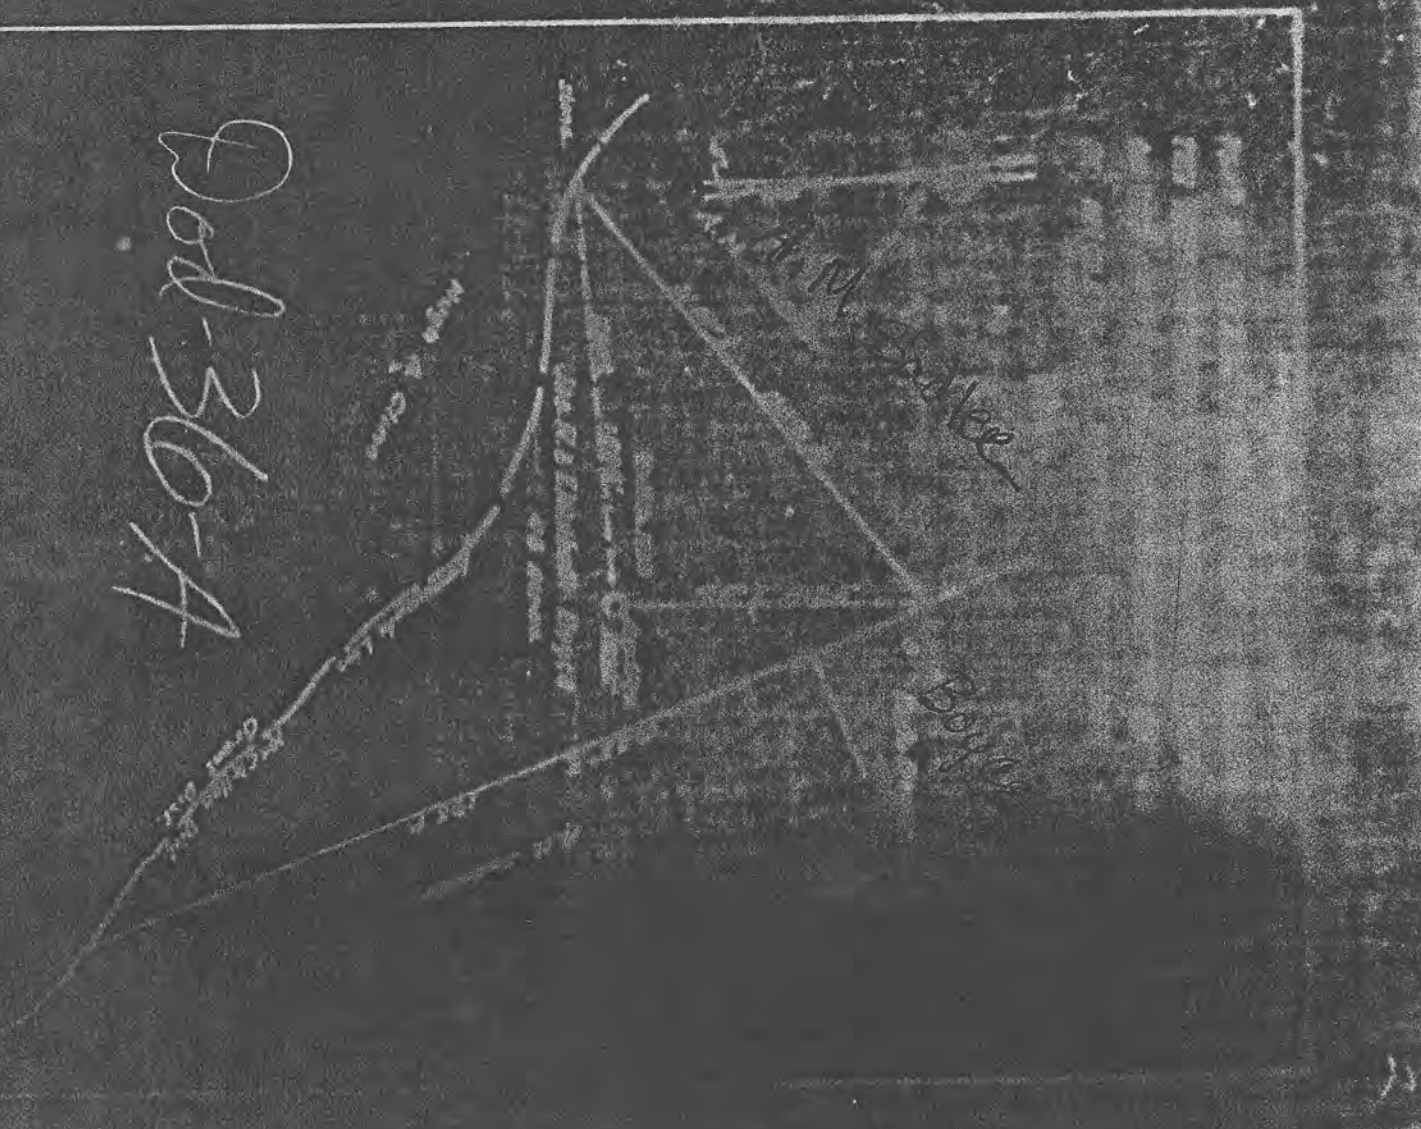

→ NOW 017 30036

McClellan District, Doddridge County, W. Va.
 By The Manufacturers Light & Heat Co., 800 Union Trust Bldg.,
 Pittsburgh, Pa.
 On 46 acres, surface owned by James R. and Elizabeth Boyce,
 R. D. No. 3, Pennsboro, W. Va., and mineral rights by ML&HCo.
 Drilled prior to June 1, 1929.
 Elevation, 1228' L.
 16' conductor; 6-5/8" casing, 2210'; 2" tubing, 3209'.
 Packer, 6-5/8 x 2, set at 2207'.
 Coal was encountered at 368-371, 633-636, and 895-901'.
 Abandonment reported to Dept. of Mines March 4, 1931. - 327' sept
 Production, 53,000 cu. ft. gas.

	Top.	Bottom.	Thickness.
Coal	368	- 371	3
Coal	633	- 636	3
Pittsburgh Coal	895	- 901	6
Little Dunkard Sand	1230	- 1265	35
Big Dunkard Sand	1400	- 1425	25
Gas Sand	1495	- 1520	25
1st Salt Sand	1565	- 1635	70
2nd Salt Sand	1690	- 1720	30
Sand	1894	- 1919	25
Maxton Sand	1990	- 2050	60
Little Lime	2135	- 2160	25
Pencil Cave	2160	- 2185	25
Big Lime	2185	- 2239	54
Big Injun Sand (gas at 2297')	2239	- 2340	101
Squaw Sand	2475	- 2505	30
Berea Grit	2525	- 2587	62
30-Ft. Sand	2920	- 2945	25
Gordon Sand (gas at 3009')	3004	- 3019	15
5th Sand	3175	- 3188	13
Slate	3206	- 3216	10
Lime	3216	- 3223	7
Slate	3223	- 3229	6
Lime	3229	- 3237	8
Slate and shells	3237	- 3247	10
Lime	3247	- 3255	8
Slate and shells	3255	- 3264	9
Lime	3264	- 3270	6
Slate and shells	3270	- 3283	13
Lime	3283	- 3293	10
Slate and shells	3293	- 3308	15
Lime	3308	- 3320	12
Slate	3320	- 3331	11
Lime	3331	- 3351	20
Slate	3351	- 3361	10
Lime	3361	- 3379	18
Slate	3379	- 3382	3
Lime	3382	- 3399	17
Slate, to bottom	3399	- 3408	9

COMPLETION DATA SHEET

NO. 2


FORMATION RECORD

The Manufacturers Light & Heat Company
 600 North Street, Philadelphia, Pa.
 19111-1000 - John D. Brown, Super. Form.

Time	Color	Temperature	Pressure	Flow	Volume	Notes
10:00	Black	100	100	100	100	Start of run
10:05	Black	100	100	100	100	
10:10	Black	100	100	100	100	
10:15	Black	100	100	100	100	
10:20	Black	100	100	100	100	
10:25	Black	100	100	100	100	
10:30	Black	100	100	100	100	
10:35	Black	100	100	100	100	
10:40	Black	100	100	100	100	
10:45	Black	100	100	100	100	
10:50	Black	100	100	100	100	
10:55	Black	100	100	100	100	
11:00	Black	100	100	100	100	
11:05	Black	100	100	100	100	
11:10	Black	100	100	100	100	
11:15	Black	100	100	100	100	
11:20	Black	100	100	100	100	
11:25	Black	100	100	100	100	
11:30	Black	100	100	100	100	
11:35	Black	100	100	100	100	
11:40	Black	100	100	100	100	
11:45	Black	100	100	100	100	
11:50	Black	100	100	100	100	
11:55	Black	100	100	100	100	
12:00	Black	100	100	100	100	End of run

Start of run at _____
 End of run at _____
 Total volume of _____
 Total weight of _____
 Total pressure of _____
 Total temperature of _____
 Total flow of _____
 Total volume of _____
 Total weight of _____
 Total pressure of _____
 Total temperature of _____
 Total flow of _____

Prepared by Henry H. Brown
 Date March 10, 1911

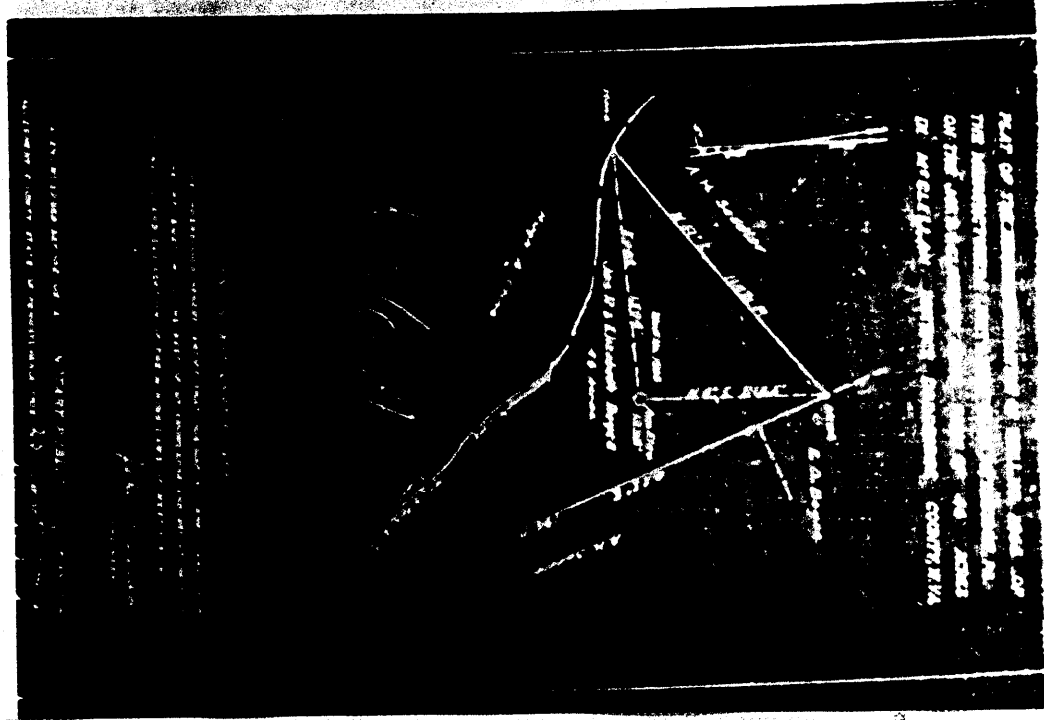

APPROVANT IN TRIANGLE TO TIME AND MANNER OF
PLACING AND FILLING WALLS
WEST VIRGINIA DEPARTMENT OF MINES
THE ASB USES SECTION

Field No. 2010
Geography, ...
The Sandstone Light & Dark Co.
600 Union Street, Wheeling, W. Va.

APPROVANT
Name of ...
No. ...
Date ...

APPROVANT
Name of ...
No. ...
Date ...

APPROVANT
Name of ...
No. ...
Date ...

APPROVANT
Name of ...
No. ...
Date ...

WEST VIRGINIA DEPARTMENT OF MINES
Oil and Gas Section
PRELIMINARY DATA SHEET NO. 1

The Sandstone Light & Dark Co.
600 Union Street, Wheeling, W. Va.

No.	Name	Address	City	State
1
2
3
4
5
6
7
8
9
10

APPROVANT
Name of ...
No. ...
Date ...

APPROVANT
Name of ...
No. ...
Date ...