

Latitude 39° 20' 00"

75'

80° 50' 00"

Longitude

Topo Location

7.5' Loc. 0.095 15' Loc. 0.095
0.07W (calc.) 0.07W

Company C-111
Farm B. Hendershott
15' Quad West Union SC
(sec.)
7.5' Quad West Union
District Central

WELL LOCATION PLAT

County 017 Permit 30101

Central District, Doddridge County, W. Va.
 By F. S. Deem, Harrisville, W. Va.
 On 22½ acres, surface owned by Henderson Walton, Route 1,
 Central Station, W. Va.
 Drilled prior to June 1, 1929.
 Elevation, 802.0' L.
 6-5/8" casing, 1721'; 2" tubing, 1878'.
 Coal blossom at 454-456'.
 Abandonment reported to Dept. of Mines April 1, 1935.
 No record of shot. No record of water.
 Producing hole.

	Top.	Bottom.
Coal blossom	454	- 456
Big Dunkard Sand	950	- 980
Gas Sand	1050	- 1110
1st Salt Sand	1210	- 1230
2nd Salt Sand	1275	- 1338
3rd Salt Sand	1410	- 1482
Little Lime	1665	- 1670
Pencil Cave	1670	- 1698
Big Lime	1690	- 1769
Big Injun Sand (gas, 1842'; oil, 1863')	1769	- 1876
Total depth		1880

Name	Color	Character	Oil, Gas or Water	Top	Bottom	Thickness	Total Depth	Remarks
Coal Bligson				454	456			
Big Dunbar				950	980			
Gas Sand				1050	1110			
1st. Salt				1210	1230			
2nd. Salt				1276	1338			
3rd. Salt				1410	1482			
Little Lime				1668	1670			
Pencil Cave				1670	1698			
Big Lime				1690	1769			
Big Injun		Gas	1842					
		Oil	1865					
		Total Depth.....					1880	

Well was not shot at NO RECORD feet; well was shot at _____ feet.


Salt _____ feet; fresh water at _____ feet.

Well was _____ producing _____ bbls.

Apr. 1, 1935 Approved J. H. ... Over

NOTE: All bottom formations must be noted as indicated above and all logs made must be recorded under their proper geological names in the district as well as any local names commonly used in the district for each strata.

2007 10117

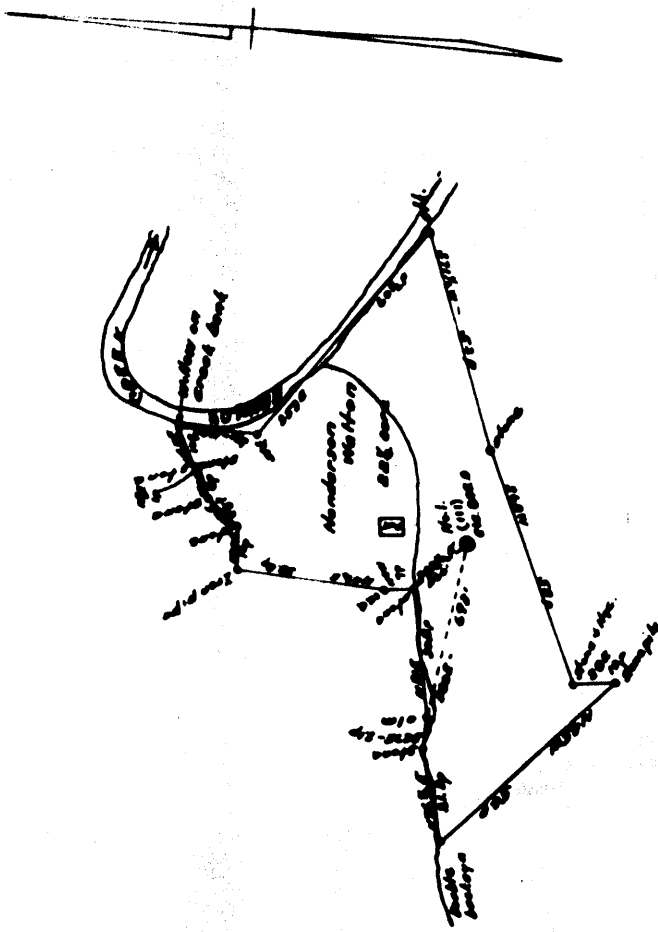

REGISTER'S CERTIFICATE

I, the undersigned, hereby certify that this map is correct and above all the information, to the best of my knowledge and belief, required by the Oil and Gas Section of the Mining Laws of West Virginia.

Wm. S. ...
Register

Acknowledged before me a Notary Public of Ritchie County, West Virginia on this the 1st day of April 1935.
My commission expires March 1, 1937 1888.

Notary Public

APR 2 1935

