

Latitude 39° 12' 30"

1274  
+  
751

80° 32' 30"

Longitude

Topo Location

7.5' Loc. 1.00 S 15' Loc. 3.88 S  
0.67 W (calc.) 2.90 W

Company C-147

Farm J. H. Cunningham

15' Quad Vadis NE  
(sec.)

7.5' Quad Big ISSAC

District GREENBRIDGE


WELL LOCATION PLAT

County 017 Permit 30127

NO. OF  
P.A.  
OF APPLICANT  
BY WA.  
SERIAL NO.

1924

W.M. [unclear]

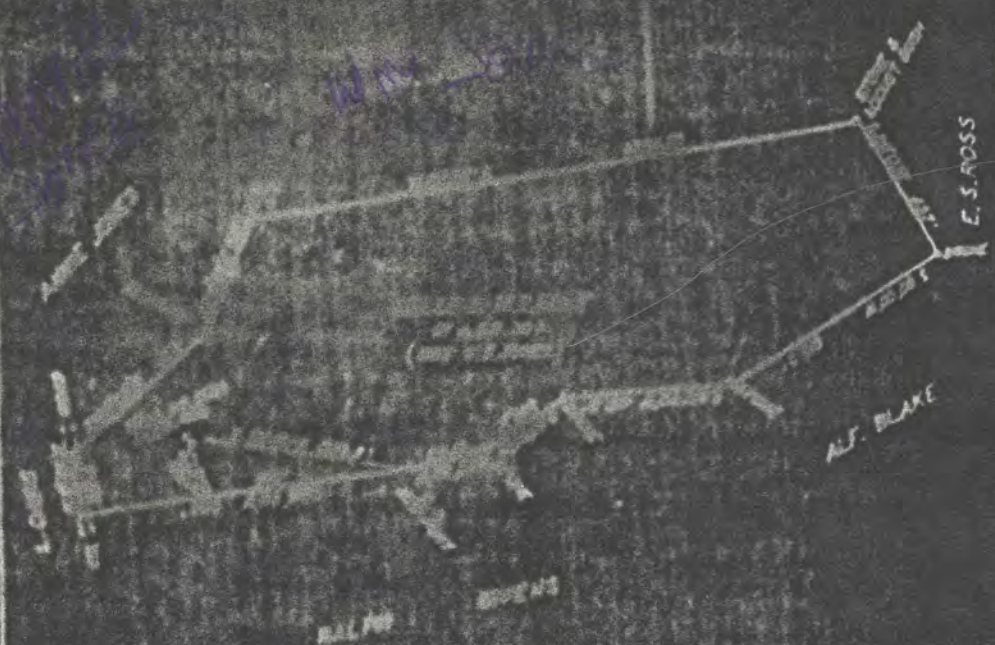

R.A.L. [unclear]

E.S. ROSS

R.A.L. [unclear]

ALL INFORMATION CONTAINED HEREIN IS UNCLASSIFIED EXCEPT WHERE SHOWN OTHERWISE BY THE DATE AND TIME OF REVIEW OF THIS RECORD AND THE REVIEWING OFFICIAL'S SIGNATURE.

*W. J. [unclear]*  
DIRECTOR

1924



Well No. 2  
 J. H. CUNNINGHAM  
 BREENBRIER  
 Date: ADDRESS  
 County: W. Va.


COMPLETION DATA SHEET

NO. 2

FORMATION RECORD

Form	Date	Character	Oil, Gas or Water	Top	Bottom	Thickness	Total Depth	Remarks
Seal				200	200	0'		
Pittsburgh Sand				200	200	0'		
Little Sandstone				2100	1870	70'		
Big Sandstone				2000	1800	200'		
Big Sand				2070	1800	40'		
Flint Sand				2000	1600	200'		
Shale				2000	1400	200'		
Shale				2100	2100	0'		
21000 Sand				2100	2100	0'		
Pencil Sand				2100	2000	200'		
24 Sand				2000	2000	0'		
24 Sand				2000	2000	0'		
Shale			Gas	2000	2000	0'		
Shale				2000	2000	0'		
Thirty feet				2036	2000	20'		
Green clay			Gas	2000	2045	20'		
Green				2017	2045	20'		
Fourth			Water & Gas	2007	2075	10'		
71.5%			Oil	2116	2121	10'	2142	

Well was set at 2116 to 2127 feet; well was shut at 2116  
 Well was producing 201 barrels per day  
 Well was producing 200 bbls per day

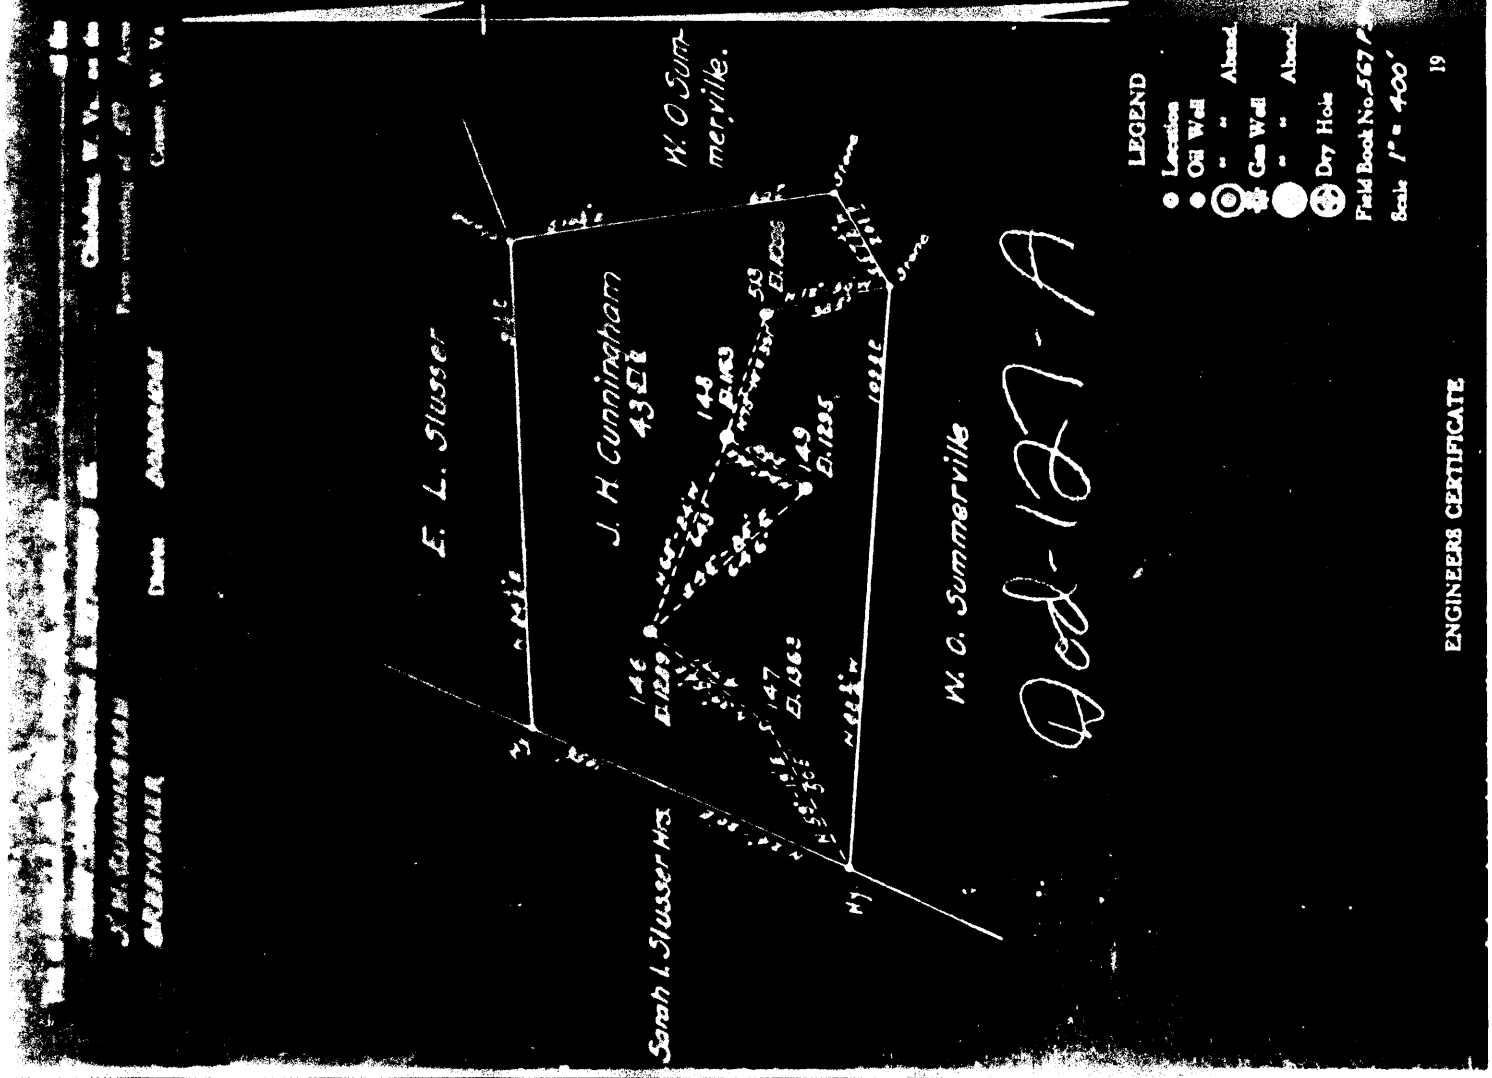

PRELIMINARY DATA SHEET NO. 1

File No. D-104 27-A (Formerly number 167)  
Edmond A. Harrison Company of Salisbury, W. Va.  
 on the J. H. Greenbrier Farm  
 containing 30 acres, located  
Greenbrier District, in Putnam County, West Virginia  
 The surface of the above land is owned in fee by Mr. E. Greenbrier  
 of J. H. Greenbrier, W. Va. address, and the mineral rights are owned by \_\_\_\_\_ of \_\_\_\_\_

The oil and gas privileges are held under lease by the above named company, and this well is drilled under permit No. \_\_\_\_\_ issued by the West Virginia Department of Mines, Oil and Gas Division \_\_\_\_\_

Elevation of surface at top of well \_\_\_\_\_ feet Surface Elevation

The number of feet of the different sized casings used in the well \_\_\_\_\_

Size	Length	Weight	Material
2 1/2"	15	1500	steel cas.
2 1/4"	6 1/2	857	steel cas.
2 1/8"	8		steel cas.
			packer of _____
			packer of _____

\_\_\_\_\_ in casing perforated at \_\_\_\_\_ feet to \_\_\_\_\_ feet.

\_\_\_\_\_ in casing perforated at \_\_\_\_\_ feet to \_\_\_\_\_ feet.

Coal was encountered at \_\_\_\_\_ feet, thick near \_\_\_\_\_ inches, and at \_\_\_\_\_ feet; thickness \_\_\_\_\_ inches; and of \_\_\_\_\_ feet; thickness \_\_\_\_\_ inches.

Lines were used as follows: (Give details) \_\_\_\_\_

Date \_\_\_\_\_  
 Approved J. M. Pugh, Eng. Major W. H. L. C. T. Operator

STRIKES IN THIS VICINITY

RAID & MOSES  
 NAME OF WELL OPERATOR  
SALEM, WEST V.  
 COUNTY ADDRESS  
W. VA.  
 COUNTY ADDRESS  
1936  
 YEAR  
 WELL AND LOCATION  
Greenbrier District  
Downbridge County  
 Well No., (FURNISH NUMBER, IF KNOWN) WV 147  
J. H. Greenbrier Farm

AFFIDAVIT

I, F. Harrison, of WEST VIRGINIA, do hereby certify that the above information was furnished to me by Edmond A. Harrison, who is duly sworn according to law and is a resident of the county of Putnam, West Virginia, and that they are true and correct to the best of my knowledge and belief.

Witness my hand and seal of office this \_\_\_\_\_ day of Sept., 1935, at \_\_\_\_\_, West Virginia.

\_\_\_\_\_  
 State Engineer

Removed 2" tubing and filled hole with mud from 312' to 306'-20" above fifth sand-placed wood plug above the fourth sand-placed wood plug at 3096' to 2937' continued filling to 2877', removed 5 3/16 casing placed plug installed bridge at 2814'-20" above 30' sand & placed plug to 2238'-10' below 8' casing placed plug and removed 8' inner in which coal was plugged; with clay to 1610'-20" below 2ND. salt sand filled 10' casing ix was set placed wood plug and removed casing installed permanent bridge at 1280' 10' below 10' little dunkard and filled hole with mud and clay to 863'-30' below Pittsburgh 1 Seam, filled with cement to 608' -20' below Pittsburgh 1 Seam, continued filling to 258' 30' below 13' casing and cement native coal to 205' from this point to the surface the hole was filled with mud description of monument: \_\_\_\_\_ and clay.

Concrete monument to be erected over the hole when Rig removed.

Work of plugging and filling said well was completed on the \_\_\_\_\_ day of \_\_\_\_\_, 1935.

I further deponents with me.  
Ben Mitchell  
William Pugh  
 Date 19 of March 1936..