

Latitude 39° 15' 00"

80° 35' 00"

Longitude

25'  
+

Topo Location

7.5' Loc. 1.22S 15' Loc. 1.22S  
1.51W (calc.) 1.51W

Company C-1171

Farm J. J. Adams I

15' Quad Vadis NC  
(sec.)

7.5' Quad Big ISSAC

District GREENBREE

WELL LOCATION PLAT

County 017 Permit 30140

FORMATION RECORD

Name	Color	Character	Thickness at Well	Top	Bottom	Dip	Remarks
Little Wash	.....	.....	.....	170	300	10°	
Little Wash	.....	.....	.....	0 794	1014	60°	
Big Wash	.....	.....	.....	1092	1152	60°	
Big Wash	.....	.....	.....	1200	1320	120°	
Big Wash	.....	.....	.....	1431	1460	29°	
Big Wash	.....	.....	.....	1420	1450	30°	
Little Wash	.....	.....	.....	1463	1476	15°	
Big Wash	.....	.....	.....	1476	1900	30°	
Big Wash	.....	.....	.....	1900	2000	60°	
Big Wash	.....	.....	.....	1900	2000	60°	
Big Wash	.....	.....	.....	1900	2042	70°	
Big Wash	.....	.....	.....	2122	2257	135°	
Big Wash	.....	.....	.....	2532	2637	65°	
Big Wash	.....	.....	.....	2625	2637	12°	
Big Wash	.....	.....	.....	2672	2690	10°	
Big Wash	.....	.....	.....	2670			

Well was not shot at. NO Record of depth. \_\_\_\_\_ feet; well was shot at. \_\_\_\_\_ feet.

Shot \_\_\_\_\_ feet.


Fresh water at. NOT recorded \_\_\_\_\_ feet; fresh water at. \_\_\_\_\_ feet.

Well was \_\_\_\_\_ feet.

Approved: *J. N. RAB* J. N. RAB & W. M. HOSKES.  
 Date: \_\_\_\_\_

NOTE: All bottom formations must be noted as indicated above and all log sheets and all other records must be recorded under their proper geological names in the district in which the well is located.

1172-104  
 is now  
 080A  
 140A

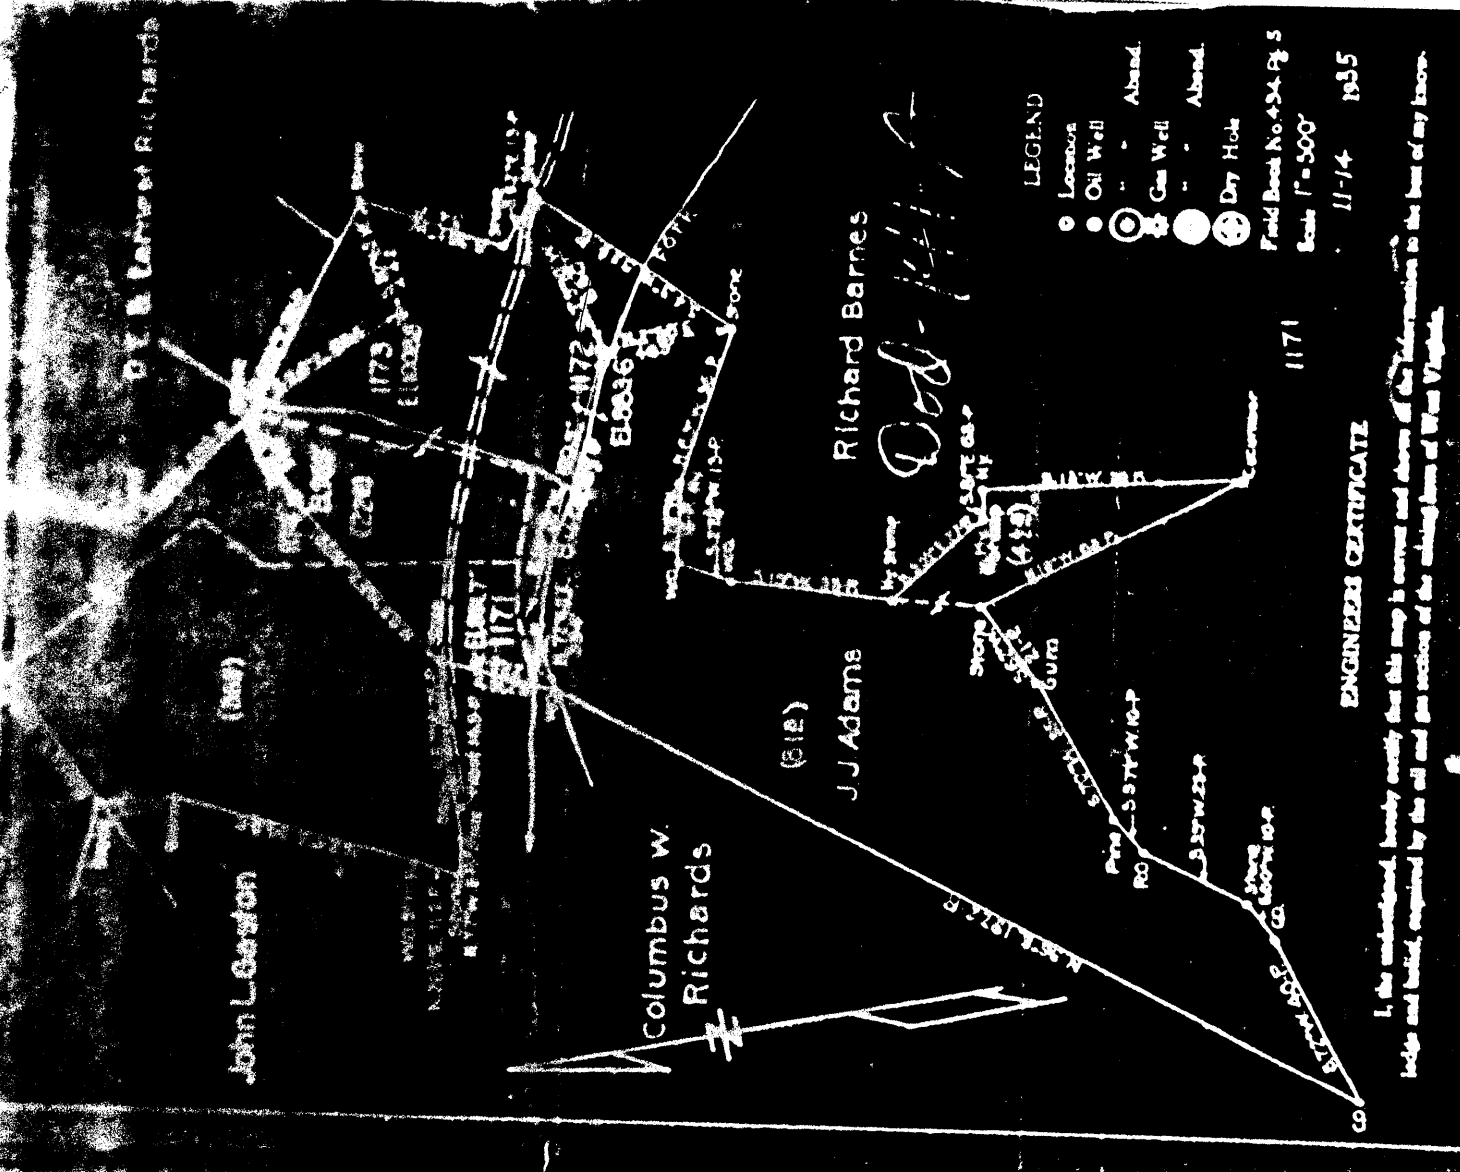

OIL AND GAS DIVISION

PRELIMINARY DATA SHEET NO. 1

Company of RAID & MOSES formerly RAID & MOSES  
State of W. VA. Well No. 1 Formerly CARCO (1171)

Location Adams County Putnam  
The nature of the above work is done in the by J. J. Adams

The oil and gas problems are held under lease by the above named company, and this well is drilled under permit issued by the West Virginia Department of Mines, Oil and Gas Division

Direction of casing at top of well \_\_\_\_\_

The number of feet of the different sized casings used in the well \_\_\_\_\_

2146	ft.	5 3/16	ft.	1928	ft.	6 5/8	ft.	Wood casing
1097	ft.	6 1/4	ft.		ft.		ft.	Steel casing
	ft.		ft.		ft.		ft.	Steel casing

Coal was encountered at 555 feet, thick 1200 inches, and at \_\_\_\_\_ feet; thickness \_\_\_\_\_ inches

Layers were used as follows: (Give details) \_\_\_\_\_

No Coal Operator is this locality

RAID & MOSES  
SALINE, W. VA.

MARCH 1936  
WELL AND LOCATION

Operator RAID & MOSES  
County PUTNAM  
Well No. 1 Formerly CARCO (1171)

J. J. ADAMS

AFFIDAVIT

STATE OF WEST VIRGINIA,  
County of HARRISBURG ) ss:

BERT MITCHELL and ALPHA FARNER  
being first duly sworn according to law depose and say that they are experienced in the work of plugging and filling oil and gas wells and were employed by RAID & MOSES well operator, and participated in the work of plugging and filling the above well, that said work was commenced on the \_\_\_\_\_ day of DEC., 1935, at \_\_\_\_\_, W. Va., and that the well was plugged and filled in the following manner:

Manner in which said well was plugged: Removed 2" tubing and filled hole with clay to 2605'-20' Above Gordon Gray placed wood plug and cement on top. Installed permanent bridge joint at 2300'-filled with clay to 2156'-10'. Below where 5 3/16 casing was set placed wood plug and cement on top. removed 5 3/16 casing. Continued filling to 11938'-10' below where 6 5/8 casing was set placed wood plug and cement on top. removed 6 5/8 casing. Installed permanent bridge joint at 1490' filled with clay to 1107'-10' below where 6 1/2 casing was set placed wood plug and removed 6 1/2 casing. continued filling to 590' 30" below Pittsburgh Coal Seam, and filled with cement to 530'-20" above Pittsburgh Coal Seam, then from this point to the surface the hole was filled with mud.

Description of monument: Concrete monument to be erected over the hole when Big removed.

and that the work of plugging and filling said well was completed on the \_\_\_\_\_ day of JAN., 1936.

And further deposes with us:  
Bert Mitchell  
Alpha Farnes