


0 1 2 3 LATITUDE 39° 15'

LONGITUDE 80° 50'

1
2
3

Sylvester Smith Est.

T.V. Smith Est.

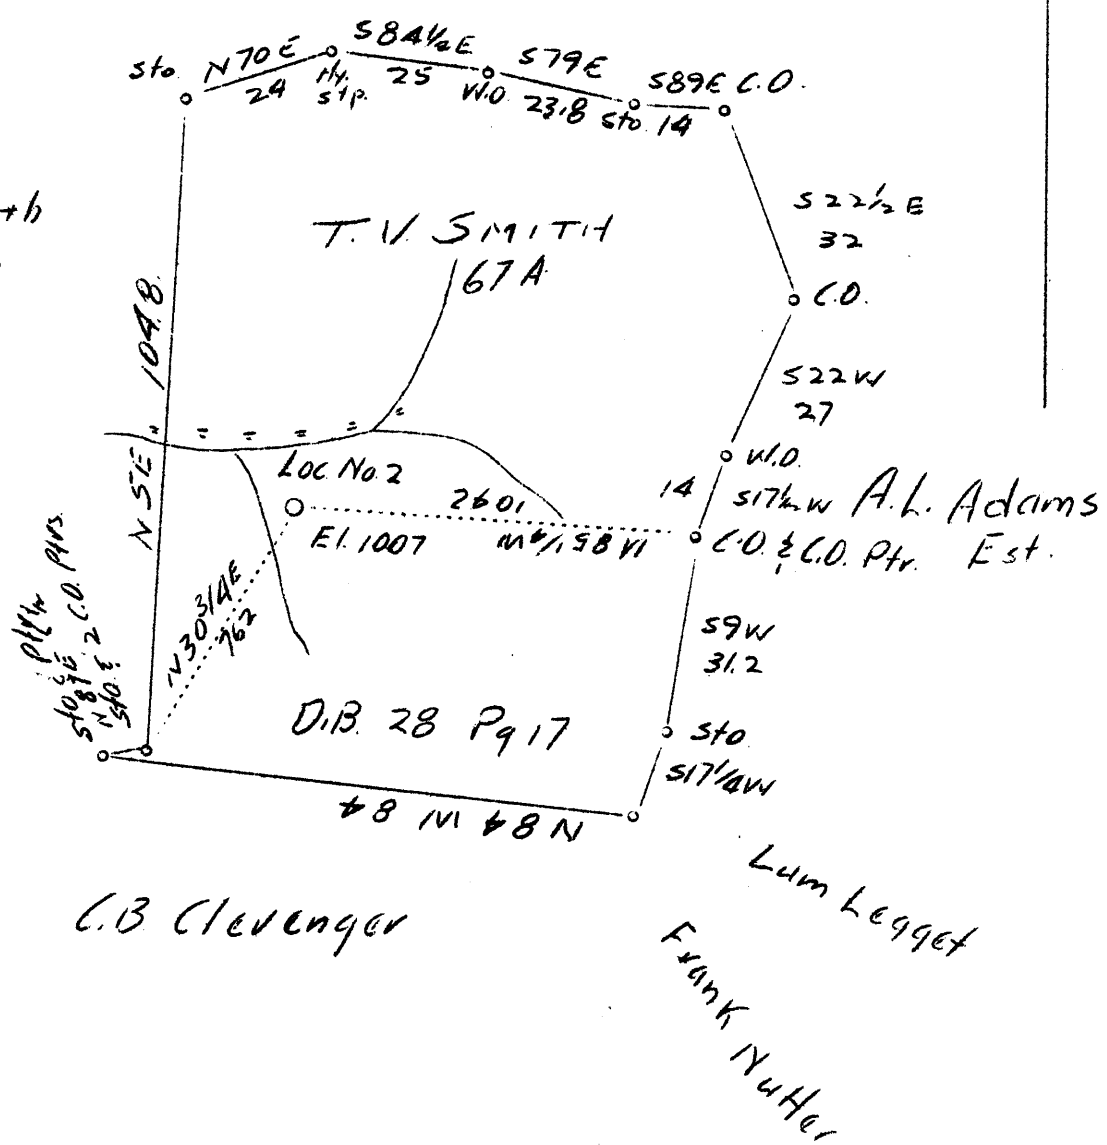

Abandonment

1.25 W
1.95 S

Company	Boyce, Dotson & Co.
Address	Greenwood, W.Va.
Farm	T.V. Smith
Tract	1 Acres 67 Lease No.
Well (Farm) No.	7 Serial No.
Quadrangle	Holbrook <u>NC</u>
County	Doddridge
District	Centrell
Engineer	J.M. Martin
Engineer's Registration No.	84
File No.	Drawing No.
Date	June 16, 1937 Scale 1"-30 P. or 495'

STATE OF WEST VIRGINIA
Department of Mines
OIL AND GAS DIVISION
CHARLESTON

WELL LOCATION MAP
File No. DOD-1854

187A
+ Denotes location of well on United States Topographic Maps, scale 1 to 62,500, latitude and longitude lines being represented by border lines as shown.

— Denotes one inch spaces on border line of original tracing.