


37 12 30

LATITUDE

80° 45'

LONGITUDE

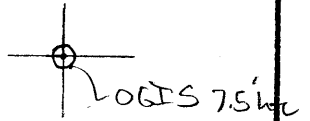

7.5 OGIS topo location

7.5' loc 2.28 S 15' loc 5.16 S  
 ' 0.42 W (calc.) 0.42 W

Company \_\_\_\_\_

Farm \_\_\_\_\_

Halbrook NE

Quad Oxford

County \_\_\_\_\_

District Southwest

WELL LOCATION MAP

File No. 017 - 30242

WEST VIRGINIA DEPARTMENT OF MINES  
OIL AND GAS DIVISION

189

WELL RECORD

Permit No. D01-242-A


Oil or Gas Well.....  
(Kind)

Company Hope Construction & Refining Company  
 Address Clarksburg, W. Va.  
 Farm S. W. Stout Acres 1427  
 Location (waters) South Fork Hughes River  
 Well No. 1324 Elev 1082  
 District Southwest County Doddridge  
 The surface of tract is owned in fee by S. W. Stout  
 Address Parkersburg, W. Va.  
 Mineral rights are owned by.....  
 Address.....  
 Drilling commenced 2-7-1900  
 Drilling completed 4-30-1900  
 Date shot 7-17-1934 Depth of shot 2604-2613  
 Open Flow /10ths Water in..... Inch  
 /10ths Merc. in..... Inch  
 Volume..... Cu. Ft.  
 Rock Pressure..... lbs..... hrs.  
 Oil..... bbls., 1st 24 hrs.  
 Fresh water None recorded feet..... feet  
 Salt water None recorded feet..... feet

Casing and Tubing	Used in Drilling	Left in Well	Packers
Size			
16.....			Kind of Packer.....
13.....			
10.....	495	Pulled	Size of.....
8 1/4.....	1155	Pulled	
6 5/8.....	1885	1885	Depth set.....
5 3/16.....	2004	2004	
3.....			Perf. top.....
2.....	2621	2621	Perf. bottom.....
Liners Used <sup>4"</sup>	624	624	Perf. top.....
			Perf. bottom.....

CASING CEMENTED..... SIZE..... No. FT..... Dat.....  
**Not cemented**  
 COAL WAS ENCOUNTERED AT..... FEET..... INCHES  
**No coal**  
 FEET..... INCHES..... FEET..... INCHES  
 FEET..... INCHES..... FEET..... INCHES

Formation	Color	Hard or Soft	Top	Bottom	Oil Gas or Water	Depth Found	Remarks
Red Rock Cave			850	1150			
Cow Run Sand			1155	1195			
Salt Sand			1380	1580			
Maxon Sand			1760	1785			
Big Lime			1880	1975			
Big Injun Sand			1975	2075			
Gordon Stray Sand			2588	2600			
Gordon Sand			2606	2611	Oil	2606	
Total Depth				2631			

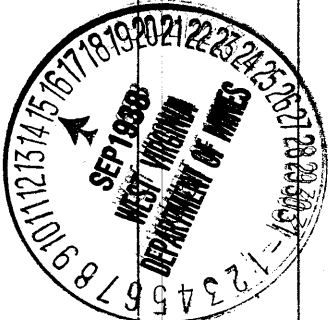



Southwest District, Doddridge County, W. Va.  
 By Hope Construction & Refining Co., Clarksburg, W. Va.  
 On 1427 acres, on South Fork of Hughes River.

Elevation, 1082' L.

Surface owned by S. W. Stout, Parkersburg, W. Va.

Drilling commenced 2-7-1900; completed, 4-30-1900.

Shot 7-17-1934, at 2604-2613'.

No water recorded.

10" casing, 495' (pulled); 8 $\frac{1}{4}$ "<sup>1</sup>, 1155' (pulled); 6 $\frac{5}{8}$ "<sup>5</sup>, 1885';  
 5 $\frac{3}{8}$ "<sup>3</sup>, 2004'; 4" liner, 624'; 2" tubing, 2621'.

Casing not cemented. No coal was encountered.

Oil well. Abandonment reported to Dept. of Mines Sept. 14, 1938.

Record to RCT from Mrs. Griffith Sept. 22, 1938.

	Top.	Bottom.
Red rock cave	850	- 1150
Cow Run Sand	1155	- 1195
Salt Sand	1380	- 1580
Maxton Sand	1760	- 1785
Big Lime	1880	- 1975
Big Injun Sand	1975	- 2075
Gordon Stray Sand	2588	- 2600
Gordon Sand (oil, 2606')	2606	- 2611
Total depth		2631

**AFFIDAVIT OF PLUGGING AND FILLING WELL**

Permit No. \_\_\_\_\_

NAME OF WELL OPERATOR  
 ADDRESS  
 CITY AND LOCATION  
 DISTRICT  
 COUNTY  
 WELL NO. \_\_\_\_\_  
 FARM

APPLICANT TO BE MADE IN TRIPLICATE, ONE COPY TO BE MAILED BY REGISTER MAIL TO THE DEPARTMENT, ONE COPY TO BE RETURNED BY THE WELL OPERATOR AND THE THIRD COPY (AND STRIKE COPIES IF REQUIRED) TO BE MAILED TO EACH COAL OPERATOR ABOVE NAMED AT THEIR RESPECTIVE ADDRESSES

STATE OF WEST VIRGINIA,  
 COUNTY OF \_\_\_\_\_

\_\_\_\_\_ and \_\_\_\_\_  
 being first duly sworn according to law depose and say that they are experienced in the work of

plugging and filling oil and gas wells and were employed by \_\_\_\_\_ contractor well operator, and participated in the work of plugging and filling the above well, that said work was commenced on the 22 day of October, 1938, and that the well was plugged and filled in the following manner:

Manner in which sand was plugged:

Recovered 2" tubing, 5-3/16" casing and 30' of 4" liner, filled with clay and to 2566' cemented from 2566 to 2575' drove wood tapered plug from top of 4" liner left in hole at 2493' filled with cement and to 1800' drove wood plug from 1800 to 1447' cement from 1447' to 1342' filled with cement and to 1365' drove wood plug from 1365' cemented from 1362 to 1357' shot pipe off at 1300' pulled 7-1/2" casing, drove wood plug at 485' cemented from 485' to 490' filled with clay 7-1/2" to surface.  
 Manner in which coal was plugged:

DEC 1938

Description of monument: All exact concrete marker as shown on plan is set down.

(THE ABOVE DESCRIPTION MUST BE IN DETAIL AND IN ACCORDANCE WITH THE PROVISIONS OF SECTION 10, ARTICLE 6, CHAPTER 22 OF THE CODE) and that the work of plugging and filling said well was completed on the \_\_\_\_\_ day of \_\_\_\_\_ 1938.

And further deponents saith not.

*E. H. ...*

Permit No. \_\_\_\_\_

Company **Hope Construction & Refining Company**  
 Address **Clarkburg, W. Va.**  
 Farm **S. W. Stout** Acres **1427**  
 Location (waters) **South Fork Hughes River**  
 Well No. **1284** Elev. **1082**  
 District **Southwest** County **Doddridge**  
 The surface of tract is owned in fee by **S. W. Stout**  
 Address **Clarkburg, W. Va.**  
 Mineral rights are owned by \_\_\_\_\_  
 Address \_\_\_\_\_  
 Drilling commenced **8-7-1930**  
 Drilling completed **4-30-1932** Depth of sink **800-813**  
 Date shut **7-17-1934**  
 Open Pipe \_\_\_\_\_  
 Values \_\_\_\_\_  
 Rod Pressure \_\_\_\_\_  
 Oil \_\_\_\_\_  
 Fresh water \_\_\_\_\_  
 Salt water \_\_\_\_\_

Production	Color	Depth of Well	Top	Bottom	Oil Gas or Water	Depth Found	Remarks
Red Sand		800		1150			
Dark Sand		1150		1190			
Salt Sand		1200		1200			
Shale Sand		1290		1290			
Big Sand		1290		1290			
Big Sand & coal		1290		1290			
Carbon Shale Sand		1290		1290			
Carbon Sand		1290		1290			
		Total Depth		1290			

*...*