


LATITUDE 39° 15'

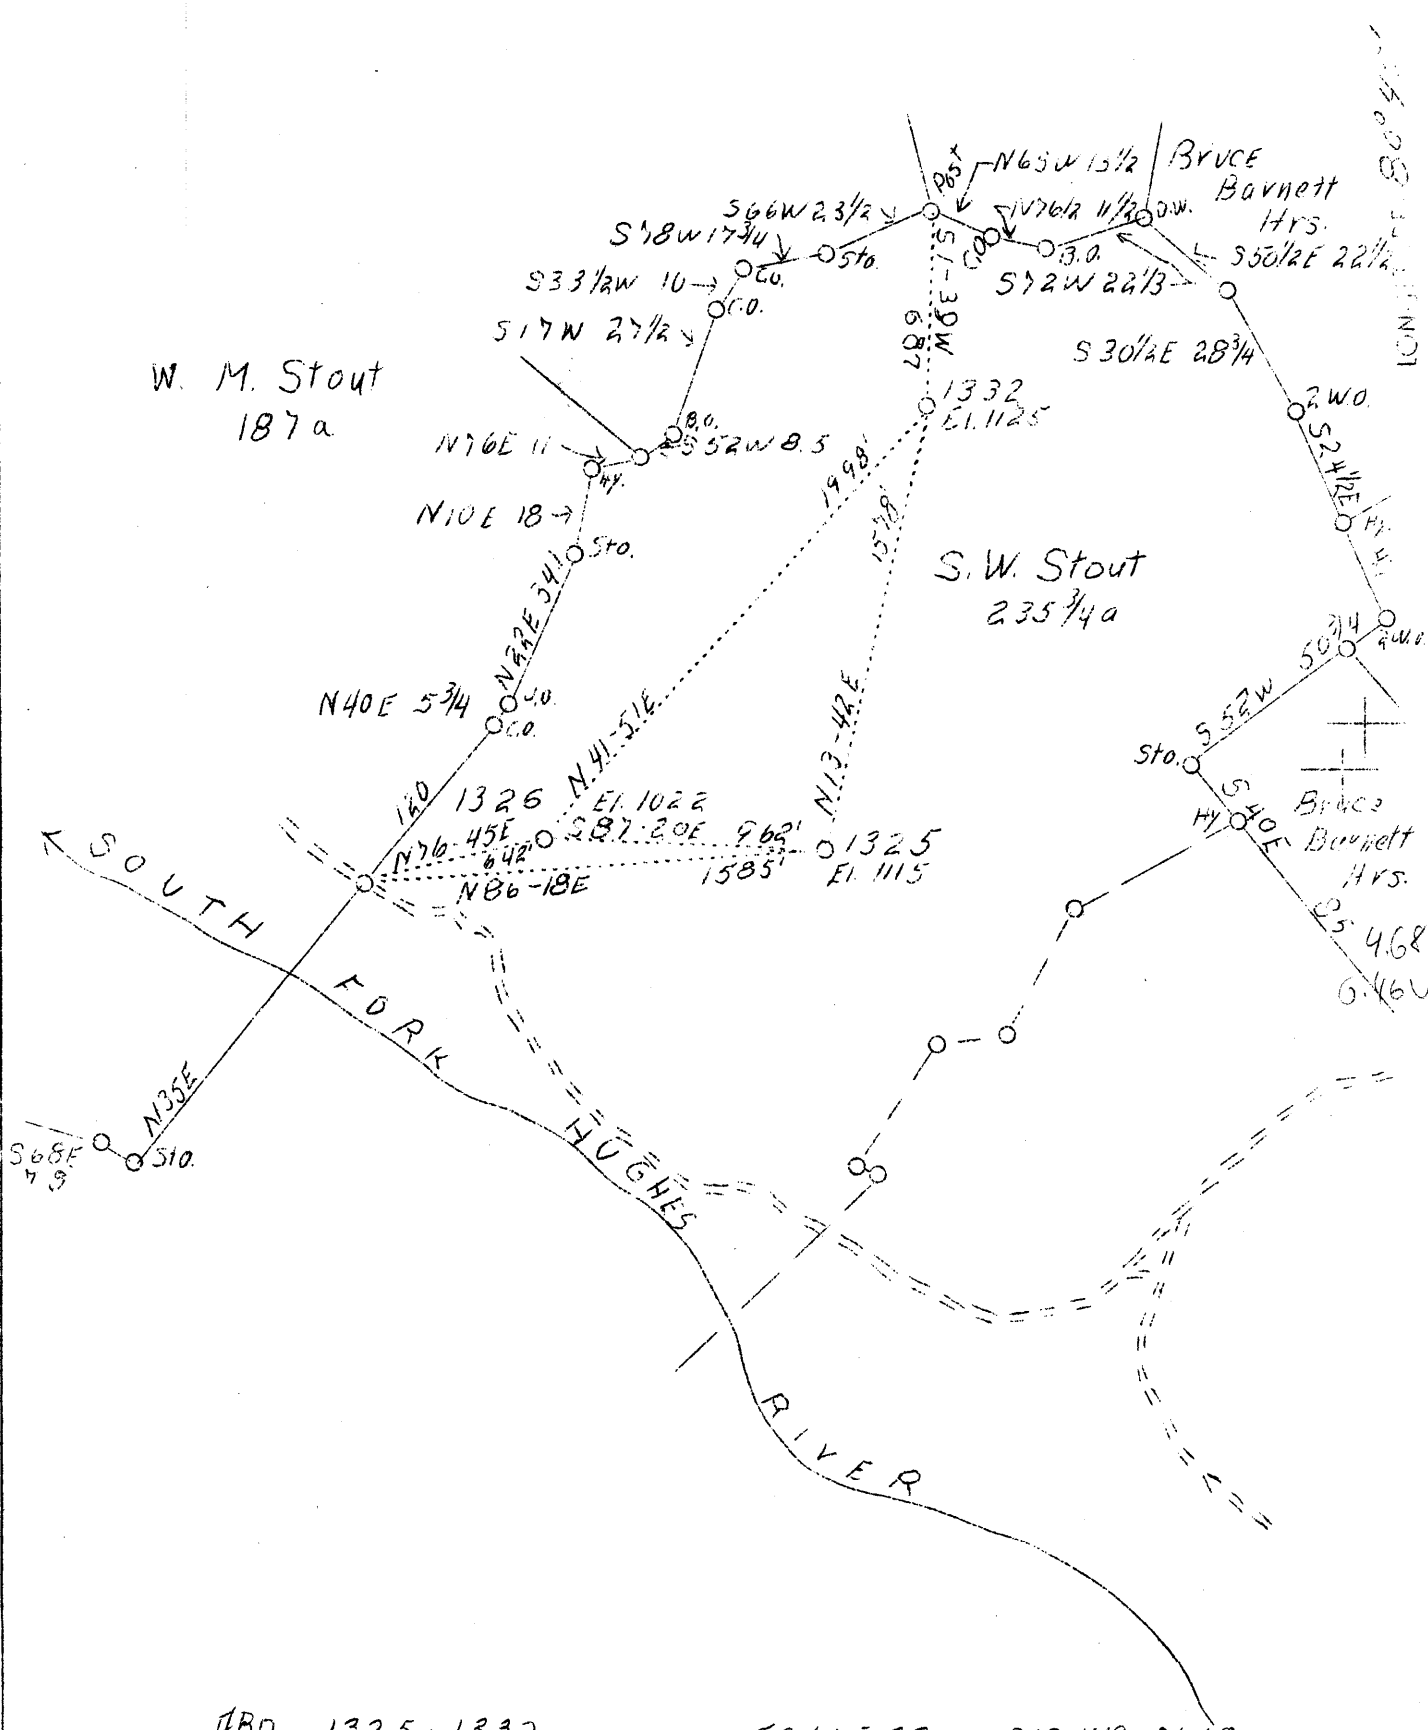

ABD. 1325-1332

F.B. 665 P 21 S18 W9 31.68

Company	Hope Const. & Ref. Co.
Address	Clarksburg, W. Va.
Farm	S. W. Stout
Acres	1427
Lease No.	C - 6197
Serial No.	1332-1325-1326
Elev. (Spirit Level)	Shown above
Quadrangle	Holbrook
County	Doddridge
District	New Milton
Eng.	W. M. Bowers
Eng. Reg. No.	900
Date	9 - 16 - 38
Scale	1" = 40 Po.

STATE OF WEST VIRGINIA
 Department of Mines
 OIL AND GAS DIVISION
 Charleston

WELL LOCATION MAP

File No. Dod-245-A
 well # 1325

x Denotes location of well on U. S. Topographic Maps, scale 1 to 62,500, latitude and longitude lines being represented by border lines as shown.

- Denotes one inch spaces on border line of original tracing.

WEST VIRGINIA DEPARTMENT OF MINES
OIL AND GAS DIVISION

WELL RECORD

202

Ab 215-A

Permit No. _____

Oil or ~~Gas~~ Well Oil
(Kind)

Company Hope Construction & Refining Co.
 Address 445 West Main St. Clarksburg, W. Va.
 Farm S. W. Stout Acres 1427
 Location (waters) SF Hughes River
 Well No. 1325 Elev. 1115'
 District Southwest County Doddridge
 The surface of tract is owned in fee by _____
 Address _____
 Mineral rights are owned by _____
 Address _____
 Drilling commenced Nov. 13, 1899
 Drilling completed Jan. 7, 1900
 Date shot June. 4, 1919 Depth of shot 2590
 Open Flow /10ths Water in _____ Inch
 /10ths Merc. in _____ Inch
 Volume _____ Cu. Ft.
 Rock Pressure _____ lbs. _____ hrs.
 Oil _____ bbls., 1st 24 hrs.
 Fresh water None recorded feet _____ feet
 Salt water None recorded feet _____ feet

Casing and Tubing	Used in Drilling	Left in Well	Packers
Size			
16			Kind of Packer
13			
10	455	86	Size of
8 1/4	1215	Pulled	
6 5/8	1900	1900	Depth set
5 5/16"	2615	2615	
3			Perf. top
2	2620	2620	Perf. bottom
Liners Used			Perf. top
			Perf. bottom

Not Cemented
 CASING CEMENTED _____ SIZE _____ No. FT. _____ Date _____
No Coal
 COAL WAS ENCOUNTERED AT _____ FEET _____ INCHES
 _____ FEET _____ INCHES _____ FEET _____ INCHES
 _____ FEET _____ INCHES _____ FEET _____ INCHES

Formation	Color	Hard or Soft	Top	Bottom	Oil Gas or Water	Depth Found	Remarks
Red Rock			900	1100			
First Cow Run			1150	1180			
First Salt Sand			1375	1575			
Maxon Sand			1735	1760	Gas	1745	
Pencil Cave			1885	1890			
Big Lime			1890	1990			
Big Injun Sand			1990	2090	Show oil	1990	
Gordon Stray			2575	2590			
Gordon Sand			2597	2602	Oil	2597	
Total Depth				2620			

