


39 12 30

LATITUDE

20 45

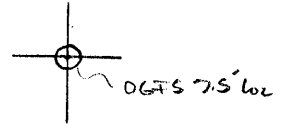

LONGITUDE

7.5 OGIS topo location

7.5' loc 0.92 S 15' loc _____
 ' 0.45 W (calc.) _____

Company _____

Farm _____

Quad Oxford _____

County _____

District Southwest _____

WELL LOCATION MAP

File No. 017-30256

STATE OF WEST VIRGINIA
DEPARTMENT OF MINES
OIL AND GAS DIVISION

204

WELL RECORD

Permit No. 909-256-A

Oil or ~~gas~~ Well Oil
(Kind)

Company Hope Construction & Refining Co.
Address 445 West Main St. Clarksburg, W. Va.
Farm W.M. Stout Acres 340
Location (waters) SF. Hughes River
Well No. 1349 Elev. 1000
District Southwest County Doddridge
The surface of tract is owned in fee by _____
Address _____
Mineral rights are owned by _____
Address _____
Drilling commenced May 19, 1903
Drilling completed July 9, 1903
Date shot July 1903 Depth of shot 2440
Open Flow /10ths Water in _____ Inch
/10ths Merc. in _____ Inch
Volume _____ Cu. Ft.
Rock Pressure _____ lbs. _____ hrs.
Oil None recorded bbls., 1st 24 hrs.
Fresh water _____ feet
Salt water 1200 feet

Casing and Tubing	Used in Drilling	Left in Well	Packers
Size			Kind of Packer
16			
13			
10	350	350	Size of
8 1/2	1000	Pulled	
6 5/8	1265	1265	Depth set
5 3/16	1665	1665	
3			Perf. top
2	2464	2464	Perf. bottom
Liners Used			Perf. top
			Perf. bottom


Not cemented

CASING CEMENTED _____ SIZE _____ No. FT. _____

None recorded

COAL WAS ENCOUNTERED AT _____ FEET _____ INCHES
_____ FEET _____ INCHES
_____ FEET _____ INCHES

Formation	Color	Hard or Soft	Top	Bottom	Oil Gas or Water	Depth Found	Remarks
Red Rock Cave			895	995			
First Cow Run Sand			995	1040			
First Salt Sand			1190	1255	Water	1200	
Second Salt Sand			1395	1440			
Maxon Sand			1520	1530			
Pencil Cave			1710	1720			
Big Line			1720	1780			
Big Injun Sand			1780	1855	Gas	1845	
Berea Sand			2020	2135			
Cave			2418	2424			
Gordon Stray			2424	2434			
Gordon Sand			2439	2445	Oil	2441	
Total Depth				2464			

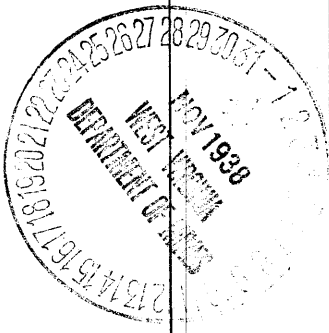

NOV 10 1903

Formation	Color	Hard or Soft	Top	Bottom	Oil, Gas or Water	Depth Found	Remarks

Date October 31, 1938, 19...

APPROVED Hope Construction & Refining Co., Own

By *W. Reed* Asst. Gen. Supt.
(Title)