


LATITUDE 39° 25'

LONGITUDE 80° 25'

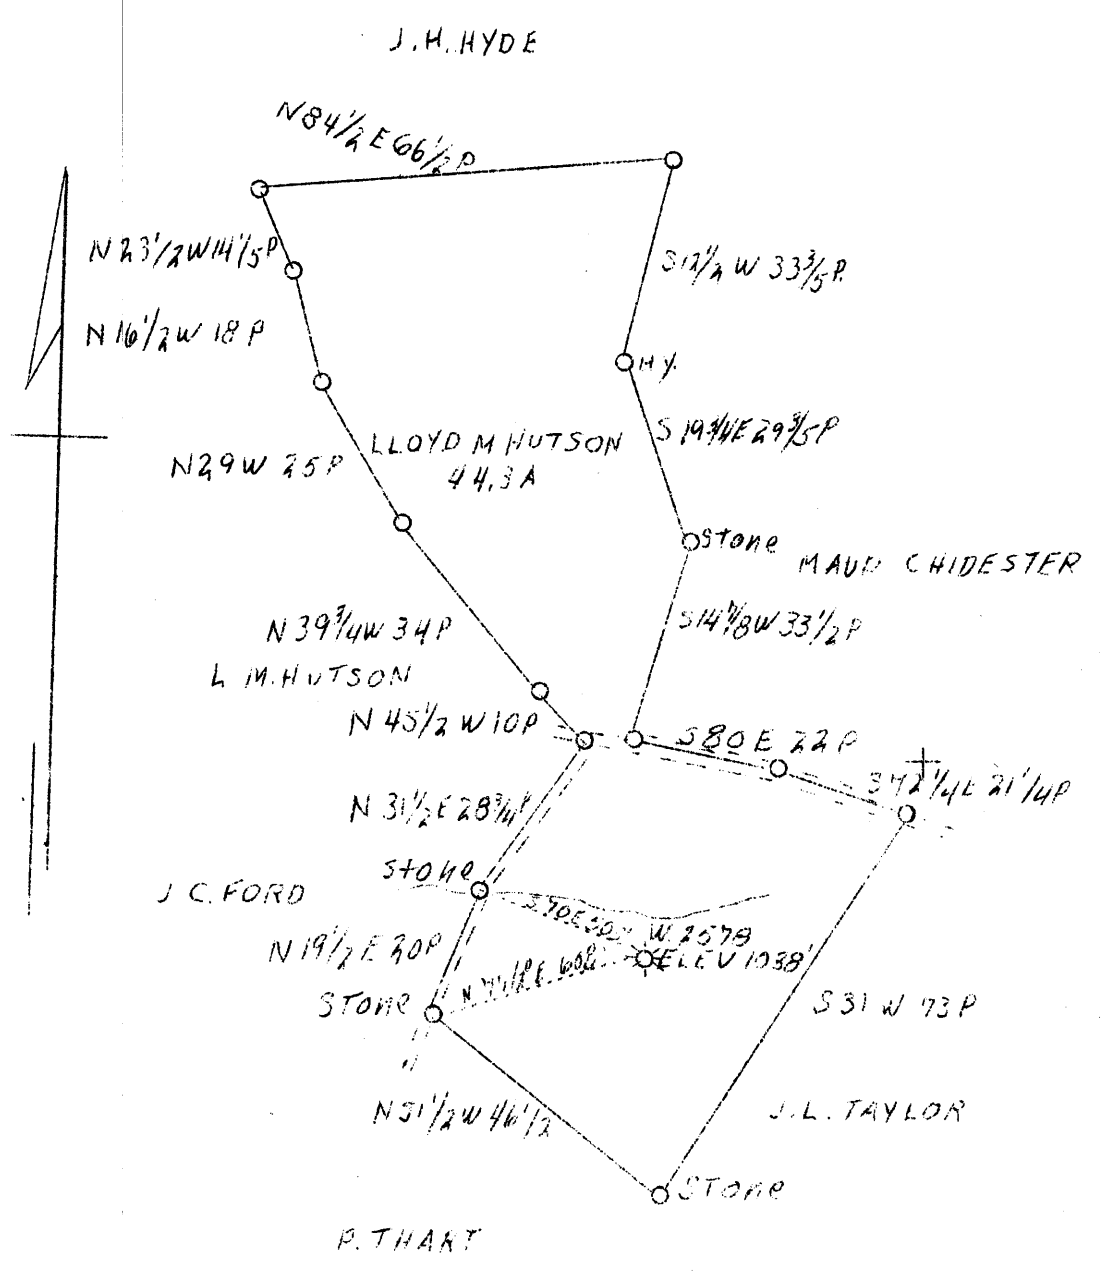

W - 2.02
S - 5.00

Coal owned by Flint Creek Fuel Co.
Well ABU

Company Address	The Mfg. Light & Heat Co. 800 Union Trust Bldg., Pittsburgh, Pa.	STATE OF WEST VIRGINIA Department of Mines OIL & GAS DIVISION Charleston
Farm	Lloyd M. Hutson & Mary C. Hutson ux	WELL LOCATION MAP File No. <u>Prod-267-A</u>
Acres	44.3	
Lease No.	7342	x Denotes location of well on U. S. Topographic Maps, scale 1 to 62,500, latitude and longitude lines being represented by border lines as shown. - Denotes one inch spaces on border line of original tracing.
Well (Farm) No.	One	
Serial No.	2578	
Elevation (SL)	1038	
Quadrangle	Centerpoint S. E. 1-1/4	
County	Doddridge	
District	McClellan	
Engineer	J. C. Mercer	
Date	Jan. 6, 1939	
Scale	1" - 500'	

STATE OF WEST VIRGINIA
DEPARTMENT OF MINES
OIL AND GAS DIVISION

210

WELL RECORD

Permit No. DDO-267-A

Oil or Gas Well Gas
(Kind)

Company The Manufacturers Light & Heat Co.
Address 800 Union Trust Bldg., Pittsburgh, Pa.
Farm L M Hutson Acres 45
Location (waters) _____
Well No. 2578 (1) Elev. 1038'
District McClellan County Doddridge
The surface of tract is owned in fee by _____
W. E. Ford Address R D 3 Salem, WVa.
Mineral rights are owned by The Mfrs. Light & Heat Company Address Pittsburgh, Pa.
Drilling commenced Nov. 4, 1920
Drilling completed Jan. 3, 1921
Date shot _____ Depth of shot _____
Open Flow 28 /10ths Water in _____ Inch
_____ /10ths Merc. in _____ Inch
Volume _____ 56 McF Cu. Ft.
Rock Pressure 130 lbs. _____ hrs.
Oil _____ bbls., 1st 24 hrs.
Fresh water _____ feet _____ feet
Salt water _____ feet _____ feet

Casing and Tubing	Used in Drilling	Left in Well	Packers
Size			
16			Kind of Packer
13			
10	<u>227</u>		Size of
8 1/4	<u>1084.6"</u>	<u>1084.6"</u>	
6 5/8	<u>1835.8"</u>	<u>1835.8"</u>	Depth set
5 3/16			
3			Perf. top
2			Perf. bottom
Liners Used			Perf. top
			Perf. bottom

CASING CEMENTED _____ SIZE _____ No. FT. _____ Date _____

COAL WAS ENCOUNTERED AT 517 FEET 96 INCHES

_____ FEET _____ INCHES _____ FEET _____ INCHES

_____ FEET _____ INCHES _____ FEET _____ INCHES

Formation	Color	Hard or Soft	Top	Bottom	Oil Gas or Water	Depth Found	Remarks
Pittsburgh Coal			517	525			
Big Lime <i>Sumner</i>			1082	1105			
Bas Sand			1290	1332			
1st Salt Sand			1420	1445			
2nd Salt Sand			1550	1665			
Maxon Sand			1735	1750			
Little Lime			1775	1790			
Pencil Cave			1800	1815			
Big Lime			1815	1873			
Big Injun sand			1873	2000	Gas 1885-1890		
Berea Grit			2130	2168	" 1923-1928		
Blue Monday			2200	2220			
50-Foot Sand			2372	2386			
Gordon Sand			2679	2685			
Fourth Sand			2797	2800			
Slate			2800	2868			
Total depth				2868			