


LATITUDE 39° 20'

LONGITUDE 80° 50'

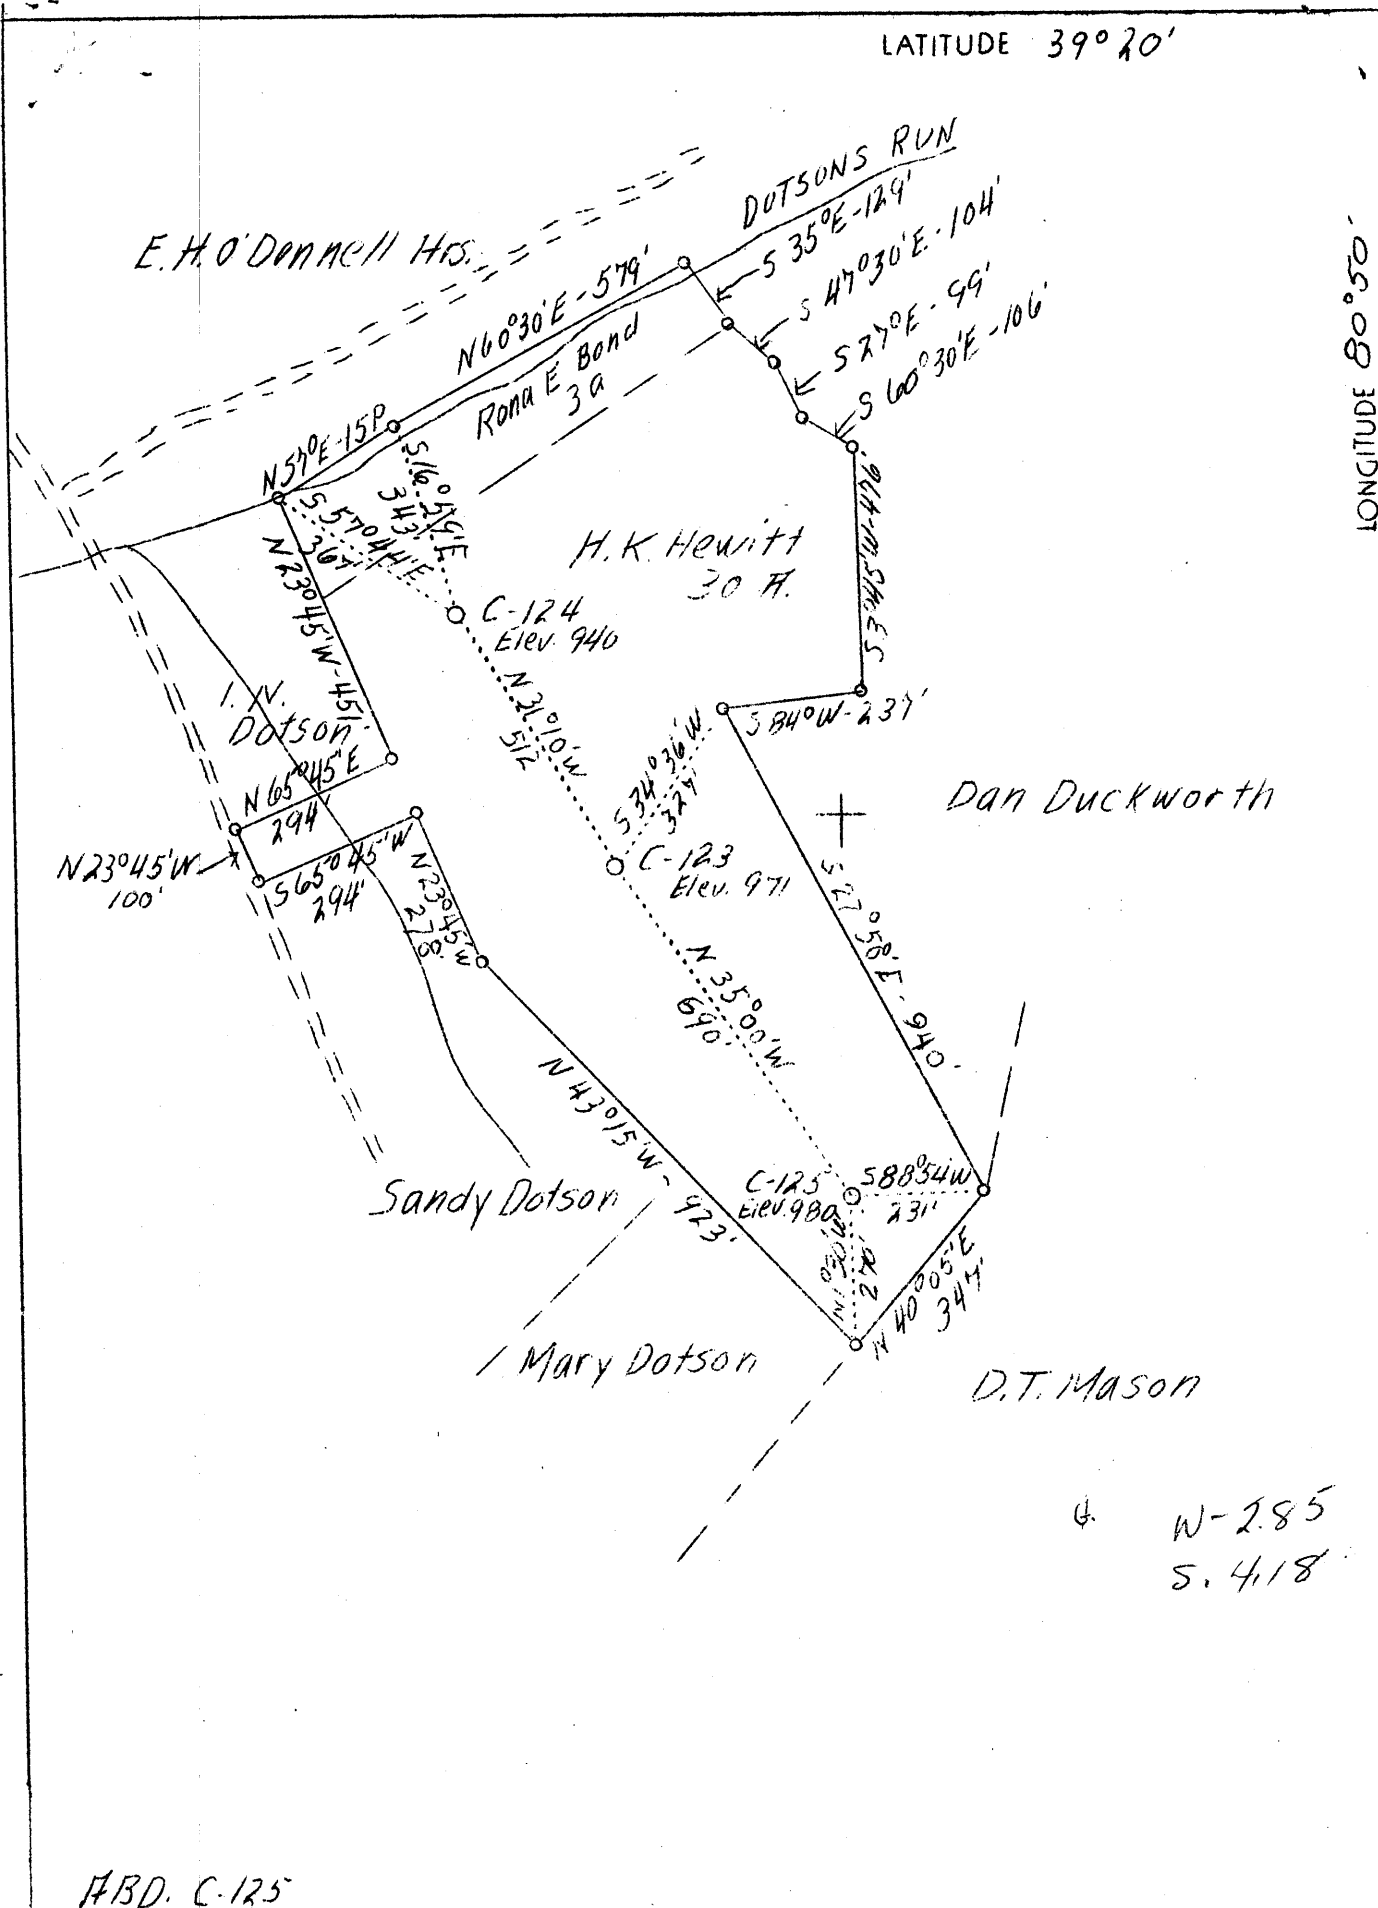

W-285
S. 418

ABD. C-125

| | | |
|--------------------|-------------------------|--|
| Company | Hope Constr. & Ref. Co. | STATE OF WEST VIRGINIA |
| Address | Clarksburg, W.Va. | Department of Mines |
| Farm | Henry K. Hewitt | OIL AND GAS DIVISION |
| Acres | 30 | Charleston |
| Lease No. | 23955 | WELL LOCATION MAP |
| Well (Farm) No. | 1 - 2 - 3 | File No. <u>110d-272473-A</u> |
| Serial No. | C-123 C-124 C-125 | <u>WELL # 123 & 124</u> |
| El. (Spirit Level) | 971 - 940 - 980 | x Denotes location of well on U.S. Topographic Maps, scale 1 to 62,500, latitude and longitude lines being represented by border lines as shown. |
| Quadrangle | West Union | - Denotes one inch spaces on border line of original tracing. |
| County | Doddridge | |
| District | Central | |
| Eng. | J.A. Clark | |
| Eng. Reg. No. | 744 | |
| Date | 1/6/38 | |
| Scale | 1" - 20 P. | |