


LATITUDE 39° 20'

LONGITUDE 80° 50'

DOTSON RUN DUCKWORTH

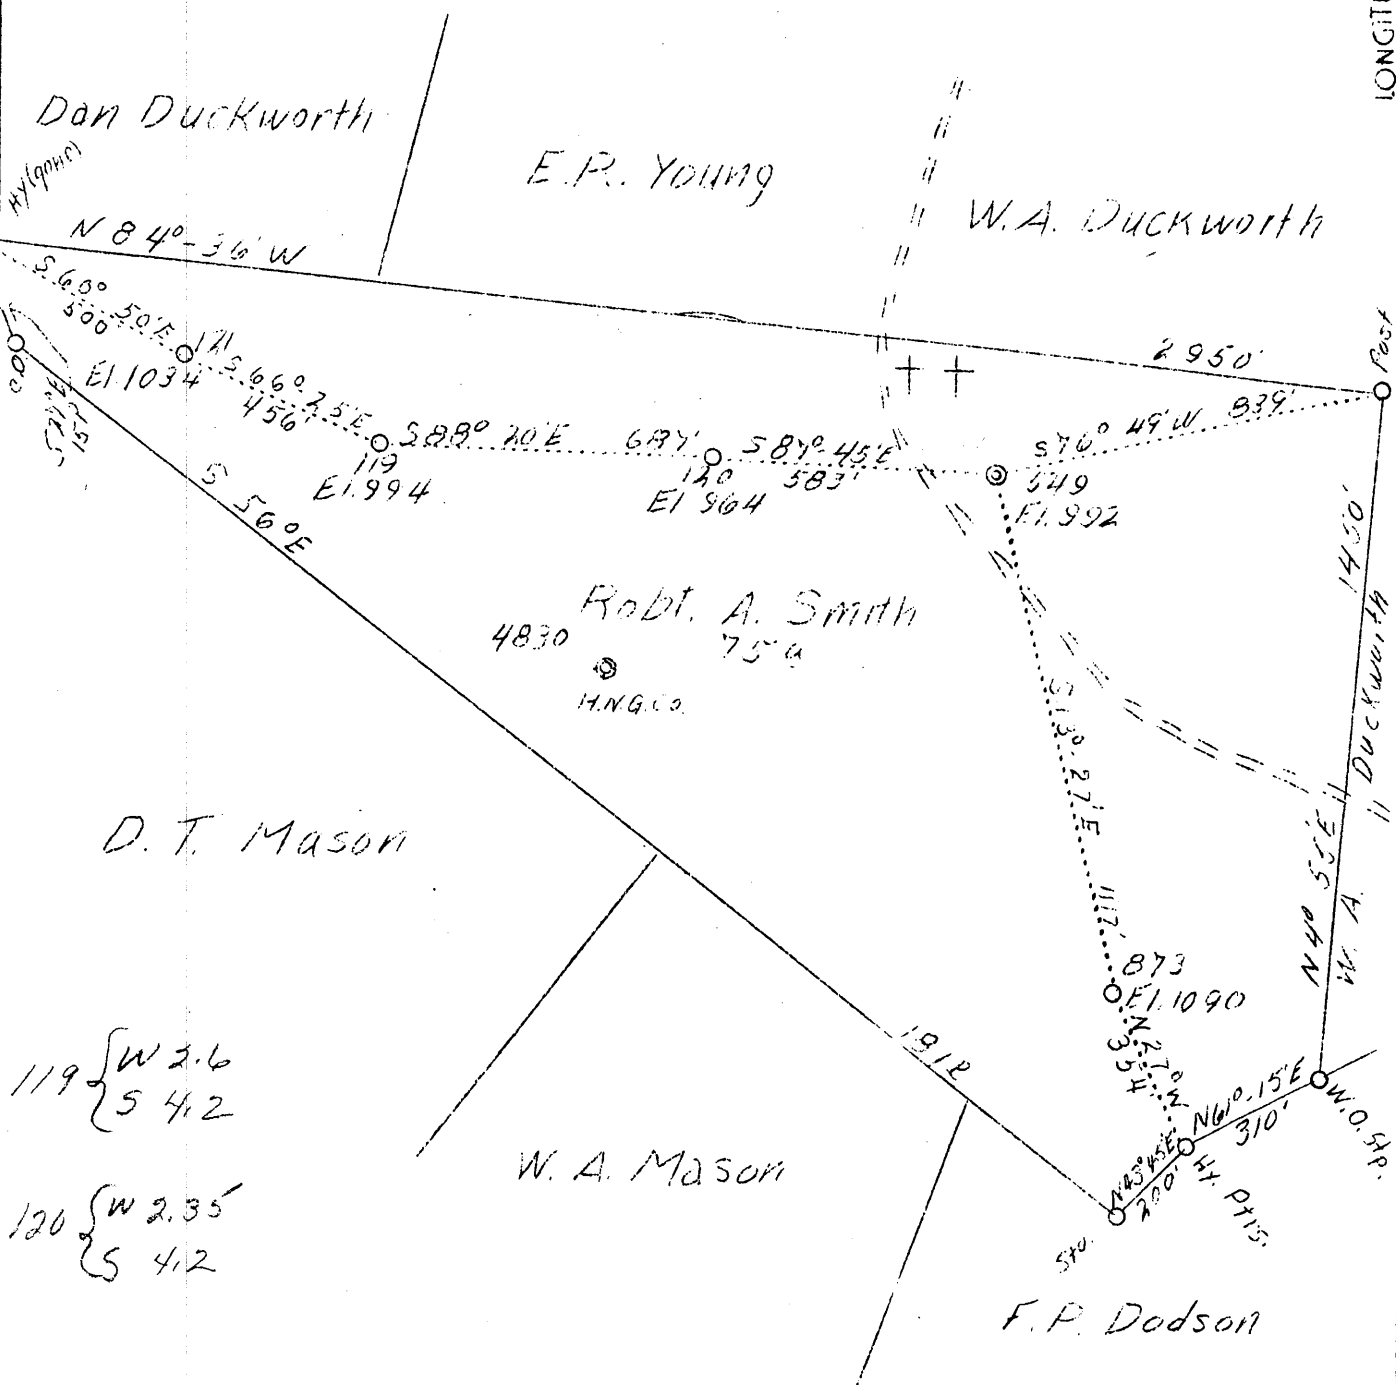

119 { W 2.6
 S 4.2

120 { W 2.35
 S 4.2

ABD. 119-120

F.B. 386 P 40-598 1-512 W 15 - Sheet 67

Company	Hope Const. & Ref. Co.
Address	Clarksburg, W.Va.
Farm	Rob't. A. Smith
Tract	1
Acres	75
Serial No.	Sh'n Above
El. (Spirit Level) Shown Above	SC.
Quadrangle	West Union
County	Doddridge
District	Central
Eng.	W.M. Bowers
Eng. Reg. No.	900
Date	9/6/38
Scale	1" = 400'

STATE OF WEST VIRGINIA
 Department of Mines
 OIL AND GAS DIVISION
 Charleston

WELL LOCATION MAP

File No. Do 1-774-275-A

x Denotes location of well on U.S. Topographic Maps, scaled 1 to 62,500, latitude and longitude lines being represented by border lines as shown.

- Denotes one inch spaces on border line of original tracing.

Formation	Color	Hard or Soft	Top	Bottom	Oil, Gas or Water	Depth Found	Remarks

Date.....January 23,....., 19.23

APPROVED Hope Construction & Refining Co., Owner

By.....*W. Reed*..... General Supt.

(Title) *MR*