


Latitude 39 15

Longitude 80 35

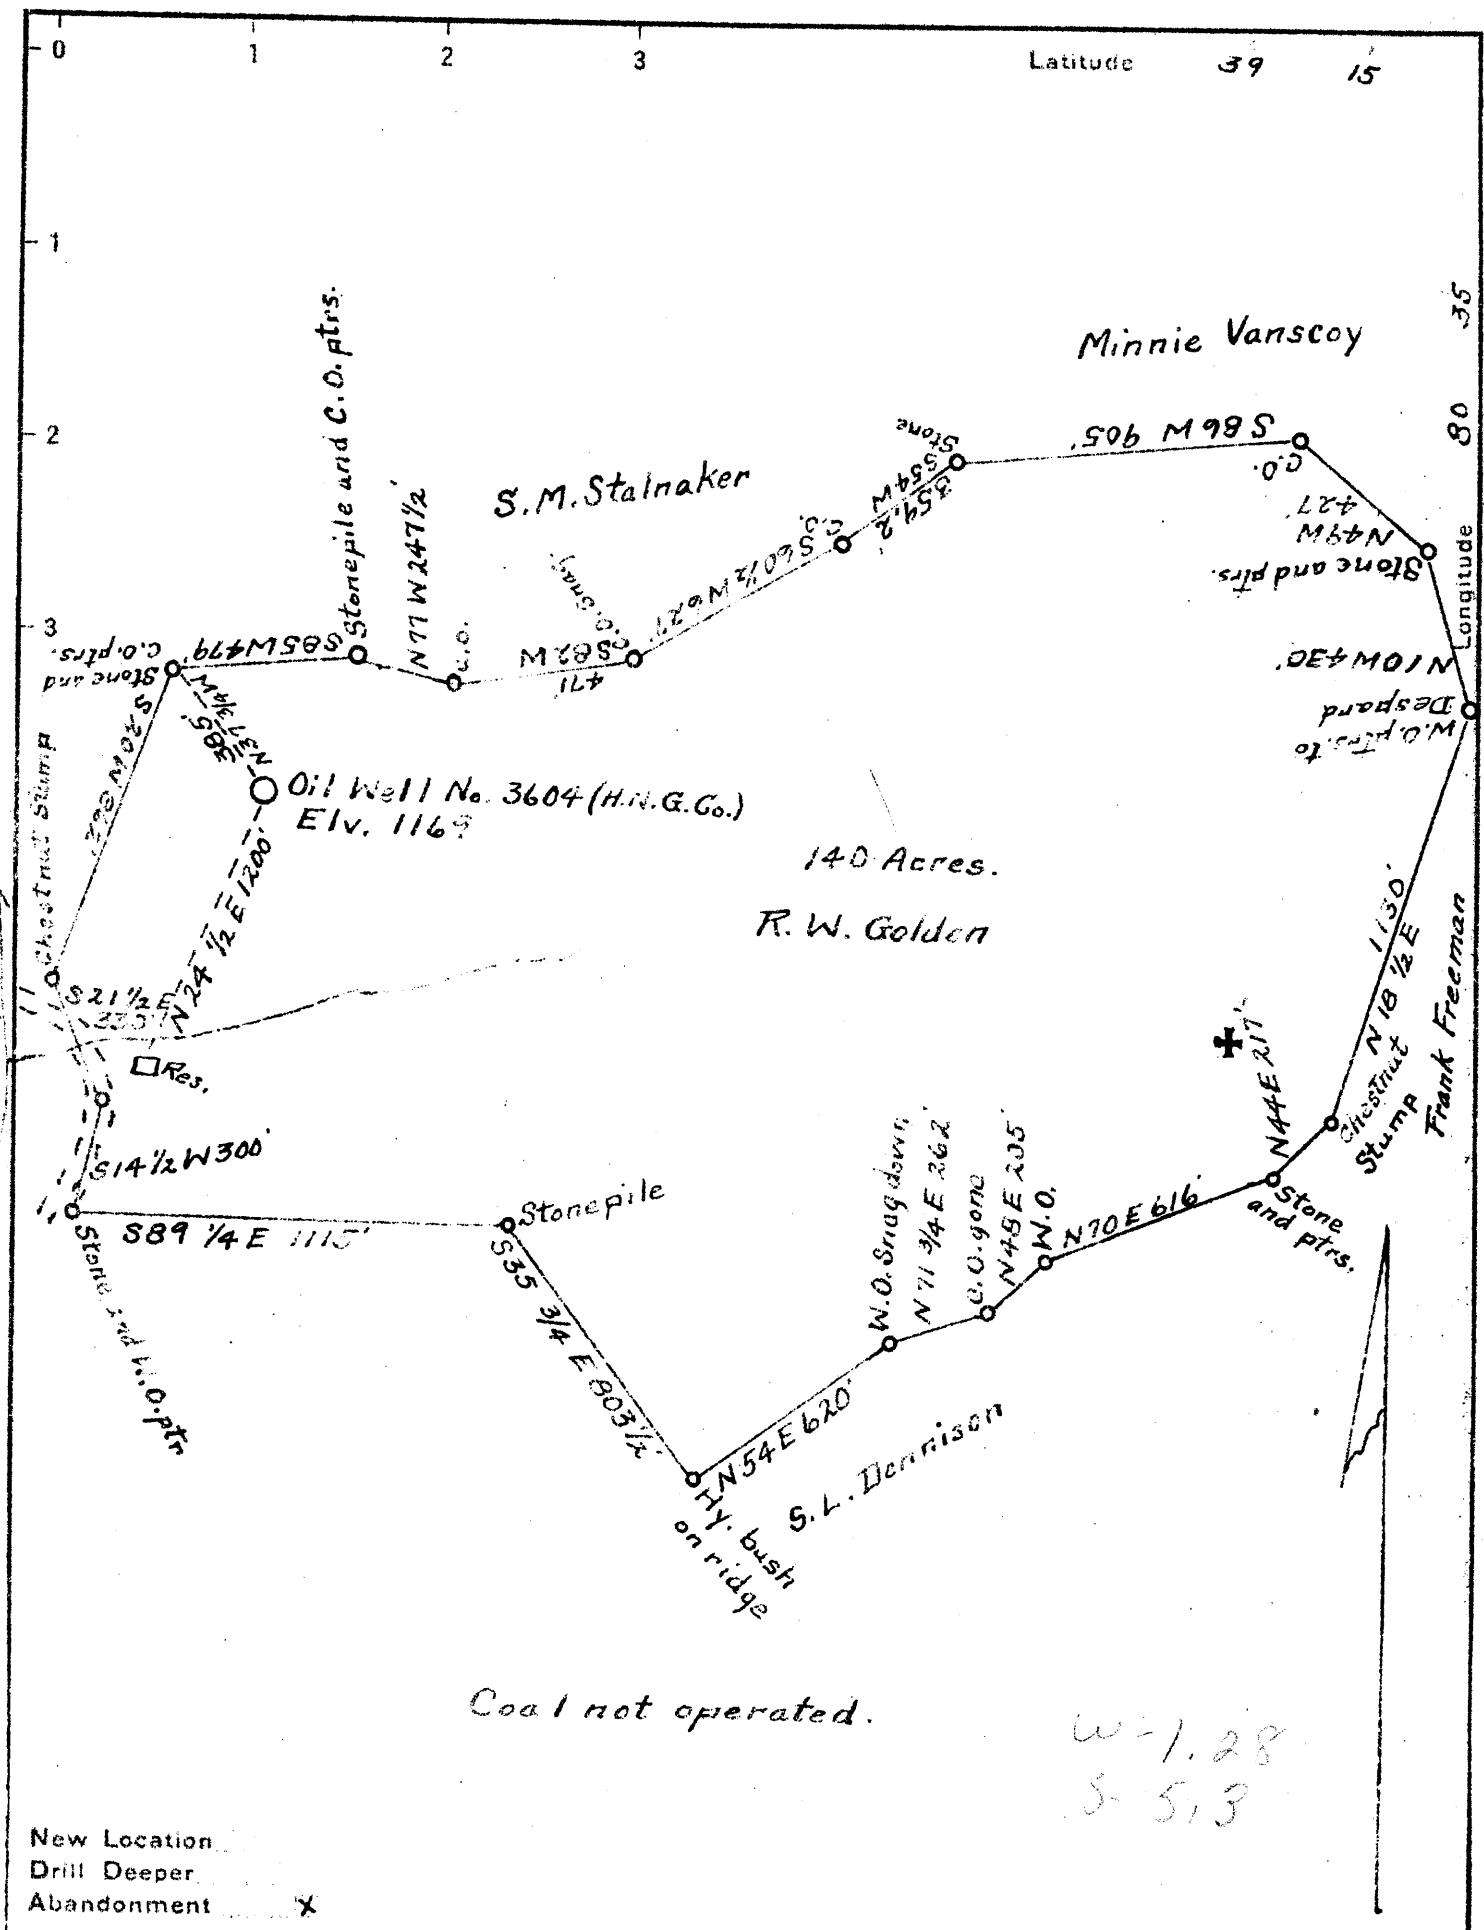

New Location
 Drill Deeper
 Abandonment

Company J. M. Raad
 Address Salem, W. Va.
 Farm R. W. Golden
 Tract _____ Acres 140 Lease No. _____
 Well (Farm) No. _____ Serial No. 3604
 Elevation (Spirit Level) 1169
 Quadrangle Vadis
 County Doddridge District Greenbrier
 Engineer C. C. Fittro, C.E.
 Engineer's Registration No. 818
 File No. XYZ Drawing No. 142
 Date Nov. 13, 1939 Scale 500 Ft. = 1 inch

STATE OF WEST VIRGINIA
 DEPARTMENT OF MINES
 OIL AND GAS DIVISION
 CHARLESTON

WELL LOCATION MAP
 FILE NO. DOD-304A

+ Denotes location of well on United States Topographic Maps, scale 1 to 62,500, latitude and longitude lines being represented by border lines as shown.

- Denotes one inch spaces on border line of original tracing.