

Company South Penn Natural Gas Co.  
 Address Parkersburg, West Ya.  
 Farm Jacob Underwood  
 Tract \_\_\_\_\_ Acres 300 Lease No. 9003  
 Well (Farm) No. 6<sup>nd</sup> 8 Serial No. \_\_\_\_\_  
 Elevation (Spirit Level) 6=1189.30 8=1151.30  
 Quadrangle Centerpoint  
 County Doddridge District Grant  
 Engineer E.C. Tabler  
 Engineer's Registration No. \_\_\_\_\_  
 File No. \_\_\_\_\_ Drawing No. \_\_\_\_\_  
 Date Apr. 16, 1940 Scale 1"=400'

STATE OF WEST VIRGINIA  
 DEPARTMENT OF MINES  
 OIL AND GAS DIVISION  
 CHARLESTON

**WELL LOCATION MAP**  
 FILE NO. DOD-315A & 316A  
 Was: 017 90001 4 uses 017 90004

+ Denotes location of well on United States Topographic Maps, scale 1 to 62,500, latitude and longitude lines being represented by border lines as shown.  
 - Denotes one inch spaces on border line of original tracing.

STATE OF WEST VIRGINIA  
DEPARTMENT OF MINES  
OIL AND GAS DIVISION

259

WELL RECORD


Permit No. **315-A**

Oil or Gas Well.....  
(Kind)

Company.....	<b>South Penn Natural Gas Company</b>		Casing and Tubing	Used in Drilling	Left in Well	Packers
Address.....	<b>Union Trust Bldg., Parkersburg, W. Va.</b>		Size			
Farm.....	<b>Jacob Underwood</b>	Acres.....	16			
		<b>300</b>	13			
Location (waters).....	---		10			
Well No.....	<b>6</b>	Elev.....	8 1/4	<b>1300' (Pulled)</b>		Kind of Packer.....
		<b>1189.30</b>	6%	<b>2209'</b>		Size of.....
District.....	<b>Grant</b>	County.....	5 3/16			Depth set.....
		<b>Doddridge</b>	3			Perf. top.....
The surface of tract is owned in fee by.....	<b>Henry L. Ferrebee</b>		2			Perf. bottom.....
	<b>R.D. No. 2,</b>		Liners Used.....			Perf. top.....
	Address.....					Perf. bottom.....
	<b>West Union, W. Va.</b>					
Mineral rights are owned by.....	<b>Wm. W. Ash, et al.</b>					
<b>RPD#1, Grasselli Add.</b>	Address.....					
	<b>Clarksburg, W. Va.</b>					
Drilling commenced.....	<b>July 7, 1897</b>					
Drilling completed.....	<b>Oct. 14, 1897</b>					
Date shot.....	<b>(See below)</b>					
Open Flow.....	/10ths Water in.....	Inch.....				
	/10ths Merc. in.....	Inch.....				
Volume.....	---	Cu. Ft.....				
Rock Pressure.....	---	lbs.....				
Oil.....	<b>30</b>	bbls., 1st 24 hrs.....				
Fresh water.....	---	feet.....				
Salt water.....	---	feet.....				

CASING CEMENTED..... SIZE..... No. Ft..... Date.....  
COAL WAS ENCOUNTERED AT **879** FEET **12(?)** INCHES  
--- FEET --- INCHES --- FEET --- INCHES  
--- FEET --- INCHES --- FEET --- INCHES

Formation	Color	Hard or Soft	Top	Bottom	Oil, Gas or Water	Depth Found	Remarks
Pittsburgh Coal			879	(?)			
Injun Sand			2224(?)	-	Oil	2300	
<b>Total Depth</b>				<b>2320</b>			
(Only original record available)							
<b>SHOT RECORD.</b>							
			Apr. 4, 1899-	20	Qts.		
			Oct. 24, 1900-	24	"		
			Aug. 27, 1903-	30	"		
			July 16, 1908-	40	"		

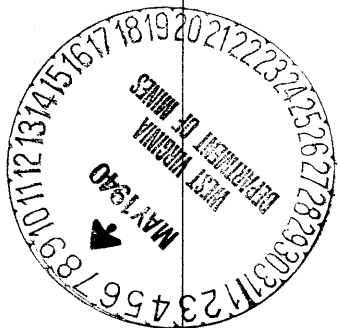



.....District, Doddridge County, W. Va.  
By South Penn Oil Co.  
Near Tyler County Line.

	Top.	Bottom.
Pittsburgh Coal	879	
Big Injun Sand (top) (oil, 2300')	2224	
Total depth		2320