


LATITUDE

LONGITUDE

55  
20 35

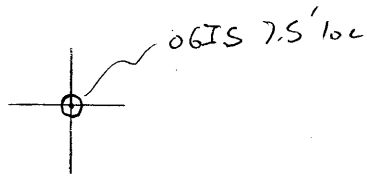

7.5 OGIS topo location

7.5' loc	<u>2.315</u>	15' loc	_____
	<u>1.71W</u>	(calc.)	_____

Company \_\_\_\_\_

Farm \_\_\_\_\_

Quad Big ISAAC 7.5'

County \_\_\_\_\_

District Breenbrier

WELL LOCATION MAP

File No. 017-326A

STATE OF WEST VIRGINIA  
DEPARTMENT OF MINES  
OIL AND GAS DIVISION

266

000 - 326 A

WELL RECORD

Permit No. ....

Oil or Gas Well Oil  
(Kind)

Company William Moses  
Address 189 W. Main St., Salem, W. Va.  
Farm Stalnaker Heirs Acres 290  
Location (waters) .....  
Well No. 153 Elev. 941  
District Greenbriar County Doddridge  
The surface of tract is owned in fee by Hope Construction & Refining Co. Address Clarksburg, W. Va.  
Mineral rights are owned by Wilbur Coal and Coke Co. Address Pa.  
Drilling commenced .....  
Drilling completed .....  
Date shot ..... Depth of shot .....  
Open Flow /10ths Water in ..... Inch  
/10ths Merc. in ..... Inch  
Volume ..... Cu. Ft.  
Rock Pressure ..... lbs. .... hrs.  
Oil ..... bbls., 1st 24 hrs.  
Fresh water ..... feet ..... feet  
Salt water ..... feet ..... feet

Casing and Tubing	Used in Drilling	Left in Well	Packers
Size			Kind of Packer
16			
13			Size of
10		1340'	Depth set
8 1/4		1504'	
6		1923'	Perf. top
5 3/16			Perf. bottom
3		2007'	Perf. top
2			Perf. bottom
Liners Used			

CASING CEMENTED ..... SIZE ..... No. Ft. .... Date

COAL WAS ENCOUNTERED AT 505 FEET ..... INCHES  
..... FEET ..... INCHES ..... FEET ..... INCHES  
..... FEET ..... INCHES ..... FEET ..... INCHES

Formation	Color	Hard or Soft	Top	Bottom	Oil, Gas or Water	Depth Found	Remarks
Pittsburgh Coal			505	510			
Dunkard			915	1035			
Salt Sand			1300				
Big Injun			1961	2024			
Total Depth			1991				

(Over)

AUG 13 1940

Greenbrier District, Doddridge County, W. Va.  
 By William Moses, 189 W. Main St., Salem, W. Va.  
 On 290 acres.

Elevation, 941' L.

Surface owned by Hope Construction & Refining Co., Clarksburg, W. Va.,  
 and minerals by Wilbur Coal & Coke Co., South Bethlehem, Pa.

8½" casing, 1340'; 6⅝", 1504'; 5⅜", 1923'; 2" tubing, 2007'.  
 Oil well. Abandonment reported to Dept. of Mines (not dated).

Record to RCT from Mrs. Griffith August 16, 1940.

Coal was encountered at 505-510'.

	Top.	Bottom.
Pittsburgh Coal	505	510
Dunkard Sand	915	1035
Salt Sand	1300	....
Big Injun Sand	1961	2024
Total depth		1991? (filled?)