


39 12 30

LATITUDE

80 35

LONGITUDE

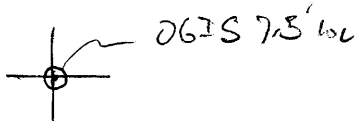

7'5 OGIS topo location

7.5' loc,	<u>2.06 S</u>	15' loc	_____
	<u>1.21 W</u>	(calc.)	_____

Company _____

Farm _____

Quad Big Isaac 7.5'

County _____

District Greenbrier

WELL LOCATION MAP

File No. 017-379A

STATE OF WEST VIRGINIA
DEPARTMENT OF MINES
OIL AND GAS DIVISION

268

000 - 329 - A

WELL RECORD

Permit No.

Oil or Gas Well Oil
(Kind)

Company William Moses
Address 189 W. Main St., Salem, W. Va.
Farm Stalnaker Heirs Acres 290

Location (waters)
Well No. 155 Elev. 931
District Greenbriar County Doddridge

The surface of tract is owned in fee by Hope Construction
& Refining Co. Address Clarksburg, W. Va.

Mineral rights are owned by Wilbur Coal and Coke Col
South Bethlehem, Pennsylvania.

Drilling commenced
Drilling completed
Date shot Depth of shot

Open Flow /10ths Water in Inch
/10ths Merc. in Inch

Volume Cu. Ft.
Rock Pressure lbs hrs.

Oil bbls., 1st 24 hrs.

Fresh water feet feet
Salt water feet feet

Casing and Tubing	Used in Drilling	Left in Well	Packers
Size			
16			Kind of Packer.....
13		71'	
10		295'	Size of.....
8 1/4			
6 5/8		1534'	Depth set.....
5 3/16		1907'	
3			Perf. top.....
2		1992'	Perf. bottom.....
Liners Used.....			Perf. top.....
			Perf. bottom.....

CASING CEMENTED..... SIZE..... No. Ft..... Date.....

COAL WAS ENCOUNTERED AT 502 FEET..... INCHES
..... FEET..... INCHES..... FEET..... INCHES
..... FEET..... INCHES..... FEET..... INCHES

Formation	Color	Hard or Soft	Top	Bottom	Oil, Gas or Water	Depth Found	Remarks
Pittsburgh Coal			502	507			
Dunkard			970	1055			
Salt Sand			1255	1610			
Big Injun			1953	1992			
Total Depth				2003			

Greenbrier District, Doddridge County, W. Va.
 By William Moses, 189 W. Main St., Salem, W. Va.
 On 290 acres.

Elevation, 931' L.

Surface owned by Hope Construction & Refining Co., Clarksburg, W.Va.,
 and minerals by Wilbur Coal & Coke Co., South Bethlehem, Pa.

13" casing, 71'; 10", 295'; 6⁵/₈", 1534'; 5³/₈", 1907'; 2" tubing, 1992'.

Coal was encountered at 502-507'.

Oil well. Abandonment reported to Dept. of Mines (not dated).

Record to RCT from Mrs. Griffith August 16, 1940.

	Top.	Bottom.
Pittsburgh Coal	502	- 507
Dunkard Sand	970	- 1055
Salt Sand	1255	- 1610
Big Injun Sand	1953	- 1992
Total depth		2003