

Latitude 39° 10' 00"

+
75'

39° 10' 00"

Longitude

Topo Location

7.5' Loc. $\frac{0.375}{1.58W}$ 15' Loc. $\frac{0.375}{1.58W}$
(calc.)

Company C-167

Farm J.A. DENNISON

15' Quad Vadis C
(sec.)

7.5' Quad BIG ISSAC


District GREENBRIER

WELL LOCATION PLAT

County 017 Permit 30333

Longitude 80

1
2
3

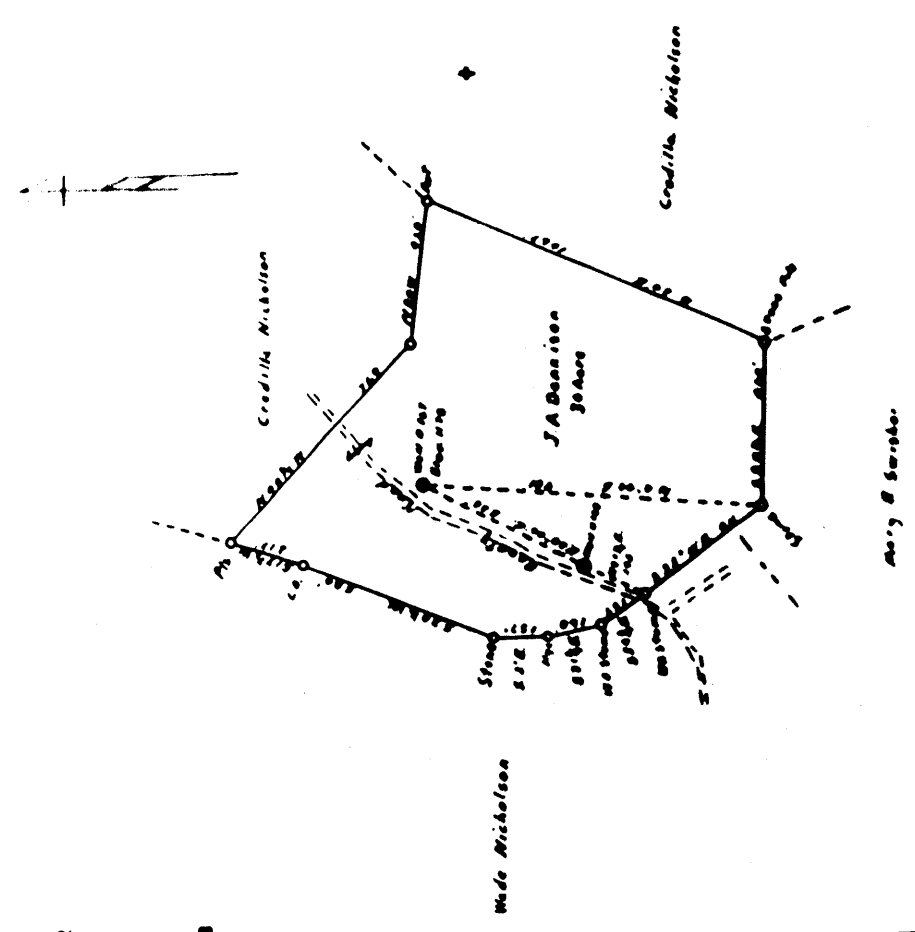

New Location
 Drill Deeper
 Abandonment

Company William Hanna
 Address 1211 Main St. Johns, Pa.
 Farm J.A. Dennis
 Tract Acres 31 Lot No. _____
 Well (Farm) No. 187 Series No. _____
 Elevation (Spirit Level) 1118
 Quadrangle Madis
 County Doddridge District Blaine
 Engineer G.H. McCarty

STATE OF WEST VIRGINIA
 DEPARTMENT OF MINES
 OIL AND GAS DIVISION
 CHARLESTON

WELL LOCATION MAP
 FILE NO. DOD-333A

◆ Shows location of well on United States
 Topographic Maps, scale 1 to 62,500. Lat-
 itude and longitude lines being represented
 by border lines as shown.

STATE OF WEST VIRGINIA
DEPARTMENT OF MINES
OIL AND GAS DIVISION

272

WELL RECORD

Permit No. 080-333-A

Oil or Gas Well Oil
(Kind)

Company <u>William Moses</u>	Casing and Tubing	Used in Drilling	Left in Well	Packers
Address <u>189 W. Main St., Salem, W. Va.</u>	Size			
Farm <u>J. A. Dennison</u> Acres <u>30</u>	16			Kind of Packer
Location (waters)	13			
Well No <u>167</u> Elev. <u>1178</u>	10		<u>392'</u>	Size of
District <u>Greenbrier</u> County <u>Doddridge</u>	8 1/4		<u>1465'</u>	Depth set
The surface of tract is owned in fee by <u>Hope Construction & Refining Co.</u> Address <u>Clarksburg, W. Va.</u>	6%		<u>1563'</u>	
Mineral rights are owned by <u>Wilbur Coal and Coke Co.</u> Address <u>South Bethlehem, Pennsylvania.</u>	5 3/16		<u>2143'</u>	
Drilling commenced	3			Perf. top
Drilling completed	2		<u>2216'</u>	Perf. bottom
Date shot	Liners Used			Perf. top
Open Flow /10ths Water in				Perf. bottom
/10ths Merc. in				
Volume	CASING CEMENTED	SIZE	No. Ft.	Date
Rock Pressure				
Oil	COAL WAS ENCOUNTERED AT	<u>707</u>	FEEET	INCHES
Fresh water			FEEET	INCHES
Salt water			FEEET	INCHES

Formation	Color	Hard or Soft	Top	Bottom	Oil, Gas or Water	Depth Found	Remarks
Pittsburgh Coal			707	712			
Dunkard	4		1135	1307			
Salt	1479		1479	1803			
Maxon	2034		2034 2046	2046			
Bime			2120	2175			
Big Injun			2175				
Total Depth			2216				

AUG 16 1940

Greenbrier District, Doddridge County, W. Va.

By William Moses, 189 W. Main St., Salem, W. Va.

On 30 acres.

Elevation, 1178' L.

Surface owned by Hope Construction & Refining Co., Clarksburg, W. Va.,
and minerals by Wilbur Coal & Coke Co., South Bethlehem, Pa.

10" casing, 392'; 8 1/4", 1465'; 6 3/8", 1563'; 5 1/8", 2143'; 2" tubing, 2216'.

Coal was encountered at 707-712'.

Oil well. Abandonment reported to Dept. of Mines (not dated).

Record to RCT from Mrs. Griffith August 16, 1940.

	Top.	Bottom.
Pittsburgh Coal	707	- 712
Dunkard Sand	1135	- 1307
Salt Sand	1479	- 1803
Maxton Sand	2034	- 2046
Lime	2120	- 2175
Big Injun Sand	2175	-
Total depth		2216

