

New Location
 Drill Deeper
 Abandonment

7.5 loc. 10/4/88 calc 15 loc
 0.91 S 301730 3.79 S
 0.58 W 8040 0.57 W

FB. 570 P-7 S12 W4 SHEET 59


Company HOPE NATURAL GAS CO.
 Address CLARKSBURG, W.VA.
 Farm I. L. STUTLER
 Tract _____ Acres 55 Lease No. 17306
 Well (Farm) No. _____ Serial No. 1598
 Elevation (Spirit Level) 867' *YMS NE*
 Quadrangle CENTERPOINT SW
 County DODDRIDGE District GRANT
 Engineer W. M. Brewer
 Engineer's Registration No. 900
 File No. _____ Drawing No. _____
 Date 9-4-40 Scale 1" = 20 POLES

STATE OF WEST VIRGINIA
 DEPARTMENT OF MINES
 OIL AND GAS DIVISION
 CHARLESTON

WELL LOCATION MAP
 FILE NO. DOD-336 A

+ Denotes location of well on United States Topographic Maps, scale 1 to 62,500, latitude and longitude lines being represented by border lines as shown.

- Denotes one inch spaces on border line of original tracing.

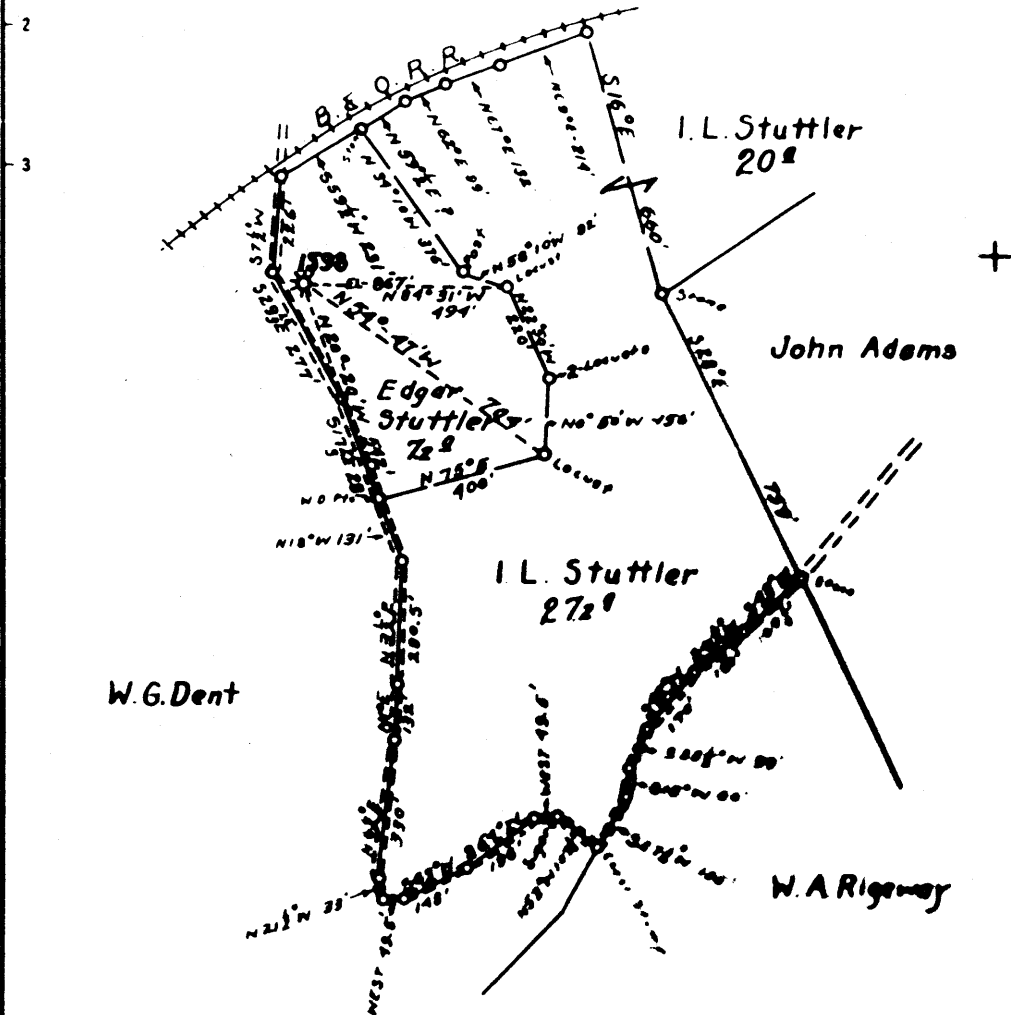

New Location
 Drill Deeper
 Abandonment

FB 970 27 212 M 9 2121 80

Company HOPE NATURAL GAS CO.
 Address CLARKSBURG, WVA
 Farm I.L. STUTLER
 Tract _____ Acres 55 Lease No. 17306
 Well (Farm) No. _____ Serial No. 1598
 Elevation (Spirit Level) 867'
 Quadrangle CENTERPOINT
 _____ BARNDICE _____ CRANIT

STATE OF WEST VIRGINIA
 DEPARTMENT OF MINES
 OIL AND GAS DIVISION
 CHARLESTON

WELL LOCATION MAP
 FILE NO. Dad-396A

◆ Denotes location of well on United States

STATE OF WEST VIRGINIA
DEPARTMENT OF MINES
OIL AND GAS DIVISION

780

WELL RECORD

Permit No. 336-A

Oil or Gas Well Gas
(KIND)

Company Hope Natural Gas Company
Address Clarksburg, W. Va.
Farm I. L. Stutler Acres
Location (waters)
Well No. 1598 Elev. 867
District Grant County Doddridge
The surface of tract is owned in fee by Edgar Stutler
Address Morganaville, W. Va.
Mineral rights are owned by
Address
Drilling commenced 3-21-1910
Drilling completed 4-18-1910
Date shot No record Depth of shot
Open Flow /10ths Water in Inch
/10ths Merc. in Inch
Volume Cu. Ft.
Rock Pressure lbs. hrs.
Oil bbls., 1st 24 hrs.
Fresh water None recorded feet feet
Salt water 1070 feet feet

Casing and Tubing	Used in Drilling	Left in Well	Packers
Size			
16			Kind of Packer
13			
10	228	228	Size of
8 1/4	823	823	
6 5/8	1638	1638	Depth set
5 3/16			
3			Perf. top
2	1779	Pulled	Perf. bottom
Liners Used			Perf. top
			Perf. bottom

CASING CEMENTED..... SIZE..... No. Ft..... Date
Not cemented
COAL WAS ENCOUNTERED AT 290 FEET 72 INCHES
FEET INCHES FEET INCHES
FEET INCHES FEET INCHES

Formation	Color	Hard or Soft	Top	Bottom	Oil, Gas or Water	Depth Found	Remarks
Pittsburgh Coal			290	296			
Big Dunkard Sand			820	850			
Gas Sand			1045	1080	Water	1070	
First Salt Sand			1090	1240			
Little lime			1570	1587			
Pencil Cave			1587	1600			
Blue Monday			1600	1618			
Big Lime			1618	1668			
Big Injun Sand			1668	1783	Gas	1678	
Total Depth				1785			

