

Company South Penn Natural Gas Co.
 Address Parkersburg, W. Va.
 Farm F.Y. Horner
 Tract _____ Acres 240 Lease No. 9730
 Well (Farm) No. 2 & 6 Serial No. _____
 Elevation (Spirit Level) 2=1067.0 6=1138.5
 Quadrangle Centerpoint
 County Doddridge District McClellan
 Engineer E.C. Tabler
 Engineer's Registration No. _____
 File No. _____ Drawing No. _____
 Date Sept. 19, 1941 Scale 1" = 400'

STATE OF WEST VIRGINIA
 DEPARTMENT OF MINES
 OIL AND GAS DIVISION
 CHARLESTON

WELL LOCATION MAP
 FILE NO. DOD-384A & 385A

+ Denotes location of well on United States Topographic Maps, scale 1 to 62,500, latitude and longitude lines being represented by border lines as shown.

- Denotes one inch spaces on border line of original tracing.

STATE OF WEST VIRGINIA
DEPARTMENT OF MINES
OIL AND GAS DIVISION

305

WELL RECORD

AB
Permit No. 384-A


Oil or Gas Well (MINE)

Company **South Penn Natural Gas Company**
 Address **Union Trust Bldg. Parkersburg, W. Va.**
 Farm **F. Y. Hornor** Acres **240**
 Location (waters) -----
 Well No. **2** Elev. **1087.0**
 District **McClellan** County **Doddridge**
 The surface of tract is owned in fee by **Ora E. Coffman**
 Address **Wallace, W. Va.**
 Mineral rights are owned by **Wayne B. Hornor, et al**
922 West Pike Street, Clarksburg, W. Va.
 Drilling commenced **February 15, 1895**
 Drilling completed **April 25, 1895**
 Date shot **see below** Depth of shot -----
 Open Flow /10ths Water in ----- Inch
 /10ths Merc. in ----- Inch
 Volume ----- Cu. Ft.
 Rock Pressure ----- lbs. ----- hrs.
 Oil ----- **25** bbls., 1st 24 hrs.
 Fresh water ----- feet ----- feet
 Salt water ----- feet ----- feet

Casing and Tubing	Used in Drilling	Left in Well	Packers
Size			
16			Kind of Packer
13			
10	487		Size of
8 1/4	1573		
6	1775		Depth set
5 3/16	370		
3			Perf. top
2			Perf. bottom
Liners Used			Perf. top
			Perf. bottom

CASING CEMENTED ----- SIZE ----- No. Ft. ----- Date -----
 COAL WAS ENCOUNTERED AT ----- FEET ----- INCHES
 ----- FEET ----- INCHES ----- FEET ----- INCHES
 ----- FEET ----- INCHES ----- FEET ----- INCHES

Formation	Color	Hard or Soft	Top	Bottom	Oil, Gas or Water	Depth Found	Remarks
Pittsburgh Coal			767	771			
Big Injun			2130				
Total Depth				2241'6"	Oil	2220'6"	
Shot Record:							
		5/26/97	16 qts				
		12/28/01	20 qts				
		12/19/03	24 qts				
		12/11/06	40 qts				

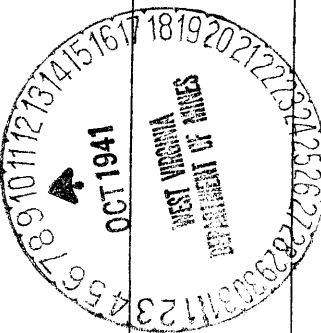

Formation	Color	Hard or Soft	Top	Bottom	Oil, Gas or Water	Depth Found	Remarks

Date October 9, 1941, 194

APPROVED SOUTH PENN NATURAL GAS COMPANY, Owner

By Elton E. Young
Land Agent.