

New Location
 Drill Deeper
 Abandonment

Company PITTSBURGH E. W. VA. GAS CO.
 Address CLARKSBURG, W. VA.
 Farm C. W. DAVIS
 Tract _____ Acres 100 Lease No. 7902
 Well (Farm) No. ONE Serial No. 2029
 Elevation (Spirit Level) 903' V.A.
 Quadrangle CENTERPOINT S.E. 14
 County DODDRIDGE District McCLELLAN
 Engineer Jamend Jaffine
 Engineer's Registration No. 1084
 File No. V-101.P-85 Drawing No. _____
 Date APRIL 16, 1942 Scale 1"=500'

STATE OF WEST VIRGINIA
 DEPARTMENT OF MINES
 OIL AND GAS DIVISION
 CHARLESTON

WELL LOCATION MAP
 FILE NO. DOD-395-A
 (W. 0 7 72264)

+ Denotes location of well on United States Topographic Maps, scale 1 to 62,500, latitude and longitude lines being represented by border lines as shown.

- Denotes one inch spaces on border line of original tracing.

STATE OF WEST VIRGINIA
DEPARTMENT OF MINES
OIL AND GAS DIVISION

318

Ab
395-A

WELL RECORD

Permit No. 395-A

Oil or Gas Well **GAS**
(KIND)


Company **Pittsburgh & West Va Gas Company.**
 Address **Clarksburg, West Va.,**
 Farm **C. W. Davis** Acres **100**
 Location (waters) **Cpt. SA. 1-1**
 Well No. **2079** Elev. **903' VA**
 District **McKellan** County **Hodgkins**
 The surface of tract is owned in fee by **C. W. Davis**
 Address **Salem, West Va.,**
 Mineral rights are owned by **C. W. Davis**
 Address **Salem, West Va.,**
 Drilling commenced **May 30, 1910**
 Drilling completed **July 4, 1910**
 Date Shot From To
 With
 Open Flow /10ths Water in Inch
 /10ths Merc. in Inch
 Volume Cu. Ft.
 Rock Pressure lbs. hrs.
 Oil bbls., 1st 24 hrs.
 Fresh water feet feet
 Salt water feet feet

Casing and Tubing	Used in Drilling	Left in Well	Packers
Size			
16			Kind of Packer
13			
10	60'	None	Size of
8 1/4	101'	None	
6 5/8	103'	103'	Depth set
5 3/16			
3			Perf. top
2			Perf. bottom
Liners Used			Perf. top
			Perf. bottom

CASING CEMENTED. SIZE No. Ft. Date

COAL WAS ENCOUNTERED AT **218** FEET **72** INCHES
497 FEET **108** INCHES FEET INCHES
 FEET INCHES FEET INCHES

Formation	Color	Hard or Soft	Top	Bottom	Oil, Gas or Water	Depth Found	Remarks
Clay	Yellow	Soft	0	13			
Line-stone	White	Close	13	33			
Red Rock	Red	Soft	33	73			
Slate	Dark	"	73	113			
Red Rock	Red	"	113	138			
Line-stone	White	Hard	138	178			
Slate	Dark	Soft	178	218			
Coal	Black	"	218	224			
Limestone	White	Hard	224	348	Water	245'	
Slate	Dark	Soft	348	408			
Line-shells	"	Hard	408	477			
Slate	"	Soft	477	497			
Pgh. Coal	Black	Soft	497	506			
Line-stone	White	Hard	506	521			
Slate	"	Soft	521	526			
Sand	"	"	526	563	Water	554'	
Slate	Dark	"	563	600	Sh. Gas	560'	
Line Stone	White	Hard	600	620			
Slate	Dark	Soft	620	638			
Line shells	White	Hard	638	670			
Red Rock	Red	Soft	670	676			
Line stone	White	Hard	676	681			
Slate	"	Soft	681	688			
Line Stone	"	Hard	688	700			
Red Rock	Red	Soft	700	730			
Slate	White	Soft	730	735			
Red Rock	Red	"	735	826			
Slate	White	"	826	895			
Little Darked	Grey	Hard	895	905			
Line shells	White	Hard	905	977			
Slate	Black	Soft	977	996			
Thin Slate	White	"	996	1001			
Line	"	"	1001	1006			
Slate	"	"	1006	1126			
Slate	Black	"	1126	1141			
Slate	White	"	1141	1153			
Gas Sand	"	Hard	1153	1210			
Slate	Black	Soft	1210	1228			
Sand	White	"	1228	1243			
Slate	"	"	1243	1296			
Slate	Black	"	1296	1308			
1st Salt Sand	White	"	1308	1328			

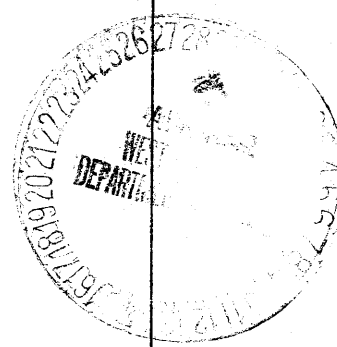

Formation	Color	Hard or Soft	Top	Bottom	Oil, Gas or Water	Depth Found	Remarks
Slate	Black	Soft	1328	1398			
Red Salt Sand	White	Hard	1398	1423			
Slate	Black	Soft	1423	1446			
lime-stone	White	Hard	1446	1451			
Slate	Black	Soft	1451	1500			
Sand	White	Hard	1500	1550			
Slate	Black	Soft	1550	1573			
Sand	White	Hard	1573	1660			
Slate	"	Soft	1660	1670			
Red Rock	Red	"	1670	1695			
lime	White	Hard	1695	1707			
Red Rock	Red	Soft	1707	1734			
Slate	White	"	1734	1780			
Little lime	Dark	Hard	1780	1774			
Fossil Cove	Black	Soft	1774	1789			
Big lime	White	Hard	1789	1853			
Big Injun	"	"	1853	1933	Gas	1895'	
Slate	Black	Soft	1933	1935			
Big Injun	White	Hard	1935	1961	Gas	1952'	
Slate	Dark	Soft	1961	1973			
Sugar Sand	White	Hard	1973	1988			
"	Blue	"	1988	2005			
Slate	Dark	Soft	2005	2027			
Total Depth				2027			

Date March 16, 1942, 194

APPROVED PITTSBURGH & WEST VA GAS COMPANY. Owner

By J. E. [Signature]
(Title)