

Latitude 39° 30'

Longitude 80° 55'

Robinson Improvement Co.

J. B. Dewhurst

Ezra Tucker
58^{ac}

W. B. Hawkins Mrs.

186^{ac} Now
U.G. Prunty

U.G. Prunty

68^{ac}
160



Ora Coffman
&
Ross Allen

Reynolds Williams Mrs.

109^{ac}

Goal: State of West Virginia

Surface: U.G. Prunty
Folsom, W. Va.
R.D. #1.

4.00S
0.71W

New Location
Drill Deeper
Abandonment

SI E1-2 Map N48

Company	South Penn Natural Gas Co.
Address	Parkersburg, W. Va.
Farm	W. B. Hawkins
Tract	Acres 213 Lease No. 13672
Well (Farm) No.	6 Serial No.
Elevation (Spirit Level)	1279.76
Quadrangle	Centerpoint
County	Doddridge District McClellan.
Engineer	Emmon Haines
Engineer's Registration No.	
File No.	Drawing No.
Date	Feb. 13, 1942 Scale 1" = 800'

STATE OF WEST VIRGINIA
DEPARTMENT OF MINES
OIL AND GAS DIVISION
CHARLESTON

WELL LOCATION MAP
FILE NO. DOD-432-A

+ Denotes location of well on United States
Topographic Maps, scale 1 to 62,500, lat-
itude and longitude lines being represented
by border lines as shown.

- Denotes one inch spaces on border line
of original tracing.

STATE OF WEST VIRGINIA
DEPARTMENT OF MINES
OIL AND GAS DIVISION

345

WELL RECORD

Permit No. **X32-A**

Oil or Gas Well **OIL**
(KIND)

Company **South Penn Natural Gas Company**
 Address **Union Trust Bldg., Parkersburg, W. Va.**
 Farm **W. B. Hawkins** Acres **213**
 Location (waters) **- - - - -**
 Well No. **6** Elev. **1279.76**
 District **McClellan** County **Doddridge**
 The surface of tract is owned in fee by **U. G. Prunty,**
R. D. No. 1, Address **Folsom, W. Va.**
 Mineral rights are owned by **Zona V. Warner et al**
 Address **Buckhannon, W. Va.**
 Drilling commenced **May 31, 1895**
 Drilling completed **Sept. 24, 1895**
 Date Shot **See below** From **-** To **-**
 With **- - - - -**
 Open Flow /10ths Water in **--** Inch
 /10ths Merc. in **--** Inch
 Volume **--** Cu. Ft.
 Rock Pressure **--** lbs. **--** hrs.
 Oil **30** bbls., 1st 24 hrs.
 Fresh water **--** feet **--** feet
 Salt water **--** feet **--** feet


Casing and Tubing	Used in Drilling	Left in Well	Packers
Size			
16			Kind of Packer -
13			-
10	530' (Pulled)		Size of -
8 1/4	1280' (Pulled)		-
6	2366'		Depth set -
5 3/16			-
3			Perf. top -
2			Perf. bottom -
Liners Used			Perf. top -
			Perf. bottom -

CASING CEMENTED **-** SIZE **-** No. Ft. **-** Date **-**
 COAL WAS ENCOUNTERED AT **992** FEET **72** INCHES
- FEET **-** INCHES **-** FEET **-** INCHES
- FEET **-** INCHES **-** FEET **-** INCHES

Formation	Color	Hard or Soft	Top	Bottom	Oil, Gas or Water	Depth Found	Remarks
Pittsburgh Coal			992	998			
Dunkard Sand			1380	1420			
Salt Sand			1800	1990			
Pencil Cave			2232	2235			
Big Lime			2235	2346			
Big Injun			2346				
					Oil	2422	
Total Depth				2437			

SHOT RECORD:

1-16-1897 - 15 Qt.
 3-31-1900 - 20 Qt.
 12-4-1905 - 30 Qt.
 11-11-1910 - 70 Qt.
 11-30-1920 - 60 Qt.

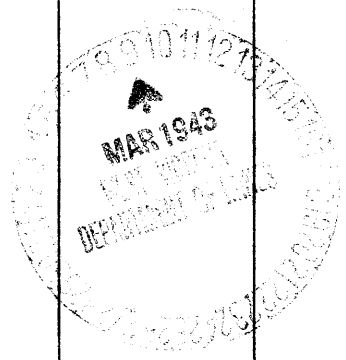

MAR 13 1943

Formation	Color	Hard or Soft	Top	Bottom	Oil, Gas or Water	Depth Found	Remarks

Date **March 8, 1943**, 194

APPROVED **SOUTH PENN NATURAL GAS COMPANY**, Owner

By *Elton Spang* Land Agent.
(Title)