

New Location
 Drill Deeper
 Abandonment

MAP SHEET 45-SQUARE S1 E2 - F.B. 748 P. 29-30

Company HOPE NATURAL GAS CO.
 Address CLARKSBURG, W.Va.
 Farm J. B. DEWHURST
 Tract _____ Acres 100 Lease No. 4928
 Well (Farm) No. _____ Serial No. 837
 Elevation (Spirit Level) 1178
 Quadrangle CENTERPOINT
 County DOODRIDGE District MCCLELLAND
 Engineer Wm. Brown
 Engineer's Registration No. 900
 File No. _____ Drawing No. _____
 Date JULY 19, 1943 Scale 1" = 40 Ft.

STATE OF WEST VIRGINIA
 DEPARTMENT OF MINES
 OIL AND GAS DIVISION
 CHARLESTON

WELL LOCATION MAP
 FILE NO. DOD-444-A

+ Denotes location of well on United States Topographic Maps, scale 1 to 62,500, latitude and longitude lines being represented by border lines as shown.

- Denotes one inch spaces on border line of original tracing.

71080 on CNG maps



STATE OF WEST VIRGINIA
DEPARTMENT OF MINES
OIL AND GAS DIVISION

352

WELL RECORD

Permit No. 444-X


Oil or Gas Well
(KIND)

Company Hope Natural Gas Company.
Address 445 West Main St. Clarksburg, W. Va.
Farm J. E. Dewhurst Acres 4436
Location (waters) _____
Well No. 837 Elev. 1207
District McClellan County Doddridge
The surface of tract is owned in fee by _____
Address _____
Mineral rights are owned by _____
Address _____
Drilling commenced ? ?
Drilling completed Dec. 3, 1895
Date Shot _____ From _____ To _____
With _____
Open Flow _____ /10ths Water in _____ Inch
_____ /10ths Merc. in _____ Inch
Volume _____ Cu. Ft.
Rock Pressure _____ lbs. _____ hrs.
Oil _____ bbls., 1st 24 hrs.
Fresh water none recorded feet _____ feet
Salt water none recorded feet _____ feet

Casing and Tubing	Used in Drilling	Left in Well	Packers
Size			
16			Kind of Packer
13			
10	437	437	Size of
8 1/2	1271	1271	
6	2240	2240	Depth set
5 3/16	2348	2348	
3			Perf. top
2			Perf. bottom
Liners Used			Perf. top
			Perf. bottom

Not cemented
CASING CEMENTED _____ SIZE _____ No. Ft. _____
COAL WAS ENCOUNTERED AT 875 FEET 72 INCHES
_____ FEET _____ INCHES _____ FEET _____ INCHES
_____ FEET _____ INCHES _____ FEET _____ INCHES

Formation	Color	Hard or Soft	Top	Bottom	Oil, Gas or Water	Depth Found	Remarks
Pittsburgh Coal			875	881			
Salt sand			1760	1900			
Pencil cave			2130	2135			
Big Lime			2135	2238			
Big Injun sand			2238	2371	gas	2258- 2323 2349-2350	
Thirty Foot			2925	2942			
Gordon Stray			2990	2998	gas	2990- 2993	
Total depth				3244			

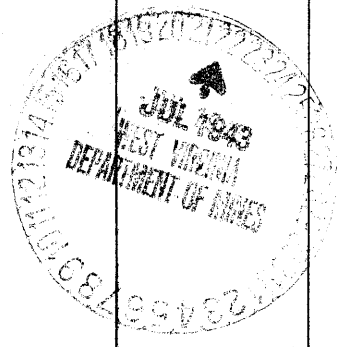

Formation	Color	Hard or Soft	Top	Bottom	Oil, Gas or Water	Depth Found	Remarks

Date July 9, 1943., 194

APPROVED Hope Natural Gas Company, Owner

By [Signature] Gen. Sup't.
(Title)