

New Location   
 Drill Deeper   
 Abandonment

Company P. & M. Oil Co.  
 Address West Union W. Va.  
 Farm Sarah M. Evans  
 Tract one Acres 22 Lease No. \_\_\_\_\_  
 Well (Farm) No. 1 Serial No. \_\_\_\_\_  
 Elevation (Spirit Level) 831  
 Quadrangle Vadis  
 County Doddridge District New Milton  
 Engineer J. M. Martin  
 Engineer's Registration No. 84  
 File No. \_\_\_\_\_ Drawing No. \_\_\_\_\_  
 Date Jan 25 1944 Scale 20 P = 1"

STATE OF WEST VIRGINIA  
 DEPARTMENT OF MINES  
 OIL AND GAS DIVISION  
 CHARLESTON

WELL LOCATION MAP  
 FILE NO. DOD-457-H

+ Denotes location of well on United States Topographic Maps, scale 1 to 62,500, latitude and longitude lines being represented by border lines as shown.  
 - Denotes one inch spaces on border line of original tracing.



COPY

358

STATE OF WEST VIRGINIA  
DEPARTMENT OF MINES  
OIL AND GAS DIVISION

WELL RECORD

Permit No. Ab 457-A

Oil or Gas Well Oil

(KIND)

Company P. & M. Oil Company  
 Address West Union, W. Va.  
 Farm Sarah M. Evans Acres 22  
 Location (waters) \_\_\_\_\_  
 Well No. 1 Elev. 831  
 District New Milton County Doddridge  
 The surface of tract is owned in fee by Earl Percy  
 Address New Milton, W. Va.  
 Mineral rights are owned by Sarah M. Evans  
 Address \_\_\_\_\_  
 Drilling commenced January 24, 1921  
 Drilling completed \_\_\_\_\_  
 Date Shot \_\_\_\_\_ From \_\_\_\_\_ To \_\_\_\_\_  
 With \_\_\_\_\_  
 Open Flow \_\_\_\_\_ /10ths Water in \_\_\_\_\_ Inch  
 \_\_\_\_\_ /10ths Merc. in \_\_\_\_\_ Inch  
 Volume \_\_\_\_\_ Cu. Ft.  
 Rock Pressure \_\_\_\_\_ lbs. \_\_\_\_\_ hrs.  
 Oil \_\_\_\_\_ bbls., 1st 24 hrs.  
 Fresh water \_\_\_\_\_ feet \_\_\_\_\_ feet  
 Salt water \_\_\_\_\_ feet \_\_\_\_\_ feet


Casing and Tubing	Used in Drilling	Left in Well	Packers
Size			
16			Kind of Packer
13	34	34	
10	275	275	Size of
8 1/4	1004	None	
6 1/2	None	????	Depth set
5 3/16	1795	1795	
3			Perf. top
2			Perf. bottom
Liners Used			Perf. top
			Perf. bottom

CASING CEMENTED \_\_\_\_\_ SIZE \_\_\_\_\_ No. Ft. \_\_\_\_\_ Date \_\_\_\_\_

COAL WAS ENCOUNTERED AT \_\_\_\_\_ FEET \_\_\_\_\_ INCHES  
 \_\_\_\_\_ FEET \_\_\_\_\_ INCHES \_\_\_\_\_ FEET \_\_\_\_\_ INCHES  
 \_\_\_\_\_ FEET \_\_\_\_\_ INCHES \_\_\_\_\_ FEET \_\_\_\_\_ INCHES

Formation	Color	Hard or Soft	Top	Bottom	Oil, Gas or Water	Depth Found	Remarks
Pittsburgh coal			475	485			
Little dunkard		Shells					
Big dunkard			1003	1073			
Gas sand			1134	1225			
1st salt sand			1380	1440			
2nd salt sand			1460	1500			
3rd salt sand			1520	1560			
Maxon sand							
Little lime			1760	1780			
Pencil cave			1780	1791			
Blue Monday			1791	1850			
Big lime			1850	1875			
Big injun			1875	1944			
Gas and oil show				1902			
Total depth				1944			

(C)

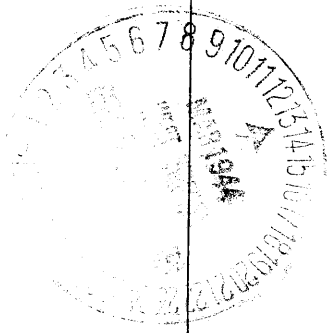

(Over)

MAR 30 1944

Formation	Color	Hard or Soft	Top	Bottom	Oil, Gas or Water	Depth Found	Remarks

Date January 24, \_\_\_\_\_, 194 4

APPROVED P. & M. OIL COMPANY \_\_\_\_\_, Owner

By L. G. Pigott, Agent \_\_\_\_\_  
(Title)