

7.5' Jic  
 0.920 391730  
 0.12 W 804930  
 Calc 15' loc via 9/15/98  
 3,805  
 2,350

New Location   
 Drill Deeper   
 Abandonment

Map Sheet 60 Squares S12W10 E8759 R18-19

Company HOPE NATURAL GAS CO.  
 Address CLARKSBURG, W. VA.  
 Farm LEWIS MAXWELL  
 Tract \_\_\_\_\_ Acres 78 Lease No. 23924  
 Well (Farm) No. \_\_\_\_\_ Serial No. 6749  
 Elevation (Spirit Level) 1013  
 Quadrangle WEST UNION  
 County DODDRIDGE District WEST UNION  
 Engineer W.M. Bowers  
 Engineer's Registration No. 900  
 File No. \_\_\_\_\_ Drawing No. \_\_\_\_\_  
 Date APRIL 29, 1944 Scale 1" = 40P

STATE OF WEST VIRGINIA  
 DEPARTMENT OF MINES  
 OIL AND GAS DIVISION  
 CHARLESTON

**WELL LOCATION MAP**  
 FILE NO. MOA-461-A

+ Denotes location of well on United States Topographic Maps, scale 1 to 62,500, latitude and longitude lines being represented by border lines as shown.

- Denotes one inch spaces on border line of original tracing.

STATE OF WEST VIRGINIA  
DEPARTMENT OF MINES  
OIL AND GAS DIVISION

367

WELL RECORD

Permit No. **461-A**


Oil or Gas Well **Gas**  
(KIND)

Company **Hope Natural Gas Company.**  
Address **445 West Main St. Clarksburg, W. Va.**  
Farm **Lewis Maxwell** Acres **7.8**  
Location (waters) \_\_\_\_\_  
Well No. **6749** Elev. **1013**  
District **West Union** County **Doddridge**  
The surface of tract is owned in fee by **Lewis Maxwell Heirs**  
Address **(?)**  
Mineral rights are owned by **Lewis Maxwell Heirs**  
Address **(?)**  
Drilling commenced **8-25-25**  
Drilling completed **9-30-25**  
Date Shot \_\_\_\_\_ From \_\_\_\_\_ To \_\_\_\_\_  
With \_\_\_\_\_  
Open Flow \_\_\_\_\_ /10ths Water in \_\_\_\_\_ Inch  
\_\_\_\_\_ /10ths Merc. in \_\_\_\_\_ Inch  
Volume \_\_\_\_\_ Cu. Ft.  
Rock Pressure \_\_\_\_\_ lbs. \_\_\_\_\_ hrs.  
Oil \_\_\_\_\_ bbls., 1st 24 hrs.  
Fresh water **80** feet \_\_\_\_\_ feet  
Salt water \_\_\_\_\_ feet \_\_\_\_\_ feet

Casing and Tubing	Used in Drilling	Left in Well	Packers
Size			
16			Kind of Packer
13			
10	<b>469</b>	<b>469</b>	Size of
8 1/4	<b>1049</b>	<b>1049</b>	
6 1/2	<b>1900</b>	<b>1900</b>	Depth set
5 3/16			
3			Perf. top
2			Perf. bottom
Liners Used			Perf. top
			Perf. bottom

**Not cemented**  
CASING CEMENTED \_\_\_\_\_ SIZE \_\_\_\_\_ No. Ft. \_\_\_\_\_ Date \_\_\_\_\_  
COAL WAS ENCOUNTERED AT **290** FEET **60** INCHES  
**560** FEET **48** INCHES FEET INCHES  
FEET INCHES FEET INCHES

Formation	Color	Hard or Soft	Top	Bottom	Oil, Gas or Water	Depth Found	Remarks
Native Coal			290	295	water	80	
Pittsburgh Coal			560	564			
Little Dunkard			970	990			
Big Dunkard			1045	1070			
Gas Sand			1110	1140			
First Salt			1186	1290			
Second Salt			1305	1330			
Maxon sand			1715	1730			
Little Lime			1840	1855			
Pencil cave			1866	1876			
Big Lime			1876	1957	gas	1965- 1968	
Big Injun			1957	2029			
Total depth				2029			

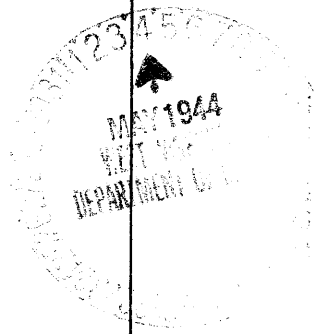

Formation	Color	Hard or Soft	Top	Bottom	Oil, Gas or Water	Depth Found	Remarks

Date April 27, 1944, 194

APPROVED Hops Natural Gas Company., Owner

By [Signature] Gen. Sup't.

(Title)