


E.M. Smith

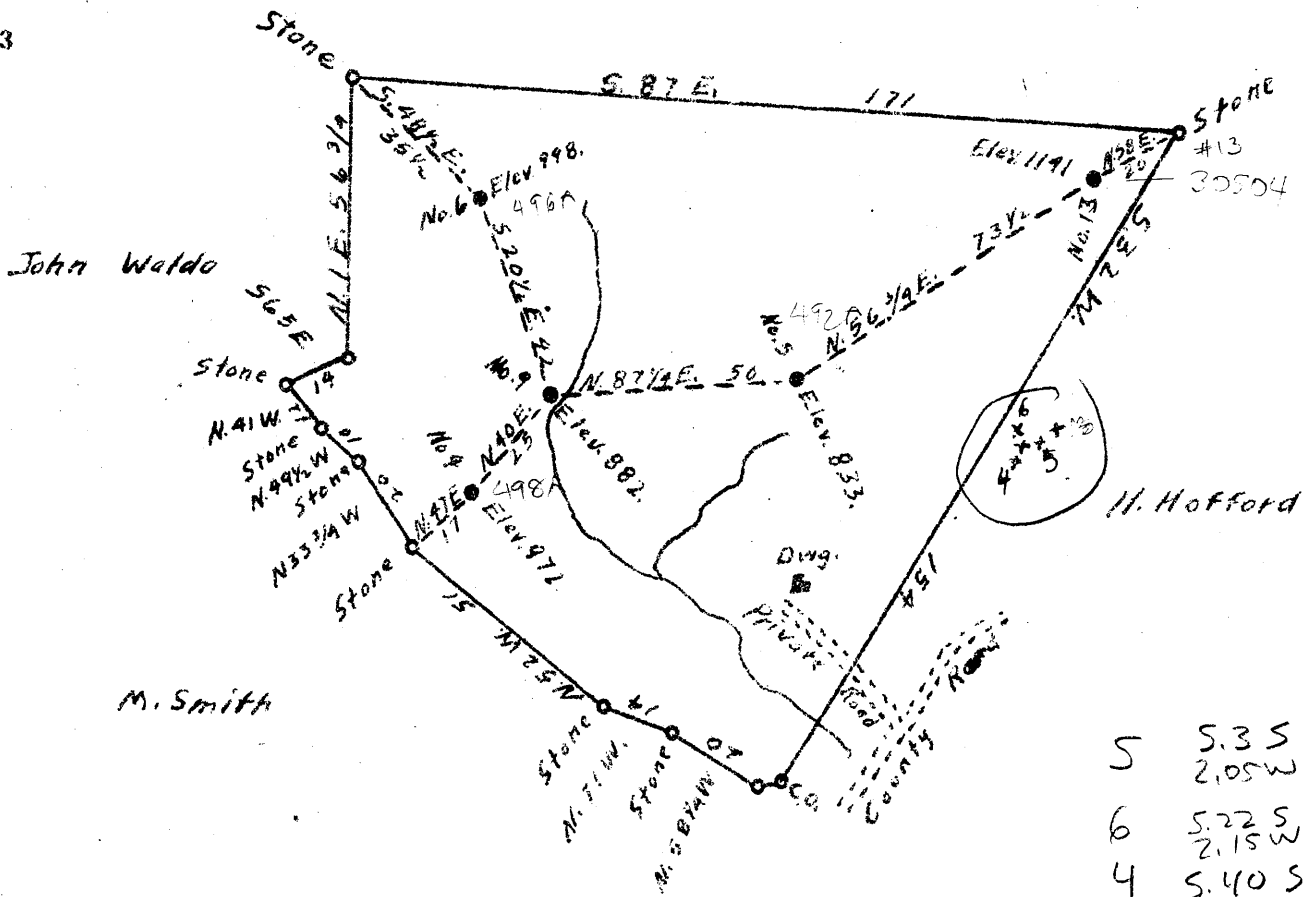

5	S. 3 S
	2.05 W
6	S. 22 S
	2.15 W
4	S. 40 S
	2.18 W

Chas. Williams

- New Location
- Drill Deeper
- Abandonment

Company Beno Oil Co.
 Address Sistersville, W. Va.
 Farm W. F. Hudkins
 Tract _____ Acres 97A 134A Lease No. _____
 Well (Farm) No. 4-5-6-8-13 Serial No. _____
 Elevation (Spirit Level) 972-833-998-882-1191
 Quadrangle West Union
 County Doddridge District Central
 Engineer A. K. Westfall
 Engineer's Registration No. 66 Surveyor, Putches County
 File No. _____ Drawing No. _____
 Date June 12, 1922 Scale 1" = 40' Poles

STATE OF WEST VIRGINIA
 DEPARTMENT OF MINES
 OIL AND GAS DIVISION
 CHARLESTON

WELL LOCATION MAP

FILE NO. DOD-492-A-#5
DOD-496-A-#6
DOD-498-A-#4

- + Denotes location of well on United States Topographic Maps, scale 1 to 62,500. latitude and longitude lines being represented by border lines as shown.
- Denotes one inch spaces on border line of original tracing.



STATE OF WEST VIRGINIA
DEPARTMENT OF MINES
OIL AND GAS DIVISION

290

WELL RECORD

Permit No. DOD-496-plugging

Oil or Gas Well X (KIND)

Company TRI-STATE PIPE COMPANY
 Address BELLAIRE
 Farm W. F. HUDKINS Acres _____
 Location (waters) _____
 Well No. 6 Elev. 998
 District CENTRAL County DODDRIDGE
 The surface of tract is owned in fee by _____
 Address _____
 Mineral rights are owned by _____
 Address _____
 Drilling commenced _____
 Drilling completed _____
 Date Shot TOP OF SHOT 2110' From _____ To _____
 With _____
 Open Flow _____ /10ths Water in _____ Inch
 _____ /10ths Merc. in _____ Inch
 Volume _____ Cu. Ft.
 Rock Pressure _____ lbs. _____ hrs.
 Oil _____ bbls., 1st 24 hrs.
 Fresh water _____ feet _____ feet
 Salt water _____ feet _____ feet

Casing and Tubing	Used in Drilling	Left in Well	Packers
Size			
16			Kind of Packer
13			
10		Pulled	Size of
8 1/4		"	
6 5/8		2004'	Depth set
5 3/16			
3			Perf. top
2		2185'	Perf. bottom
Liners Used			Perf. top
			Perf. bottom

CASING CEMENTED _____ SIZE _____ No. Ft. _____ Date _____
 COAL WAS ENCOUNTERED AT _____ FEET _____ INCHES
 _____ FEET _____ INCHES FEET _____ INCHES
 _____ FEET _____ INCHES FEET _____ INCHES

Formation	Color	Hard or Soft	Top	Bottom	Oil, Gas or Water	Depth Found	Remarks
Sand			305	350			
Sand			1060	1085			
Little Dunkard			1115	1135			
Big Dunkard			1240	1318			
First Salt Sand			1575	1640			
2d Salt Sand			1730	1815			
3d Salt Sand			1850	1920			
Maxon Sand			1941	1963			
Little Lime			1966	1984			
Pencil Cave			1984	1988			
Big Lime			1988	2089			
Injun Sand			2089	2146			
Total Depth				2185			

