

Map Sheet 60, Squares S11W8FB775P40

Company Hope Natural Gas Co.
 Address Clarksburg, W Va
 Farm C.C. Mobley - H.M. Grant
 Tract 11 Acres 16 Lease No. 4868
 Well (Farm) No. 997 Serial No. 997
 Elevation (Spirit Level) 795
 Quadrangle Centerpoint
 County Doddridge District West Union
 Engineer W.M. Bowers
 Engineer's Registration No. 900
 File No. _____ Drawing No. _____
 Date Jan 24, 1946 Scale 1" = 20P

STATE OF WEST VIRGINIA
 DEPARTMENT OF MINES
 OIL AND GAS DIVISION
 CHARLESTON

WELL LOCATION MAP
 FILE NO. DOD-506-A

+ Denotes location of well on United States Topographic Maps, scale 1 to 62,500, latitude and longitude lines being represented by border lines as shown.

- Denotes one inch spaces on border line of original tracing.

72525 on CNG map



STATE OF WEST VIRGINIA
DEPARTMENT OF MINES
OIL AND GAS DIVISION

408

Permit No. DD-506-A

WELL RECORD


~~Oil~~ or Gas Well

Company Hope Natural Gas Company.
Address 445 West Main St. Clarksburg, W. Va.
Farm C. C. Mobley-H. M. Grant Acres 27
Location (waters) _____
Well No. 997 Elev. 795
District West Union County Doddridge
The surface of tract is owned in fee by _____
Address _____
Mineral rights are owned by _____
Address _____
Drilling commenced October 21, 1907
Drilling completed December 11, 1907
Date Shot _____ From _____ To _____
With _____
Open Flow _____ /10ths Water in _____ Inch
_____ /10ths Merc. in _____ Inch
Volume _____ Cu. Ft.
Rock Pressure _____ lbs. _____ hrs.
Oil _____ bbls., 1st 24 hrs.
Fresh water none recorded feet _____ feet
Salt water none recorded feet _____ feet

Casing and Tubing	Used in Drilling	Left in Well	Packers
Size			
16			Kind of Packer
13			
10	210	210	Size of
8 1/4	772	772	
6 5/8	1805	Pulled	Depth set
5 3/16	1889	1889	
3			Perf. top
2			Perf. bottom
Liners Used			Perf. top
			Perf. bottom

not cemented
CASING CEMENTED _____ SIZE _____ No. Ft. _____ Date _____
COAL WAS ENCOUNTERED AT 205 FEET 60" Est. INCHES
_____ FEET _____ INCHES FEET _____ INCHES
_____ FEET _____ INCHES FEET _____ INCHES

Formation	Color	Hard or Soft	Top	Bottom	Oil, Gas or Water	Depth Found	Remarks
Pittsburgh	Coal		205	?			
Little Dunkard			605	615			
Big Dunkard			750	760			
Gas sand			900	950			
First Salt			1000	1200			
Second Salt			1252	1287			
Third Salt			1333	1335			
Blue Munday			1540	1550			
Pencil cave			1550	1556			
Big Lime			1556	1617			
Big Injun			1617	1737	gas	1731	
Sand			1960	1985			
Fifty foot			2100	2125			
Stray			2296	2319			
Gordon			2330	2345	gas	2335	
Total depth				2420			
Originally drilled to				2907			

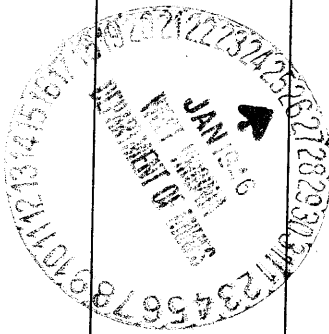

Formation	Color	Hard or Soft	Top	Bottom	Oil, Gas or Water	Depth Found	Remarks

Date January 23, 1946, 194

APPROVED Hope Natural Gas Company., Owner

By General Superintendent.

