


Latitude 39 15

Longitude 80

0.925
0.58W

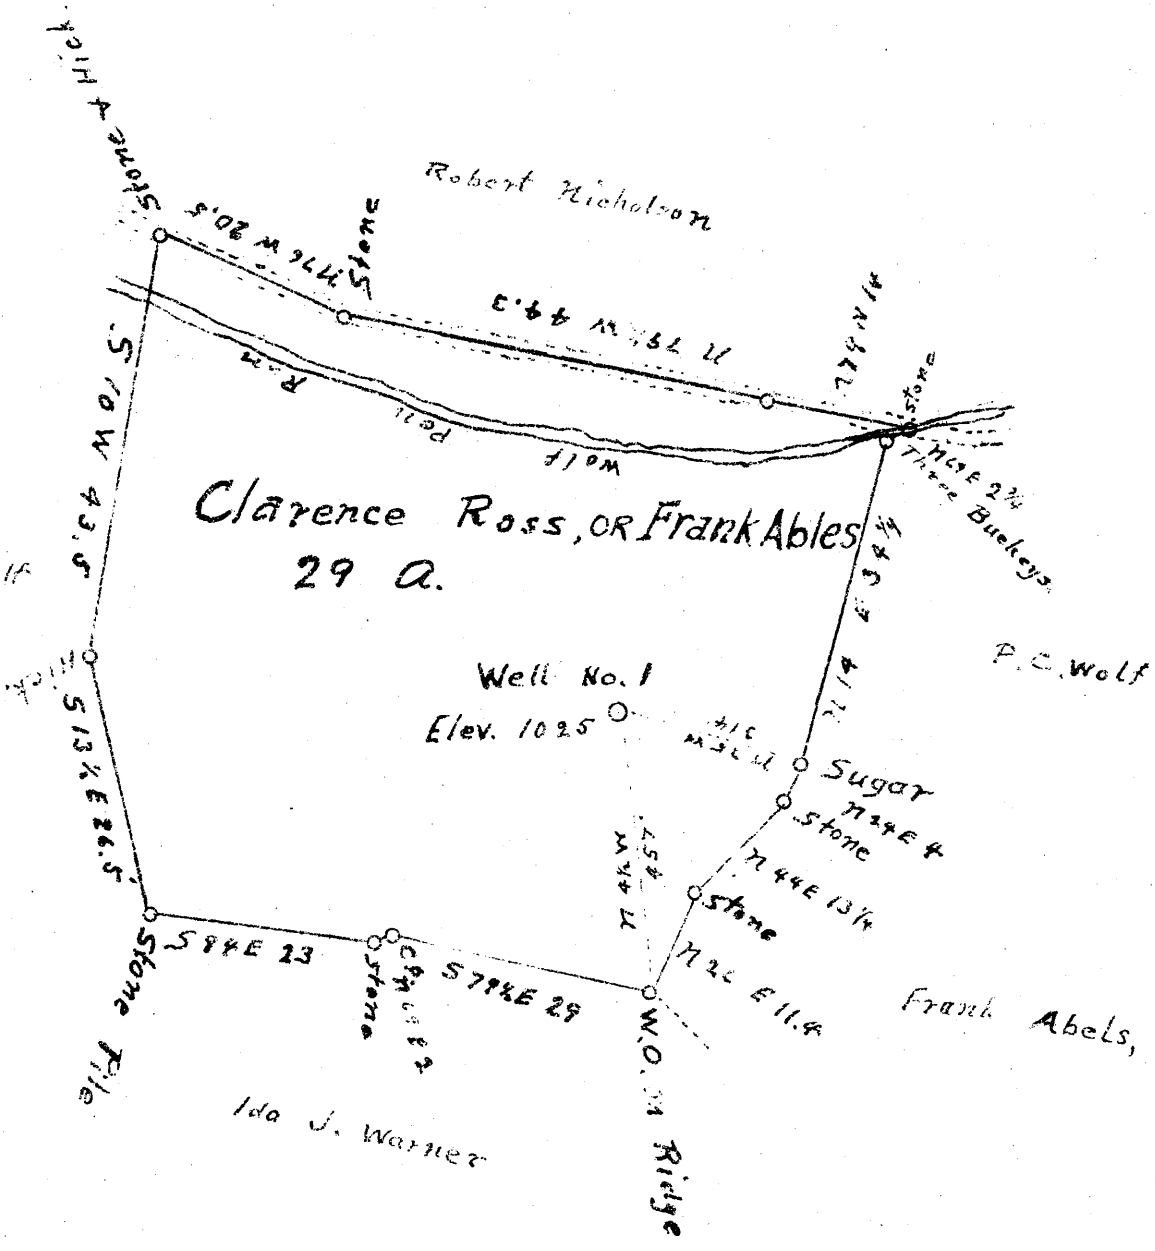

New Location
 Drill Deeper
 Abandonment

Company P & M. Oil Co.
 Address West Union
 Farm Clarence Ross,
 Tract ONE Acres 29 Lease No. _____
 Well (Farm) No. 1 Serial No. _____
 Elevation (Spirit Level) 1025
 Quadrangle Yadis
 County Haddridge District New Milton
 Engineer J. M. Martin,
 Engineer's Registration No. 84
 File No. _____ Drawing No. _____
 Date April 16, 1946 Scale 20P = 1"

STATE OF WEST VIRGINIA
 DEPARTMENT OF MINES
 OIL AND GAS DIVISION
 CHARLESTON

WELL LOCATION MAP
 FILE NO. DOD-516-A

+ Denotes location of well on United States Topographic Maps, scale 1 to 62,500, latitude and longitude lines being represented by border lines as shown.

- Denotes one inch spaces on border line of original tract.



422

STATE OF WEST VIRGINIA
DEPARTMENT OF MINES
OIL AND GAS DIVISION

Permit No. 060-516-A

WELL RECORD

Oil or Gas Well Oil
(KIND)

Company P. & M. Oil Company
 Address West Union, W. Va.
 Farm Frank Ables Acres 29
 Location (waters) Wolf Penn Run
 Well No. 1 Elev. 1025'
 District New Milton County Doddridge
 The surface of tract is owned in fee by _____
 Address _____
 Mineral rights are owned by _____
 Address _____
 Drilling commenced Sept. 21, 1920
 Drilling completed Nov. 10, 1920
 Date Shot _____ From _____ To _____
 With _____
 Open Flow _____ /10ths Water in _____ Inch
 _____ /10ths Merc. in _____ Inch
 Volume _____ Cu. Ft.
 Rock Pressure _____ lbs. _____ hrs.
 Oil _____ bbls., 1st 24 hrs.
 Fresh water _____ feet _____ feet
 Salt water _____ feet _____ feet

Casing and Tubing	Used in Drilling	Left in Well	Packers
Size			
16			Kind of Packer
13			
10	445	--	Size of
8 1/4	1200	--	
6 5/8	2052	2052'	Depth set
5 3/16			
3			Perf. top
2			Perf. bottom
Liners Used			Perf. top
			Perf. bottom

CASING CEMENTED _____ SIZE _____ No. Ft. _____ Dat _____
 COAL WAS ENCOUNTERED AT _____ FEET _____ INCHES
 _____ FEET _____ INCHES FEET _____ INCHES
 _____ FEET _____ INCHES FEET _____ INCHES

Formation	Color	Hard or Soft	Top	Bottom	Oil, Gas or Water	Depth Found	Remarks
Well drilled by J. E. Trainer and Geo. Travis, Original owners.							
Pittsburgh Coal			695	696			
L. Dunkard			1100	1140			
B. Dunkard			1195	1260			
Gas Sand			1300	1315			
1st. Salt			1440	1480			
2d. Salt			1500	1670			
3d. Salt			1720	1775			
Maxon			1910	1945			
Little Lime			2000	2030			
Pencil Cave			2030	2040			
Big Lime			2040	2090			
Big Injun			2090	2172			
Oil			2090	2094			
Total Depth				2172'			