

* 1,355
1,97W

Loyd Williams


Loyd Ingram

H.L. McGee
74 A.

J.H. McGee

Ike Miller

Ralph Smith

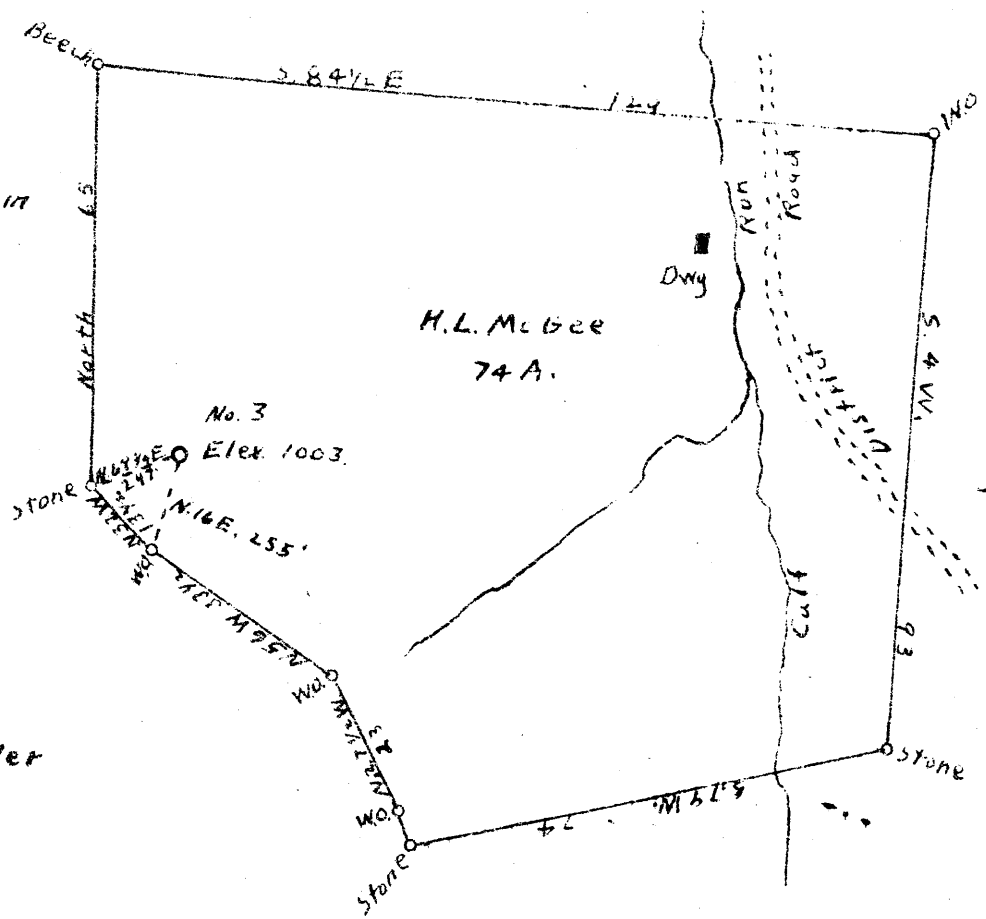

New Location
Drill Deeper
Abandonment

Company Tri-State Pipe Co
 Address Bellaire, Ohio
 Farm H.L. McGee
 Tract _____ Acres 74 Lease No. _____
 Well (Farm) No. 3 Serial No. _____
 Elevation - Spirit Level 1003
 Quadrangle Holbrook
 County Doddridge District Central
 Engineer A.K. Westfall
 Engineer's Registration No. _____
 File No. _____ Drawing No. _____
 Date August 10, 1945 Scale 1" = 30 Poles

STATE OF WEST VIRGINIA
DEPARTMENT OF MINES
OIL AND GAS DIVISION
CHARLESTON

WELL LOCATION MAP
FILE NO. DOD-521-A

+ Denotes location of well on United States Topographic Maps, scale 1 to 62,500, latitude and longitude lines being represented by border lines as shown.
- Denotes one inch spaces on border line of original tracing



COPY

426

STATE OF WEST VIRGINIA
DEPARTMENT OF MINES
OIL AND GAS DIVISION

WELL RECORD

Permit No. 521-A

Oil or Gas Well Oil
(KIND)

Company..... The Tri-State Pipe Company
 Address..... Bellaire, Ohio
 Farm..... H. L. McGee Acres..... 74
 Location (waters).....
 Well No..... 1 Elev..... 1003
 District..... Central County..... Doddridge
 The surface of tract is owned in fee by.....
 Address.....
 Mineral rights are owned by.....
 Address.....
 Drilling commenced.....
 Drilling completed.....
 Date Shot..... From..... To.....
 With.....
 Open Flow /10ths Water in..... Inch
 /10ths Merc. in..... Inch
 Volume..... Cu. Ft.
 Rock Pressure..... lbs..... hrs.
 Oil..... bbls., 1st 24 hrs.
 Fresh water..... feet..... feet
 Salt water..... feet..... feet

Casing and Tubing	Used in Drilling	Left in Well	Packers
Size			Kind of Packer
16			
13			
10		pulled	Size of
8 3/4		pulled	
6 3/4		1634'	Depth set
5 3/16			
3			Perf. top
2			Perf. bottom
Liners Used			Perf. top
			Perf. bottom

CASING CEMENTED..... SIZE..... No. Ft..... Date

COAL WAS ENCOUNTERED AT..... FEET..... INCHES
 FEET..... INCHES..... FEET..... INCHES
 FEET..... INCHES..... FEET..... INCHES

Formation	Color	Hard or Soft	Top	Bottom	Oil, Gas or Water	Depth Found	Remarks
Hurry up Sand			400	425			
Big Dunkard			1260	1280			
Gas Sand			1440	1460			
1st Salt Sand			1460c 1525	1635			
2d Salt Sand			1642	1835			
Slate			1836	1850			
Maxon Sand			1950	1979			
Oil			1963	1968			
Total Depth			1993'				