

ABANDONMENT X

MAP SH. 59 SQ S11 W 4 F.B. 570 P-7

COMPANY HOPE NATURAL GAS CO.
 ADDRESS CLARKSBURG, W. VA.
 FARM JAMES A. FOX
 TRACT ACRES 70 LEASE NO. 10090
 WELL (FARM) NO. SERIAL NO. 1418
 ELEVATION (SPIRIT LEVEL) 1128'
 QUADRANGLE CENTERPOINT
 COUNTY DODDRIDGE DISTRICT GRANT
 ENGINEER W. M. BOWERS
 ENGINEER'S REG. NO. 900
 FILE NO. DRAWING NO.
 DATE 7/19/46 SCALE 1" - 400'

STATE OF WEST VIRGINIA
 DEPARTMENT OF MINES
 OIL AND GAS DIVISION
 CHARLESTON

WELL LOCATION MAP
 FILE NO. DOD - 525-A

+ DENOTES LOCATION OF WELL ON U. S. TOPOGRAPHIC MAPS, SCALE 1 TO 62,500 LATITUDE AND LONGITUDE LINES BEING REPRESENTED BY BORDER LINES AS SHOWN
 - DENOTES ONE INCH SPACES ON BORDER LINE OF ORIGINAL TRACING.

72649 on CNG map



STATE OF WEST VIRGINIA
DEPARTMENT OF MINES
OIL AND GAS DIVISION

434

WELL RECORD

Permit No. 555-A


Oil or Gas Well _____ (KIND)

Company Hope Natural Gas Company.
Address 445 West Main St. Clarksburg, W. Va.
Farm James A. Fox Acres 70
Location (waters) _____
Well No. 1418 Elev. 1128
District Grant County Doddridge
The surface of tract is owned in fee by _____
Address _____
Mineral rights are owned by _____
Address _____
Drilling commenced October 16, 1909
Drilling completed November 10, 1909
Date Shot _____ From _____ To _____
With _____
Open Flow _____ /10ths Water in _____ Inch
_____ /10ths Merc. in _____ Inch
Volume _____ Cu. Ft.
Rock Pressure _____ lbs. _____ hrs.
Oil _____ bbls., 1st 24 hrs.
Fresh water 1457 feet _____ feet
Salt water _____ feet _____ feet

Casing and Tubing	Used in Drilling	Left in Well	Packers
Size			
16			Kind of Packer
13			
10	148	148	Size of
8 1/4	1219	1219	
6 5/8	1905	1905	Depth set
5 3/16			
3			Perf. top
2	2044	2044	Perf. bottom
Liners Used			Perf. top
			Perf. bottom

CASING CEMENTED _____ SIZE _____ No. Ft. _____ Date _____
COAL WAS ENCOUNTERED AT 530 FEET 48 INCHES
_____ FEET _____ INCHES _____ FEET _____ INCHES
_____ FEET _____ INCHES _____ FEET _____ INCHES

Formation	Color	Hard or Soft	Top	Bottom	Oil, Gas or Water	Depth Found	Remarks
Pittsburgh Coal			530	534			
Little Dunkard			950	996			
Big Dunkard			1046	1086			
Gas sand			1204	1248			
First Salt			1286	1308			
Second Salt			1360	1464	water	1459	
Maxon			1566	1606	show gas	1576	
Little Lime			1816	1829			
Pencil cave			1829	1834			
Big Lime			1834	1911			
Big Injun			1911	2002	gas	1915 1940	
Squaw			2006	2025			
Total depth				2044			

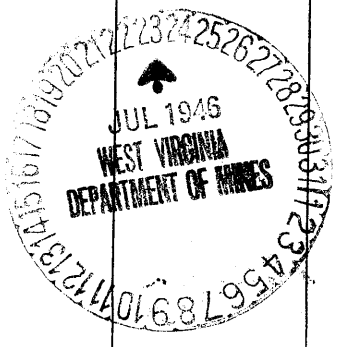

Formation	Color	Hard or Soft	Top	Bottom	Oil, Gas or Water	Depth Found	Remarks

Date July 22, 1946, 194__

APPROVED Hope Natural Gas Company., Owner

By *[Signature]* General Superintendent.