


M

LAT. 39° 20'

Long. 80° 50'

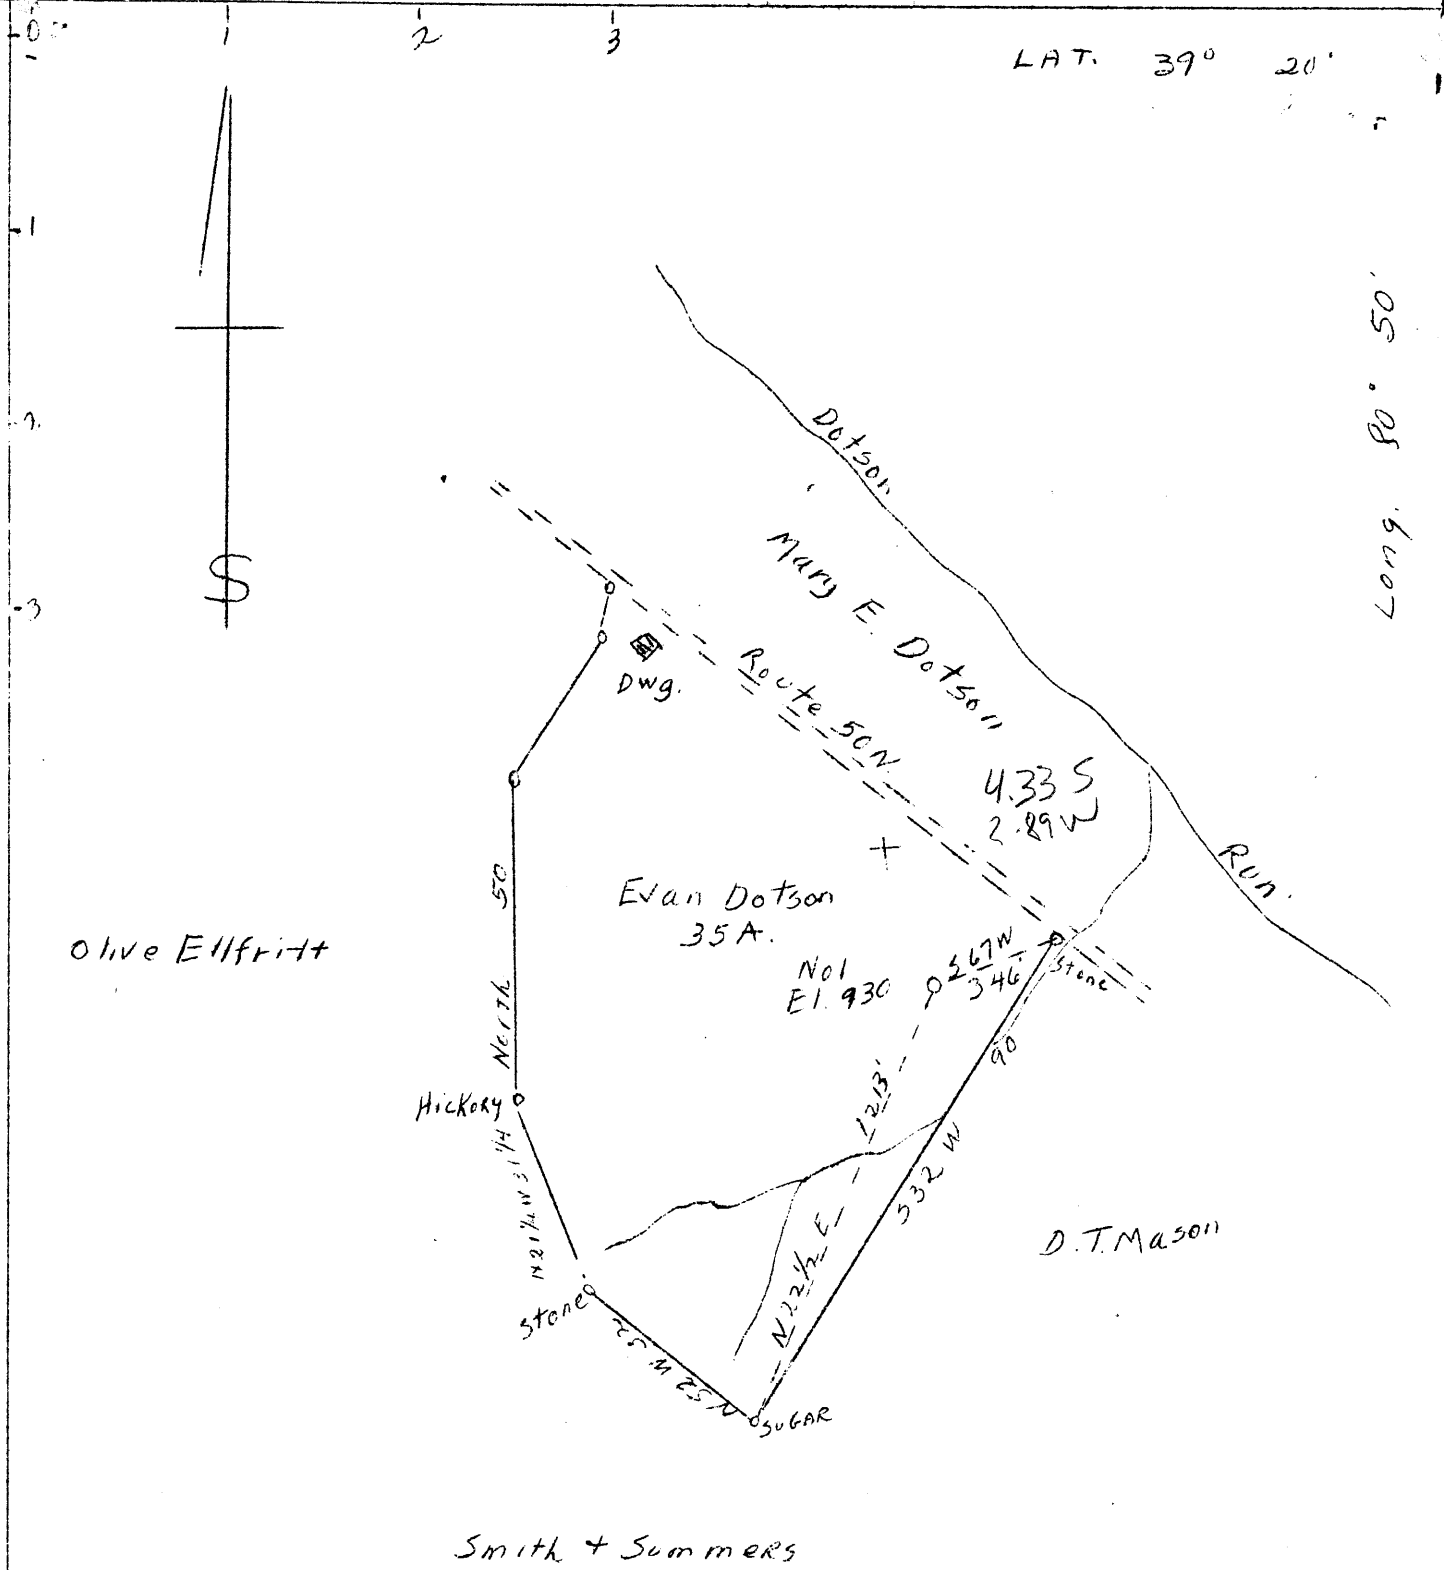

ABANDONMENT X

COMPANY TRI-STATE PIPE CO.
 ADDRESS BELLAIRE, OHIO
 FARM EVAN DOTSON
 TRACT ACRES 35 LEASE NO.
 WELL (FARM) NO. 1 SERIAL NO. _____
 ELEVATION (SPIRIT LEVEL) 930
 QUADRANGLE WEST UNION
 COUNTY DODDRIDGE DISTRICT CENTRAL
 ENGINEER A. K. WESTFALL
 ENGINEER'S REG. NO. _____
 FILE NO. _____ DRAWING NO. _____
 DATE 8/9/45 SCALE 1" 30 P

STATE OF WEST VIRGINIA
 DEPARTMENT OF MINES
 OIL AND GAS DIVISION
 CHARLESTON
 WELL LOCATION MAP
 FILE NO. DOD - 526-A

"X" DENOTES LOCATION OF WELL ON U.S. TOPOGRAPHIC MAPS, SCALE 1 TO 62,500 LATITUDE AND LONGITUDE LINES BEING REPRESENTED BY BORDER LINES AS SHOWN.
 - DENOTES ONE INCH SPACES ON BORDER LINE OF ORIGINAL TRACING.



428

STATE OF WEST VIRGINIA
DEPARTMENT OF MINES
OIL AND GAS DIVISION

WELL RECORD

Permit No. DOD-526-A

Oil or Gas Well OIL
(KIND)

Company The Tri-State Pipe Company
Address Bellaire, Ohio
Farm Evan Dotson Acres 35
Location (waters).....
Well No. 1 Elev. 930
District Central County Doddridge
The surface of tract is owned in fee by.....
Address.....
Mineral rights are owned by.....
Address.....
Drilling commenced.....
Drilling completed.....
Date Shot From To
With.....
Open Flow /10ths Water in..... Inch
/10ths Merc. in..... Inch
Volume..... Cu. Ft.
Rock Pressure..... lbs..... hrs.
Oil..... bbls., 1st 24 hrs.
Fresh water..... feet..... feet
Salt water..... feet..... feet

Casing and Tubing	Used in Drilling	Left in Well	Packers
Size			
16			Kind of Packer
18			
10		Pulled	Size of
8 1/4		"	
6		1837	Depth set
5 3/16			
3			Perf. top
2			Perf. bottom
Liners Used			Perf. top
			Perf. bottom

CASING CEMENTED..... SIZE..... No. Ft..... Date.....
COAL WAS ENCOUNTERED AT..... FEET..... INCHES
..... FEET..... INCHES..... FEET..... INCHES
..... FEET..... INCHES..... FEET..... INCHES

Formation	Color	Hard or Soft	Top	Bottom	Oil, Gas or Water	Depth Found	Remarks
Sand			130	145			
Sand			225	250			
Sand			295	315			
Hurry-Up sand			490	500			
Lime			585	610			
Sand			870	910			
Little Dunkard			950	980			
Big Dunkard			1075	1150			
1st salt sand			1400	1445			
Maxton sand			1765	1775			
Little Lime			1775	1814			
Pencil cave			1814	1819			
Big Lime			1819	1882			
Injun Sand			1882	1954			
Slate			1954	1975			
Total Depth				1975			