

Surface: Ernest Knight. West Union (Star Route) W.Va.

Coal : Martha J. Smith Hrs.

Address. Claude F. Smith. Vice President, Marshall Co. Bank.
Moundsville W.Va.

New Location
Drill Deeper
Abandonment X

Map N37

SA-5 W 5-6

Company Road Supply Co.
Address Salem W.Va.
Farm Martha J. Smith
Tract _____ Acres 240 Lease No. _____
Well (Farm) No. 13 Serial No. _____
Elevation (Spirit Level) Floor 858.44
Ground 855.34
Quadrangle Centerpoint
County Doddridge District McClellan
Engineer E. C. Tabler
Engineer's Registration No. _____
File No. _____ Drawing No. _____
Date Aug 6th 1946 Scale 1" = 800 Feet.

STATE OF WEST VIRGINIA
DEPARTMENT OF MINES
OIL AND GAS DIVISION
CHARLESTON

WELL LOCATION MAP
FILE NO. DOD-535-A

+ Denotes location of well on United States Topographic Maps, scale 1 to 62,500. latitude and longitude lines being represented by border lines as shown.

- Denotes one inch spaces on border line of original tracing.



STATE OF WEST VIRGINIA
DEPARTMENT OF MINES
OIL AND GAS DIVISION

448

Permit No. DOD-535-A

WELL RECORD

Oil or Gas Well _____ (KIND)


Company Road Supply Company
 Address 184 East Main St., Salem, W. Va.
 Farm Martha J. Smith Acres 240
 Location (waters) _____
 Well No. 13 Elev. 855.34
 District McClelland County Doddridge
 The surface of tract is owned in fee by Ernest Knight
Star Route Address West Union, W. Va.
 Mineral rights are owned by Martha J. Smith Hrs.
Claude F. Smith Address Vice President,
Marshall Co. Bank
 Drilling commenced _____ Moundsville, W. Va.
 Drilling completed _____
 Date Shot 5/1/40 From 1935 To _____
 With 20 Qts.
 Open Flow _____ /10ths Water in _____ Inch
 _____ /10ths Merc. in _____ Inch
 Volume _____ Cu. Ft.
 Rock Pressure _____ lbs. _____ hrs.
 Oil _____ bbls., 1st 24 hrs.
 Fresh water _____ feet _____ feet
 Salt water _____ feet _____ feet

Casing and Tubing	Used in Drilling	Left in Well	Packers
Size			
16			Kind of Packer
13			
10	<u>269'</u>	<u>269'</u>	Size of
8 1/4			
6 5/8	<u>1911'</u>	<u>1911'</u>	Depth set
5 3/16	<u>1919'</u>	<u>1919'</u>	
3			Perf. top
	<u>2035'</u>	<u>2035'</u>	Perf. bottom
Liners Used			Perf. top
			Perf. bottom

CASING CEMENTED _____ SIZE _____ No. Ft. _____ Dat _____

COAL WAS ENCOUNTERED AT 580 FEET 24 INCHES
 _____ FEET _____ INCHES FEET _____ INCHES
 _____ FEET _____ INCHES FEET _____ INCHES

Formation	Color	Hard or Soft	Top	Bottom	Oil, Gas or Water	Depth Found	Remarks
Pittsburgh Coal			578	580			
Big Lime Sand			1876	1928			
Big Injun Sand			1928	<u>2115</u>			
Oil and Gas			1935	1940			
Pay			2018				
Total Depth				<u>2039</u>			

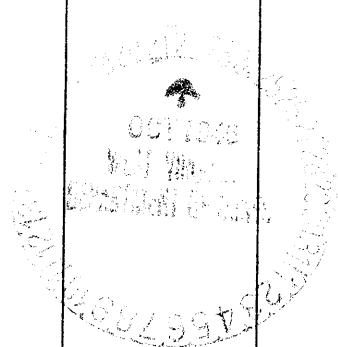

Formation	Color	Hard or Soft	Top	Bottom	Oil, Gas or Water	Depth Found	Remarks

Date October 21, 194

APPROVED RAAD SUPPLY COMPANY, Owner

By J. M. Rand - Manager, Owner
(Title)

