


Scale 1" = 400 Feet

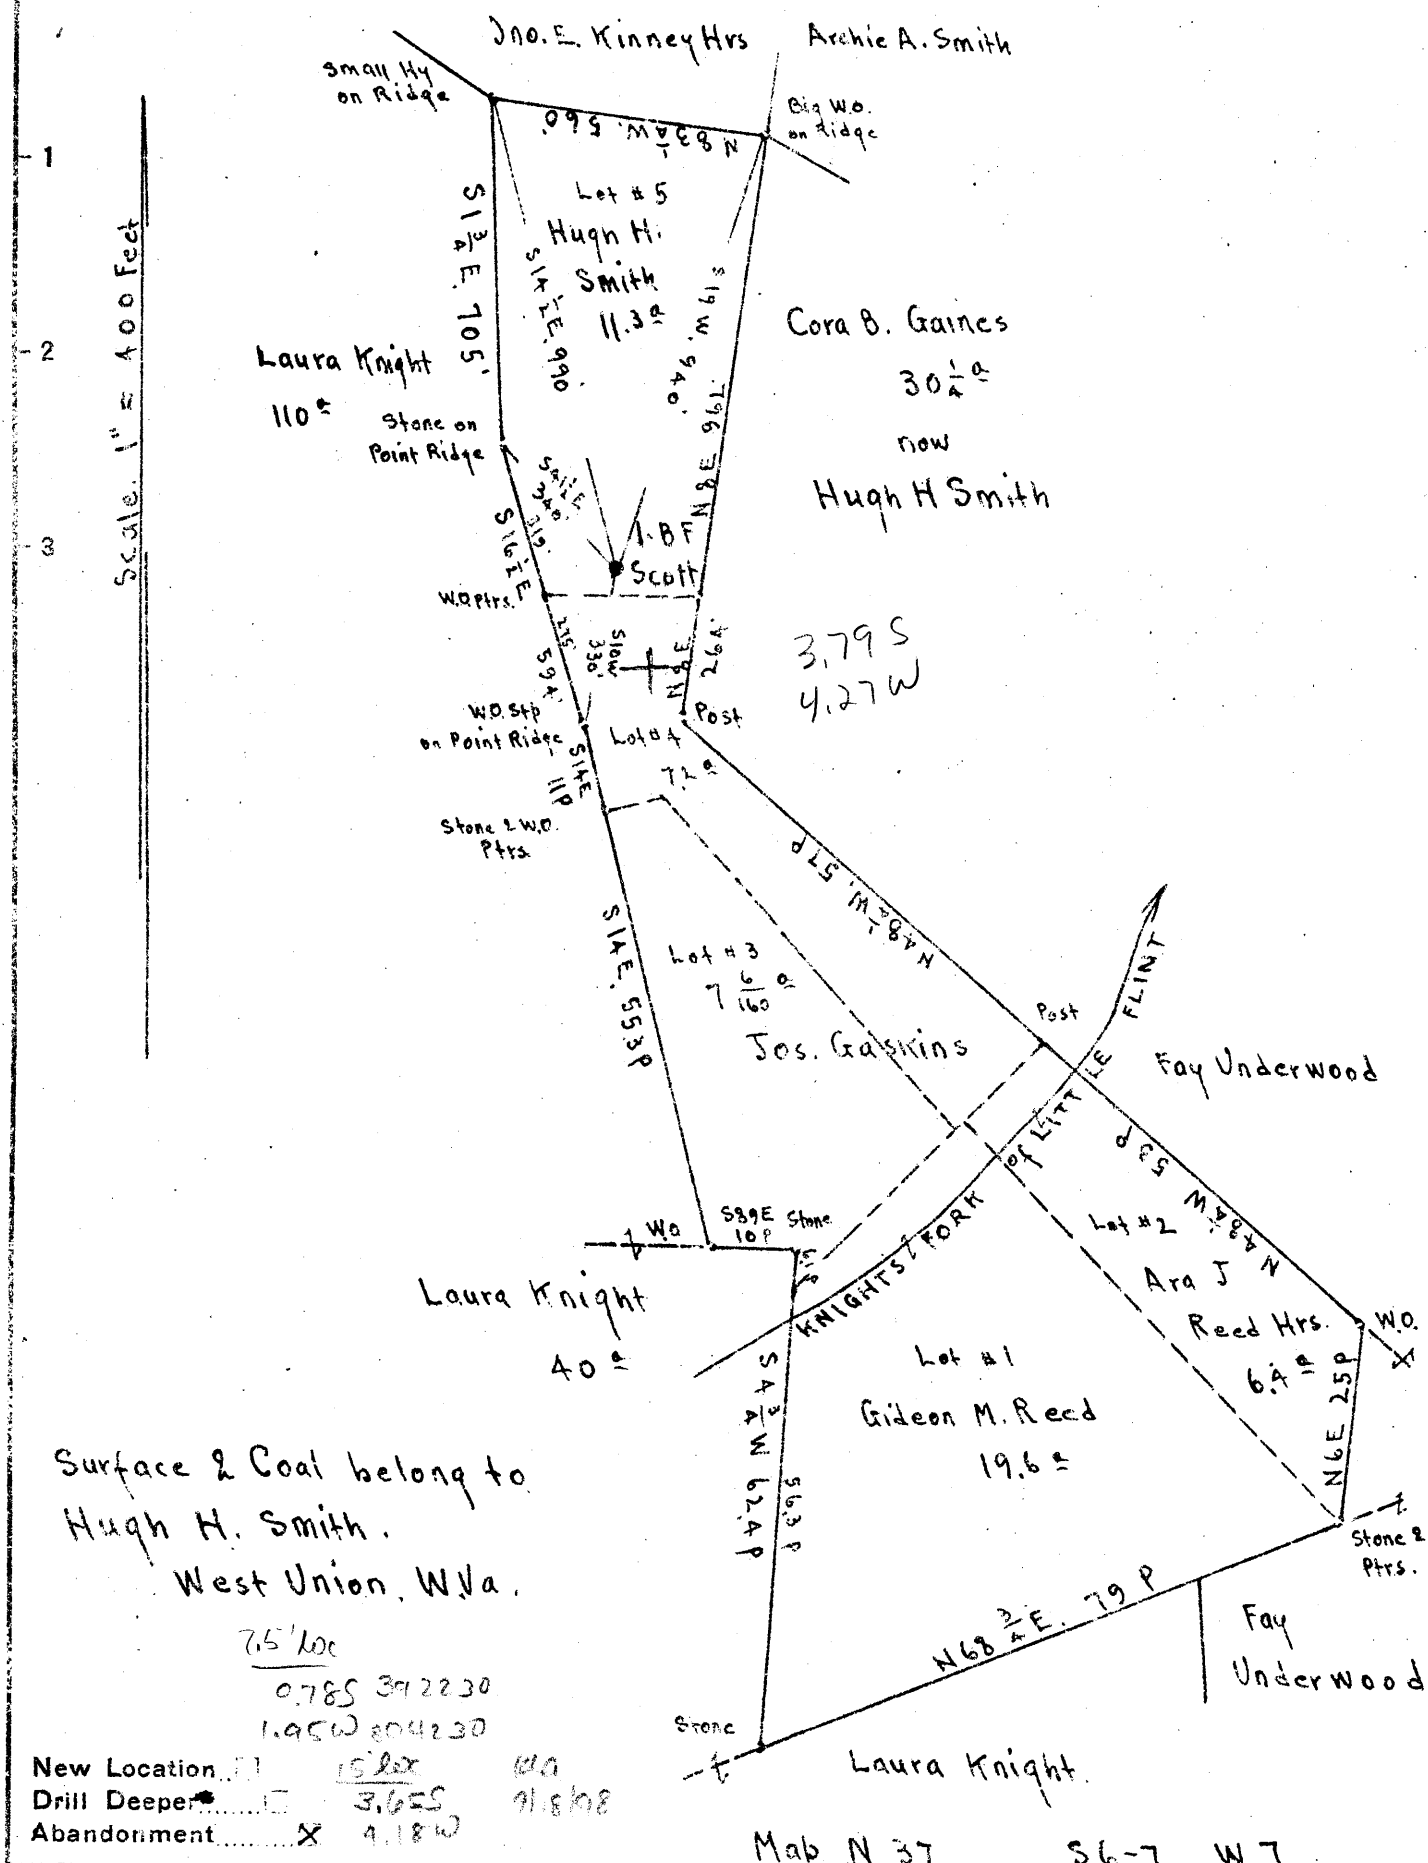

Surface & Coal belong to
Hugh H. Smith.
West Union, W.Va.

7.5' loc
0.785 392230
1.95W 804230

New Location 15' loc 100
Drill Deeper 3.625 91808
Abandonment 4.18W

Map N 37 56-7 W 7

Company Road Supply Co.
 Address Salem, W.Va.
 Farm B.F. Scott
 Tract _____ Acres 52 Lease No. _____
 Well (Farm) No. 1 Serial No. _____
 Elevation (Spirit Level) Floor 1117.78
 Ground 1115.68
 Quadrangle Centerpoint
 County Doddridge District Grant
 Engineer E.C. Tabler
 Engineer's Registration No. _____
 File No. _____ Drawing No. _____
 Date August 7th 1946 Scale 1" = 400 Feet

STATE OF WEST VIRGINIA
 DEPARTMENT OF MINES
 OIL AND GAS DIVISION
 CHARLESTON

WELL LOCATION MAP
 FILE NO. DOD-537-A

W0237 92965
 + Denotes location of well on United States Topographic Maps, scale 1 to 62,500, latitude and longitude lines being represented by border lines as shown.

- Denotes one inch spaces on border line of original tracing.



STATE OF WEST VIRGINIA
DEPARTMENT OF MINES
OIL AND GAS DIVISION

443

WELL RECORD

AP 537A (sup. no. 1)

Permit No. 537A

Oil or Gas Well Oil (KIND)


Company Read Supply Company
Address 184 East Main St., Salem, W. Va.
Farm B. F. Scott Acres 11.3
Location (waters) _____
Well No. 1 Elev. 1115.68
District Grant County Doddridge
The surface of tract is owned in fee by Hugh H. Smith
Address West Union, W. Va.
Mineral rights are owned by Hugh H. Smith
Address West Union, W. Va.
Drilling commenced _____
Drilling completed _____
Date Shot 12/31/07 From 2240 To _____
With 60 Qts.
Open Flow _____ /10ths Water in _____ Inch
_____ /10ths Merc. in _____ Inch
Volume _____ Cu. Ft.
Rock Pressure _____ lbs. _____ hrs.
Oil _____ bbls., 1st 24 hrs.
Fresh water _____ feet
Salt water _____ feet

Casing and Tubing	Used in Drilling	Left in Well	Packers
Size			
16			Kind of Packer
13			
10			Size of
8 1/4	1400'	None	
6 3/4	2159'	2159'	Depth set
5 3/16	1304'	1304'	
3			Perf. top
2	2260'	2260'	Perf. bottom
Liners Used			Perf. top
			Perf. bottom

CASING CEMENTED _____ SIZE _____ No. Ft. _____ Dat _____
COAL WAS ENCOUNTERED AT 800 FEET _____ INCHES
_____ FEET _____ INCHES FEET _____ INCHES
_____ FEET _____ INCHES FEET _____ INCHES

Formation	Color	Hard or Soft	Top	Bottom	Oil, Gas or Water	Depth Found	Remarks
Pittsburgh	Coal		800				
Big Injun	Sand		2160				
Oil Show			2238		Oil		
Pay			2243				
Total Depth				2264			

Ⓞ

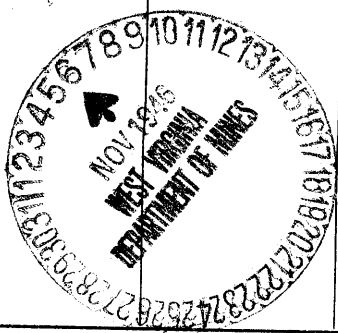

Formation	Color	Hard or Soft	Top	Bottom	Oil, Gas or Water	Depth Found	Remarks

Date November 4, 1946

APPROVED Road Supply Co., Owner

By J. M. Road, mg. owner
(Title)

