


Latitude 39° 30'

Longitude 80° 40'

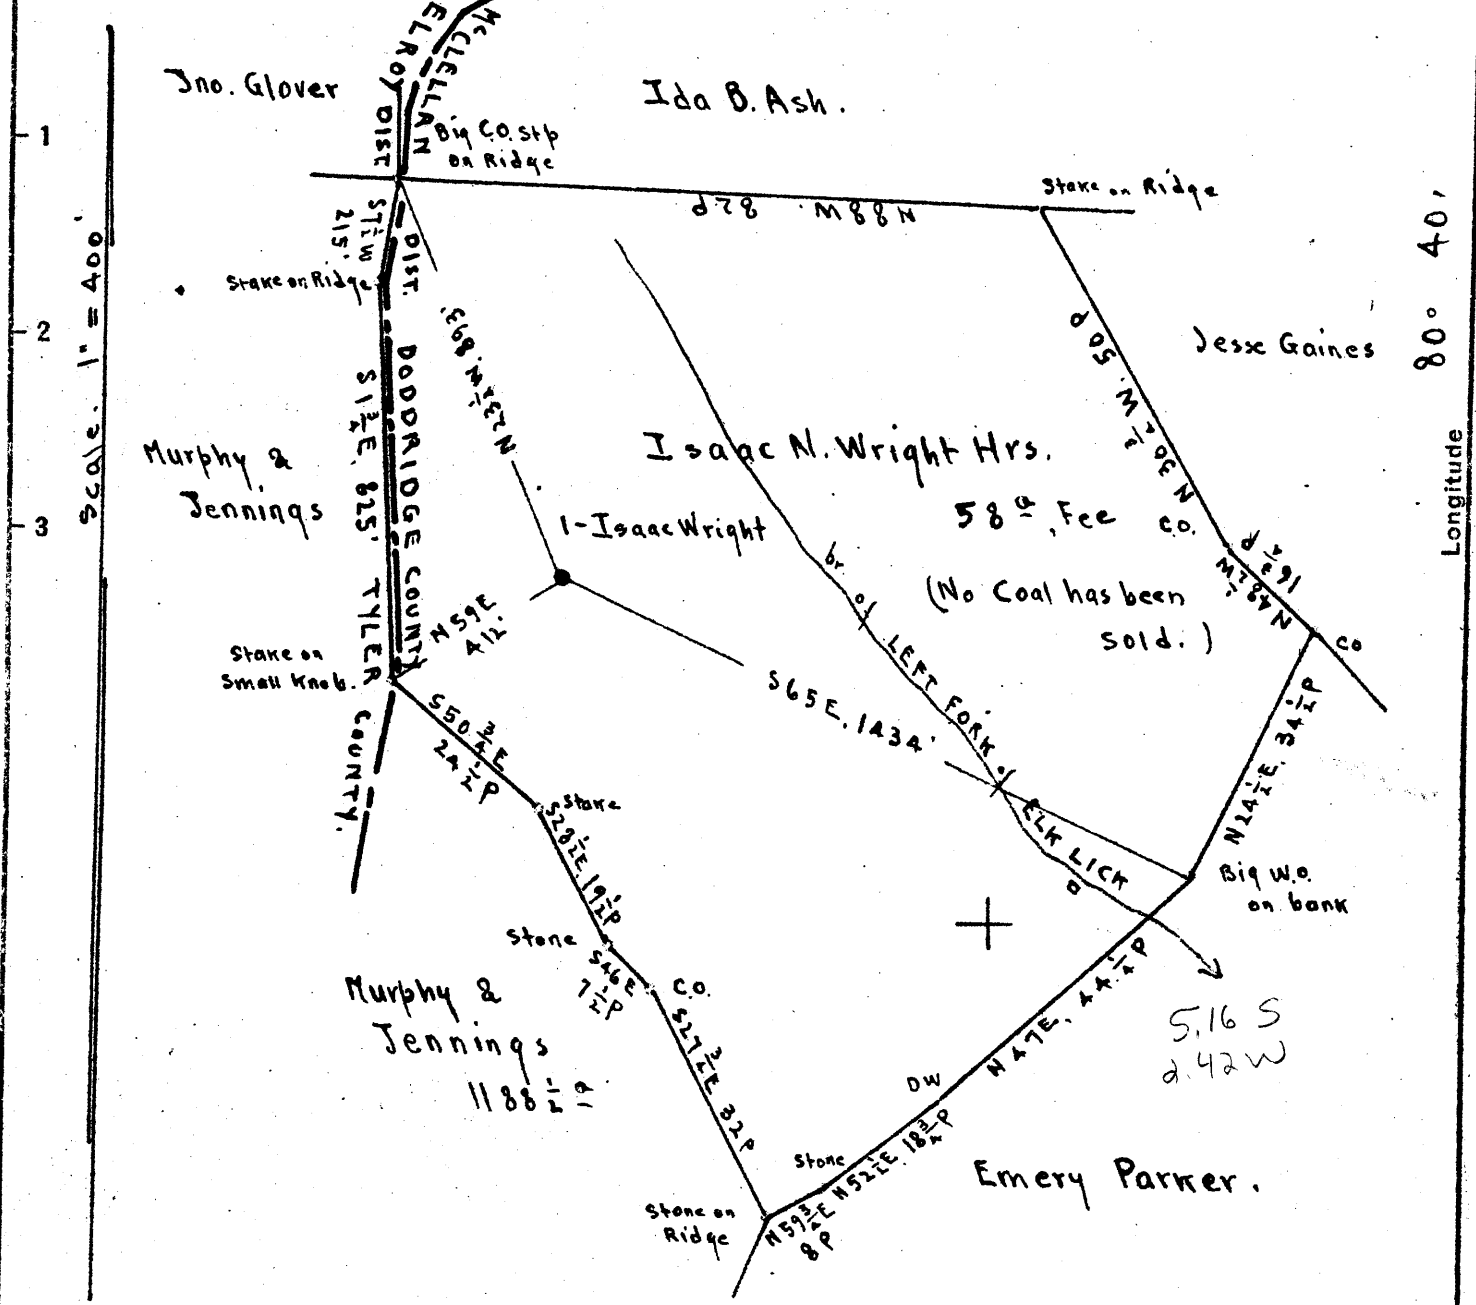

Surface & Coal, Isaac N. Wright Hrs.
 Address: Claude Wright,
 # 1217 Philippi Pike,
 Clarksburg, W.Va.

New Location
 Drill Deeper
 Abandonment

Map N47 Squares 2 S, 5 W

Company Road Supply Co.
 Address Salem, W.Va.
 Farm Isaac Wright
 Tract Acres 58 Lease No. _____
 Well (Farm) No. 1 Serial No. _____
 Elevation (Spirit Level) Floor 1176.73
 Ground 1177.13
 Quadrangle Centerpoint
 County Doddridge District McClellan
 Engineer EC Tabler
 Engineer's Registration No. _____
 File No. _____ Drawing No. _____
 Date Aug. 29th, 1945 Scale 1" = 400'

STATE OF WEST VIRGINIA
 DEPARTMENT OF MINES
 OIL AND GAS DIVISION
 CHARLESTON

WELL LOCATION MAP
 FILE NO. DOD-568-A

+ Denotes location of well on United States Topographic Maps, scale 1 to 62,500, latitude and longitude lines being represented by border lines as shown.

- Denotes one inch spaces on border line of original tracing.



465

STATE OF WEST VIRGINIA
DEPARTMENT OF MINES
OIL AND GAS DIVISION

WELL RECORD

Permit No. Ab 168-A



Oil or Gas Well _____ (KIND)

Company Reed Supply Company
 Address 184 E. Main St., Salem, W. Va.
 Farm Isaac Wright Acres 58
 Location (waters) _____
 Well No. 1 Elev. 1177.13
 District McClellan County Doddridge
 The surface of tract is owned in fee by Isaac N. Wright
 Hrs. Address: Claude Wright
 Mineral rights are owned by 1217 Phillippi Pk
Clarksburg, W. Va.
 Address Same owner as surface.
 Drilling commenced _____
 Drilling completed Not given
 Date Shot Not given From _____ To _____
 With _____
 Open Flow _____ /10ths Water in _____ Inch
 _____ /10ths Merc. in _____ Inch
 Volume _____ Cu. Ft.
 Rock Pressure _____ lbs. _____ hrs.
 Oil _____ bbls., 1st 24 hrs.
 Fresh water _____ feet _____ feet
 Salt water _____ feet _____ feet

Casing and Tubing	Used in Drilling	Left in Well	Packers
Size			
16			Kind of Packer
13			
10	✓	398'	398'
8 1/4	✓	1292'	1292'
6 5/8	✓	1842'	1842'
5 3/16		2118'	2118'
3 1/2		1065'	1065'
2		2340'	2340'
Liners Used			
			Perf. top
			Perf. bottom
			Perf. top
			Perf. bottom

CASING CEMENTED No SIZE _____ No. Ft. _____ Date _____
 COAL WAS ENCOUNTERED AT Not given INCHES
 _____ FEET _____ INCHES FEET _____ INCHES
 _____ FEET _____ INCHES FEET _____ INCHES

Formation	Color	Hard or Soft	Top	Bottom	Oil, Gas or Water	Depth Found	Remarks
Pittsburgh	Coal		Not Given				
Big Injun			2200'				
1st. Pay			2325'				
Total Depth				2340'			

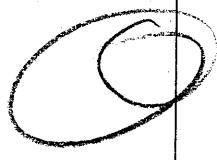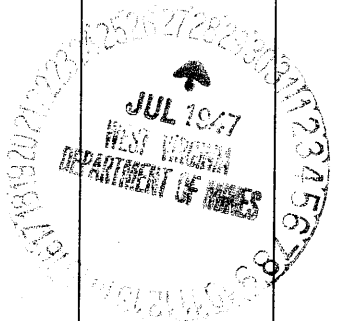

Formation	Color	Hard or Soft	Top	Bottom	Oil, Gas or Water	Depth Found	Remarks

Date July 24, 1947

APPROVED Road Supply Co., Owner

By J. M. Reed
(Title) sgm.