

New Location
 Drill Deeper
 Abandonment

Map Sh 54 S 8 E 2 F.B. 548 P 3132 & 766 P 39

Company	Hope Natural Gas Co
Address	Clarksburg, W.Va.
Farm	H.I. Riffie
Tract	Acres 57 Lease No. 3431
Well (Farm) No.	Serial No. 6625
Elevation (Spirit Level)	1134'
Quadrangle	Centerpoint
County	Doddridge District McClellan
Engineer	W.M. Bowers
Engineer's Registration No.	900
File No.	Drawing No.
Date	8-11-47 Scale 1" = 40 P

STATE OF WEST VIRGINIA
 DEPARTMENT OF MINES
 OIL AND GAS DIVISION
 CHARLESTON

WELL LOCATION MAP
 FILE NO. DOD-572-A

+ Denotes location of well on United States Topographic Maps, scale 1 to 62,500, latitude and longitude lines being represented by border lines as shown.

- Denotes one inch spaces on border line of original tracing.

72291 on CNG map



469

STATE OF WEST VIRGINIA
DEPARTMENT OF MINES
OIL AND GAS DIVISION

WELL RECORD

Permit No. 572A


~~Oil~~ or Gas Well _____ (KIND)

Company Hope Natural Gas Company
 Address 445 West Main St. Clarksburg, W.Va.
 Farm H.I. Riffe Acres 57
 Location (waters) _____
 Well No. 6825 Elev. 1134
 District McClellan County Doddridge
 The surface of tract is owned in fee by _____
 Address _____
 Mineral rights are owned by _____
 Address _____
 Drilling commenced October 13, 1926
 Drilling completed December 10, 1926
 Date Shot _____ From _____ To _____
 With _____
 Open Flow _____ /10ths Water in _____ Inch
 _____ /10ths Merc. in _____ Inch
 Volume _____ Cu. Ft.
 Rock Pressure _____ lbs. _____ hrs.
 Oil _____ bbls., 1st 24 hrs.
 Fresh water _____ feet _____ feet
 Salt water 1769 feet _____ feet

Casing and Tubing	Used in Drilling	Left in Well	Packers
Size			
16			Kind of Packer _____
13			
10	498	171	Size of _____
8 1/4	1416	1416	
6 3/4	2167	2167	Depth set _____
5 3/16			
3			Perf. top _____
2	3066	Pulled	Perf. bottom _____
Liners Used _____			Perf. top _____
			Perf. bottom _____

CASING CEMENTED _____ SIZE _____ No. Ft. _____ Date _____
 COAL WAS ENCOUNTERED AT 870 FEET 96 INCHES
 _____ FEET _____ INCHES _____ FEET _____ INCHES
 _____ FEET _____ INCHES _____ FEET _____ INCHES

Formation	Color	Hard or Soft	Top	Bottom	Oil, Gas or Water	Depth Found	Remarks
Pittsburgh Coal			870	878			
Little Dunkard			1200	1312			
Big Dunkard			1398	1425			
First Salt			1610	1650			
Second Salt			1670	1710			
Third Salt			1730	1800	water	1769	
Little Lime			2099	2107			
Pencil cave			2107	2126			
Big Lime			2126	2180			
Big Injun			2180	2296	gas	2249	
Gantz			2420	2581			
Fifty foot			2747	2778	show gas	2768	
Gordon Stray			2927	2955	gas	2928 2941	
Total depth				3036			

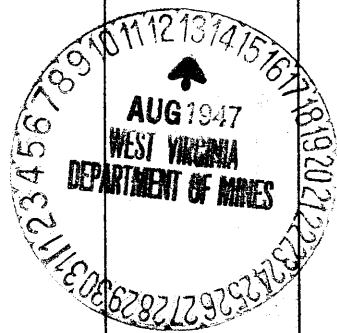

Formation	Color	Hard or Soft	Top	Bottom	Oil, Gas or Water	Depth Found	Remarks

Date August 11, 1947, 19__

APPROVED Hope Natural Gas Company., Owner

By _____ (Title)

(Signature)