

Surface: Jno. T. Pratt, R.F.D #1, Morgansville, Doddridge Co., W. Va.

Pittsburgh Coal: Formerly "Melania Coal Co." Sold to State of W. Va. for taxes in 1933. Title still in State of West Virginia.

New Location
 Drill Deeper
 Abandonment

S 5 E 3-A

Company Road Supply Co.
 Address Salem, W. Va.
 Farm J.R. Roberts
 Tract Acres 52 Lease No. _____
 Well (Farm) No. 3 Serial No. _____
 Elevation (Spirit Level) Floor - 824.30
Ground - 824.30
 Quadrangle CENTER POINT
 County Doddridge District McClellan
 Engineer E.C. Tabler
 Engineer's Registration No. _____
 File No. _____ Drawing No. _____
 Date Nov 5th 1947 Scale 1" = 400 Feet

STATE OF WEST VIRGINIA
 DEPARTMENT OF MINES
 OIL AND GAS DIVISION
 CHARLESTON

WELL LOCATION MAP
 FILE NO. DOD-583-A

+ Denotes location of well on United States Topographic Maps, scale 1 to 62,500, latitude and longitude lines being represented by border lines as shown.

- Denotes one inch spaces on border line of original tracing.



STATE OF WEST VIRGINIA
DEPARTMENT OF MINES
OIL AND GAS DIVISION

Y92

WELL RECORD

Permit No. 583-A

Oil or Gas Well (X)
(KING)

Company Road Supply Company
Address 184 East Main St., Salem, W. Va.
Farm J. R. Roberts Acres 52
Location (waters) Riggins Run
Well No. 3 Elev. 824.30
District McClellan County Doddridge
The surface of tract is owned in fee by John T. Pratt
R. F. D. #1 Address Morgansville
Mineral rights are owned by STATE OF W. VA.
Address _____
Drilling commenced _____
Drilling completed NO RECORD
Date Shot _____ From _____ To _____
With _____


Casing and Tubing	Used in Drilling	Left in Well	Packers
Size			
16			Kind of Packer
13			
10			Size of
8 1/4			
6	1800'	1800'	Depth set
5 3/16			
3			Perf. top
2	2635'	2635'	Perf. bottom
Liners Used			Perf. top
			Perf. bottom

CASING CEMENTED No. _____ SIZE _____ No. Ft. _____ Da _____

COAL WAS ENCOUNTERED AT 578 FEET 60 INCHES
FEET INCHES FEET INCHES
FEET INCHES FEET INCHES

Open Flow /10ths Water in _____ Inch
/10ths Merc. in _____ Inch
Volume _____ Cu. Ft.
Rock Pressure _____ lbs. _____ hrs.
Oil _____ bbls., 1st 24 hrs.
Fresh water _____ feet _____ feet
Salt water _____ feet _____ feet

Formation	Color	Hard or Soft	Top	Bottom	Oil, Gas or Water	Depth Found	Remarks
Pittsburgh Coal			578'	583'			
Dunkard Sand			1065'	1085'			
Big Injun Sand			1850'	1955'			
Gordon Sand			2600'	2625'			
Total Depth				2635'			

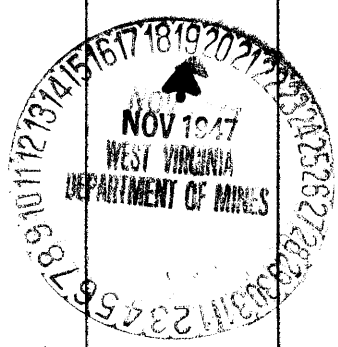

Formation	Color	Hard or Soft	Top	Bottom	Oil, Gas or Water	Depth Found	Remarks

Date Nov. 18, 1947

APPROVED Road Supply Co., Owner

By J. M. Road, Mgr. Owner
 sm. (Title)