

Mrs. Smith, 200 1/2

1	4.19 S	4.18 W
3	3.61 S	4.37 W
4	4.04 S	4.02 W
6	4.05 S	4.32 W

Pittsburgh Coal & Surface, 1 & 4 Albert Percy  
 E. Porter Bode, RFD #1, Blandville, Doddridge Co. W. Va.  
 Pittsburgh Coal, 3 & 6 Albert Percy; New Milton, Doddridge Co. W. Va.  
 Surface, 3 Albert Percy; Paul W. Clevenger, RFD #1, Blandville, Dodd. Co. W. Va.  
 Surface, 6 Albert Percy; Mr. Fay Barnett, RFD #1, Blandville, Doddridge Co. W. Va.

Abandonment

Company The Tri-State Pipe Co.  
 Address Bellaire, Ohio  
 Farm Albert Percy  
 Tract Acres 375' Lease No.  
 Well (Farm) No. 1, 3, 4 & 6 Serial No. 6  
 Elevation (Spirit Level) 6 feet above Ground - 1196.39  
 Quadrangle VADIS  
 County Doddridge District New Milton  
 Engineer E. C. Tabler  
 Engineer's Registration No. \_\_\_\_\_  
 File No. \_\_\_\_\_ Drawing No. \_\_\_\_\_  
 Date Dec. 19<sup>th</sup> & 20<sup>th</sup> 1947 Scale 1" = 800'

STATE OF WEST VIRGINIA  
 Department of Mines  
 OIL & GAS DIVISION  
 Charleston

WELL LOCATION MAP  
 File No. ~~DOD - 591-A-#1~~  
~~DOD - 592-A-#3~~  
~~DOD - 593-A-#4~~  
 DOD - 594-A-#6

+ Denotes location of well on U.S. Topographic Maps, scale 1 to 62,500, latitude & longitude lines being represented by border lines as shown.  
 - Denotes one inch spaces on border line of original tracing.

06-10-1917



490

STATE OF WEST VIRGINIA  
DEPARTMENT OF MINES  
OIL AND GAS DIVISION

WELL RECORD

Permit No. 174-A

Oil or Gas Well (X) (KIND)


Company The Tri-State Pipe Company  
Address Bellaire, Ohio  
Farm Albert Percy Heirs Acres           
Location (waters)           
Well No. 6 Elev. 1176.5  
District New Milton County Doddridge  
The surface of tract is owned in fee by           
         Address           
Mineral rights are owned by           
         Address           
Drilling commenced           
Drilling completed 9-29-18  
Date Shot          From          To           
With         

Casing and Tubing	Used in Drilling	Left in Well	Packers
Size			Kind of Packer
16			
13			
10			Size of
8 1/4			
6 1/2	1954'	1954'	Depth set
5 3/16	2255'	2255'	
3			Perf. top
2	2746'	2746'	Perf. bottom
Liners Used			Perf. top
			Perf. bottom

Open Flow /10ths Water in          Inch  
/10ths Merc. in          Inch  
Volume          Cu. Ft.  
Rock Pressure          lbs          hrs.  
Oil          bbls., 1st 24 hrs.  
Fresh water          feet          feet  
Salt water          feet          feet

CASING CEMENTED          SIZE          No. Ft.          Da           
COAL WAS ENCOUNTERED AT          FEET          INCHES  
         FEET          INCHES          FEET          INCHES  
         FEET          INCHES          FEET          INCHES

Formation	Color	Hard or Soft	Top	Bottom	Oil, Gas or Water	Depth Found	Remarks
Big Dunkard			1060	1220			
Pencil Cave			2032	2035			
Big Lime			2035'	2100			
Big Injun			2100	2135			
Gordon Sand			2731	2735			
Oil			2733		oil		
Total Depth				2746			

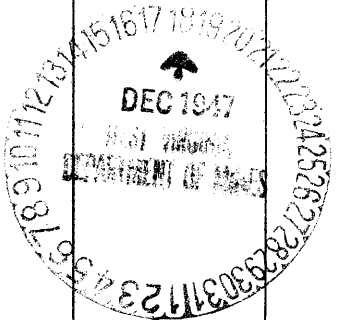

Formation	Color	Hard or Soft	Top	Bottom	Oil, Gas or Water	Depth Found	Remarks

Date December 16, 194 7

APPROVED The Tri-State Pipe Co., Owner

By J. M. Raad, Contractor  
 By J. M. Raad (Title) Contractor, Inc.